



12121 PHILIPS HWY, JACKSONVILLE, FL 32256


ISSUED FOR BID

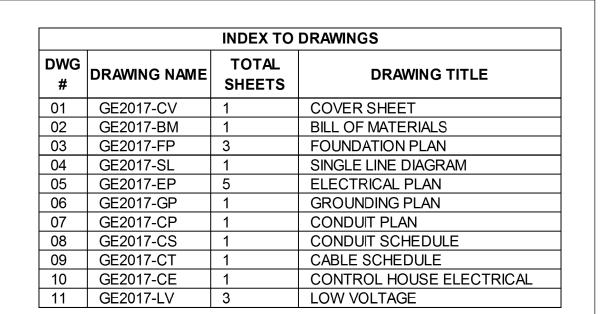

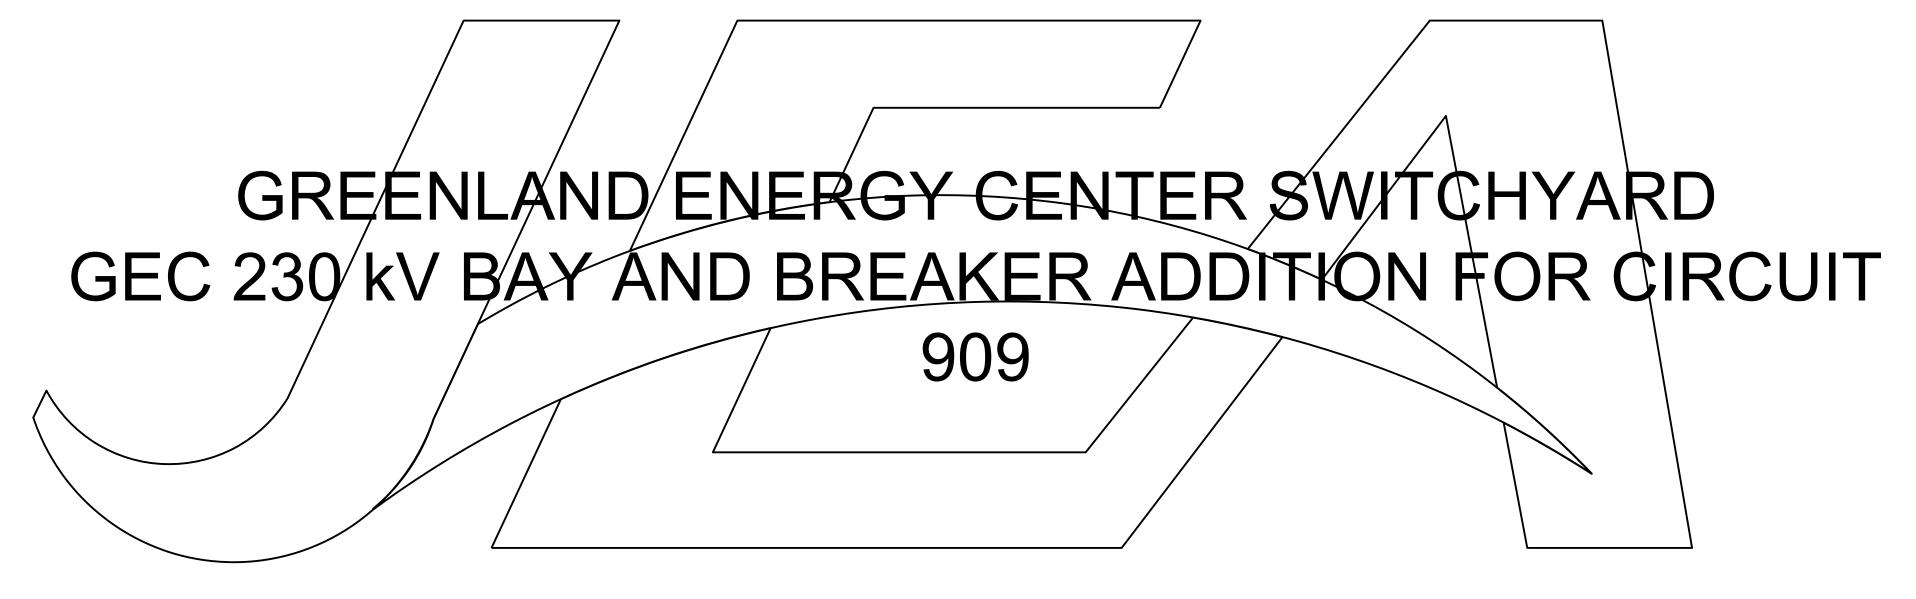

BUILDING COMMUNITY

SUBSTATION & TRANSMISSION ENGINEERING PROJECT # 8004817

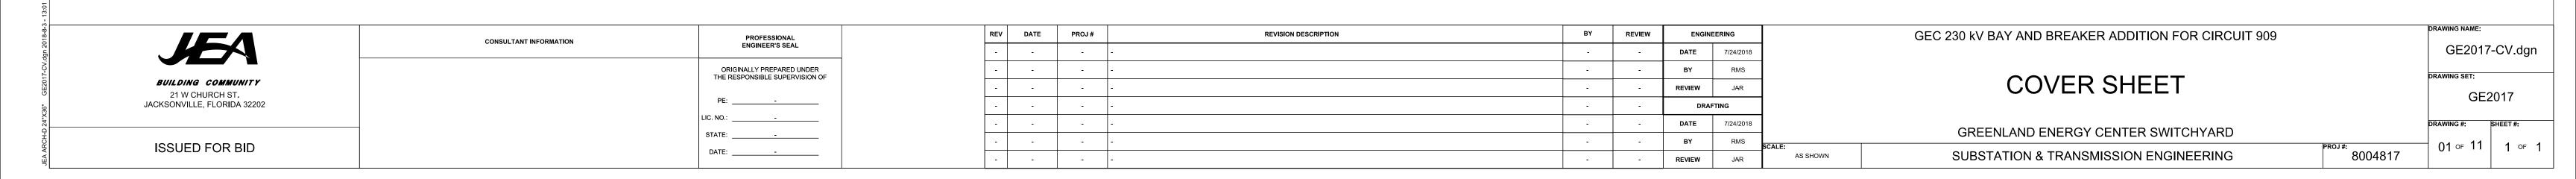

BILL OF MATERIALS

ITEM #	QTY	UNIT	DESCRIPTION	MANUFACTURER	PART#	FURNISHED BY	COMMENTS	PO#
A 1	2	EA	230KV "A FRAME DEADEND STRUCTURE, 1 BAY, 60'-0" CONDUCTOR PULL-OFF HEIGHT, APPX WT = 40,319 LBS EA	DISTRAN		DIS-TRAN		171222
4 3	2	EA	230KV LOW BUS SUPPORT STAND, 3 PHASE, 20'-0" BUS HEIGHT,	DISTRAN		DIS-TRAN		171222
44	4	EA	STRUCTURE HEIGHT 12'-11½", APPX WT = 2,693 LBS EA 230KV SWITCH STAND, 3 PHASE, 20'-0" BUS HEIGHT, APPX WT = 4,421 LBS EA	DISTRAN		DIS-TRAN		171222
4 7	3	EA	230KV POTENTIAL TRANSFORMER STAND, SINGLE PHASE, 7'-6"	DISTRAN		DIS-TRAN		171222
			STRUCTURE HEIGHT, APPX WT = 724 LBS EA 230KV LIGHTING ARRESTER STAND, THREE PHASE, 8'-6"	DIOTRAN		DIO TDAN		474000
8	6	EA	STRUCTURE HEIGHT, APPXWT = 2,100 LBS EA	DISTRAN		DIS-TRAN		171222
\9 \10	4 LOT	EA -	GROUND PLATFORM, GALVANIZED, 1"X3'X4' GALVANIZED EQUIPMENT MTG. BOLTS, NUTS, & WASHERS	P&R METALS T.F.		DIS-TRAN DIS-TRAN		171222 171222
\11	LOT	-	ANCHOR BOLTS, COMPLETE WITH (2) NUTS AND (2) FLATWASHERS	T.F.		DIS-TRAN		171222
			INCLUDES CAGES FOR STRUCTURE A1 230KV, 2000 AMP, 900KV BIL, 3 PHASE GROUP OPERATED					_
			VERTICAL BREAK SWITCH, COMPLETE WITH: A: ALUMINUM LIVE PARTS					
31	4	EA	B: PROVISIONS FOR TR-304 STATION POST INSULATORS	PASCOR	TTR8-AC	DIS-TRAN		171222
J 1			C: MANUAL WORM GEAR OPERATOR 30:1 RATIO D: STANDARD ARCING HORNS	ATLANTIC	1110-40	DIO-11VAN		17 1222
			E: 20'-0" BUS HEIGHT					
			F: 4 HOLE TERM PADS TIN PLATED STATION POST INSULATOR, 230KV, 900KV BIL, TR-304, GRAY					-
33	36	EA	950 # CANTILEVER STRENGTH, 5" BOLT CIRCLE	NGK-LOCKE	PS090201	DIS-TRAN		171222
			(FOR GROUP OPERATED SWITCHES) 230KV, POTENTIAL TRANSFORMER, OIL FILLED, SINGLE POLE, WOUND TYPE, 900 kV					_
			BILL					
			-MAX SYS VOLTAGE; (kV): 245 -NOM. SYS VOLTAGE: (kV): 230					
			-NOM. FREQUENCY (Hz): 60					
			-ALTITUDE- (FASL): 3300 -PFWV (kV): 460					
34	3	EA	-RATED PRIM. VOLTAGE (GY/V): 230000/138000	GE	OTEF245	DIS-TRAN		171222
<i>.</i>			-RATIO: 1200/2000:1:1 -ACCURACY/BURDEN: 0.3 WXYZ.ZZ		0121210	DIO 110111		17122
			-OVERVOLTAGE FACTOR: 1.4/1 MIN; 1.2 CONT.					
			-THERMAL BURDEN (VA): 5000 -INSULATOR TYPE: PORCELAIN					
			-CREEPAGE DISTANCE (IN/MM): 248/6300					
			-COLOR: GREY -COMPLIANCE STANDARD: IEEE C57.13-2008					
35	6	EA	STATION CLASS SURGE ARRESTER, 144 MCOV, ANSI 70, GRAY,	OHIO BRASS	EVP01440-3001	DIS-TRAN		171222
	+ +	-/ \	POLYMER STATION POST INSULATOR, EXTRA HIGH STRENGTH, 230 KV,	212 270.00	51 170-0001			
			900 KV BIL, 2750# CANTILEVER, GRAY, UNIFORM STACK					
36	12	EA	7" BOLT CIRCLE -(6) UPRIGHT	NGK-LOCKE	PE090201	DIS-TRAN		171222
			-(6) UNDERHUNG				 	
37	6	EA	BUS SUPPORT CLAMP, 4" IPS ALUM TUBING TO 7" B.C., WELDED	SEFCOR	ASWH647SE	DIS-TRAN		171222
38	6	EA	BUS SUPPORT CLAMP, 4" IPS ALUM TUBING TO 7" B.C.,	SEFCOR	WVTI647	DIS-TRAN		171222
-	+ +	\	VERTICAL TYPE, WELDED RIGID BUS PIPE, ALUMINUM, 4" DIA. NPS, SCH 40,					
			6063-T6, ASTM B241, 53% IACS CONDUCTIVITY,					
39	600	FT	3.733PLF, 25KSI YIELD STRENGTH, SUITABLE FINISH FOR HIGH VOLTAGE APPLICATION	WILLIAMS M		DIS-TRAN		171222
		• •	-(6) 20' PCS					22
			-(9) 30' PCS -(6) 35' PCS					
			954 MCM AAC, 37 STRAND, CODE NAME "MAGNOLIA"					
311	1000	FT	-(INCLUDES DAMPENING CABLE) -(390) DAMPENING	MID STATE		DIS-TRAN		171222
			-(610) JUMPER					
312	9	EA	TERMINAL, 4" IPS ALUM TUBING TO 4 HOLE PAD, 4" PAD, WELDED, CENTERFORMED	SEFCOR	WFTC-64-4B	DIS-TRAN	<u> </u>	171222
B13	15	EA	TERMINAL, 4" IPS ALUMINUM TUBING TO 4 HOLE, 4" WIDE PAD, CENTERFORMED, EXPANSION	SEFCOR	WFXTC-64-4B	DIS-TRAN		171222
316	24	EA	TEE CONNECTOR, 4" IPS ALUM TUBING TO 4" 4 HOLE PAD,	SEFCOR	WTF-6269-4B	DIS-TRAN		171222
			WELDED ALUMINUM GROUNDING STUD FOR 4" IPS ALUM TUBING,					
318	6	EA	WELDED	SEFCOR	WTS-6064	DIS-TRAN		171222
319 323	6 12	EA EA	COUPLER, 4" IPS ALUM TUBING TO 4" IPS ALUM TUBING, WELDED TERMINAL, (2) 954 MCM AAC TO 4 HOLE 4" WIDE PAD, WELDED	SEFCOR SEFCOR	WSC-6464 WFC2-34-4B	DIS-TRAN DIS-TRAN		171222 171222
323 324	12	EA	TERMINAL, (2) 954 MCM AAC TO 4 HOLE 4" WIDE PAD, WELDED,	SEFCOR	WFC2-34-4B WFC2-45-34-4B	DIS-TRAN		171222
325	24	EA	45 DEGREE CABLE SPACER, (2) 954 MCM AAC CABLES, 6" SPACING	SEFCOR	ASPC-35-6	DIS-TRAN		171222
323 326	12	EA	TERMINAL, 954 MCM AAC TO 4 HOLE PAD, 4" WIDE PAD,	SEFCOR	WFC-34-4B	DIS-TRAIN DIS-TRAIN		171222
	+-		WELDED SET OF (4) STAINLESS STEEL TERMINAL BOLTS, 2 FLAT WASHERS &					
328	LOT	-	BRONZE NUTS WITH BELLEVILLE WASHERS RATED FOR	T.F.		DIS-TRAN		171222
330	6	EA	4000# OF COMPRESSION TERMINAL, 954 AAC TO 3" 4 HOLE PAD, WELDED	SEFCOR	WFC-34-4A	DIS-TRAN		171222
341	166	EA	GROUND CLAMP, 2 PIECE, 1 CONDUCTOR,	SEFOCR	GTC-14	DIS-TRAIN DIS-TRAIN		171222
			7#5 COPPERWELD TO STEEL, TINNED GROUND CLAMP, 2 PIECE, 2 CONDUCTOR,					
342	69	EA	7#5 COPPERWELD TO STEEL, TINNED	SEFCOR	GTC2-14	DIS-TRAN		171222
343	7	EA	TERMINAL, 7#5 COPPERWELD TO 2 HOLE PAD, BOLTED 7 # 5 COPPER WELD CABLE FOR STRUCTURE GROUNDING	AEC	VL4D-41-4H	DIS-TRAN		171222
344	700	FT	40% DSA	MID STATE		DIS-TRAN		171222
345 350	6 30	EA EA	TERMINAL, 7#5 COPPERWELD TO 2 HOLE PAD, BOLTED ELECTRICAL JOINT COMPOUND	AEC AEC	VL4D-61-4H ING8	DIS-TRAN DIS-TRAN		171222 171222
			CONTROL CABLE	,		DIO-11VAIN		17.1222
			CONDUCTOR SIZE: #10 STR/B NO OF CONDUCTORS:4	JEA				
C01	4750	FT	SHIELDED	STOREROOM	CAICN016	JEA		
			REEL SIZE:NCR32.24 (PER JEA TECHNICAL SPECIFICATIONS JFX-035-09 SECTION XI)				I	
			CONTROL CABLE					+
	1		CONDUCTOR SIZE: #10 STR/B NO OF CONDUCTORS:8	JEA				
		FT	SHIELDED	STOREROOM	CAICN017	JEA		
002	450		REEL SIZE:NCR40.24 (PER JEA TECHNICAL SPECIFICATIONS JEX-035-09 SECTION XI)					
C02	450		(PER JEA TECHNICAL SPECIFICATIONS JFX-035-09 SECTION XI) CONTROL CABLE	+			<u> </u>	+
C02	450			1				1
C02	450		CONDUCTOR SIZE:#10 STR/B					
	450 1500	FT		JEA STOREROOM	CAICN018	JEA		
		FT	CONDUCTOR SIZE:#10 STR/B NO OF CONDUCTORS:21 SHIELDED REEL SIZE:NCR58.32		CAICN018	JEA		
C02	1500		CONDUCTOR SIZE:#10 STR/B NO OF CONDUCTORS:21 SHIELDED					
		FT	CONDUCTOR SIZE:#10 STR/B NO OF CONDUCTORS:21 SHIELDED REEL SIZE:NCR58.32 (PER JEA TECHNICAL SPECIFICATIONS JFX-035-09 SECTION XI) LUMINAIRE, 40W LED, 70W HPS EQUIVALENT, COBRAHEAD, 120 VAC, PE RECEPTACLE, 7-PIN	STOREROOM JEA STOREROOM	CAICN018 STLLE001	JEA JEA		
C03	1500		CONDUCTOR SIZE:#10 STR/B NO OF CONDUCTORS:21 SHIELDED REEL SIZE:NCR58.32 (PER JEA TECHNICAL SPECIFICATIONS JFX-035-09 SECTION XI) LUMINAIRE, 40W LED, 70W HPS EQUIVALENT, COBRAHEAD, 120 VAC, PE	STOREROOM				

JEA
BUILDING COMMUNITY
21 W CHURCH ST. JACKSONVILLE, FLORIDA 32202

ISSUED FOR BID

CONSULTANT INFORMATION	PROFESSIONAL ENGINEER'S SEAL
	ORIGINALLY PREPARED UNDER THE RESPONSIBLE SUPERVISION OF
	PE:
	LIC. NO.:
	STATE:
	DATE:

REV	DATE	PROJ#	REVISION DESCRIPTION	ву	REVIEW	ENGINI	EERING
-	-	-		-	ı	DATE	7/24/2018
-	-	-	-	-	-	вү	RMS
-	-	-	-	-	-	REVIEW	JAR
-	-	-	-	-	-	DRAF	TING
-	-	-	-	-	-	DATE	7/24/2018
-	-	-	-	-	-	ву	RMS
-	-	-	-	=	-	REVIEW	JAR

GEC 230 kV BAY AND BREAKER ADDITION FOR CIRCUIT 909
BILL OF MATERIALS

GE2017-BM.dgn

DRAWING SET:


GE2017


PROJ#: 8004817


GREENLAND ENERGY CENTER SWITCHYARD
SUBSTATION & TRANSMISSION ENGINEERING


AS SHOWN


WING #: SHEET #:

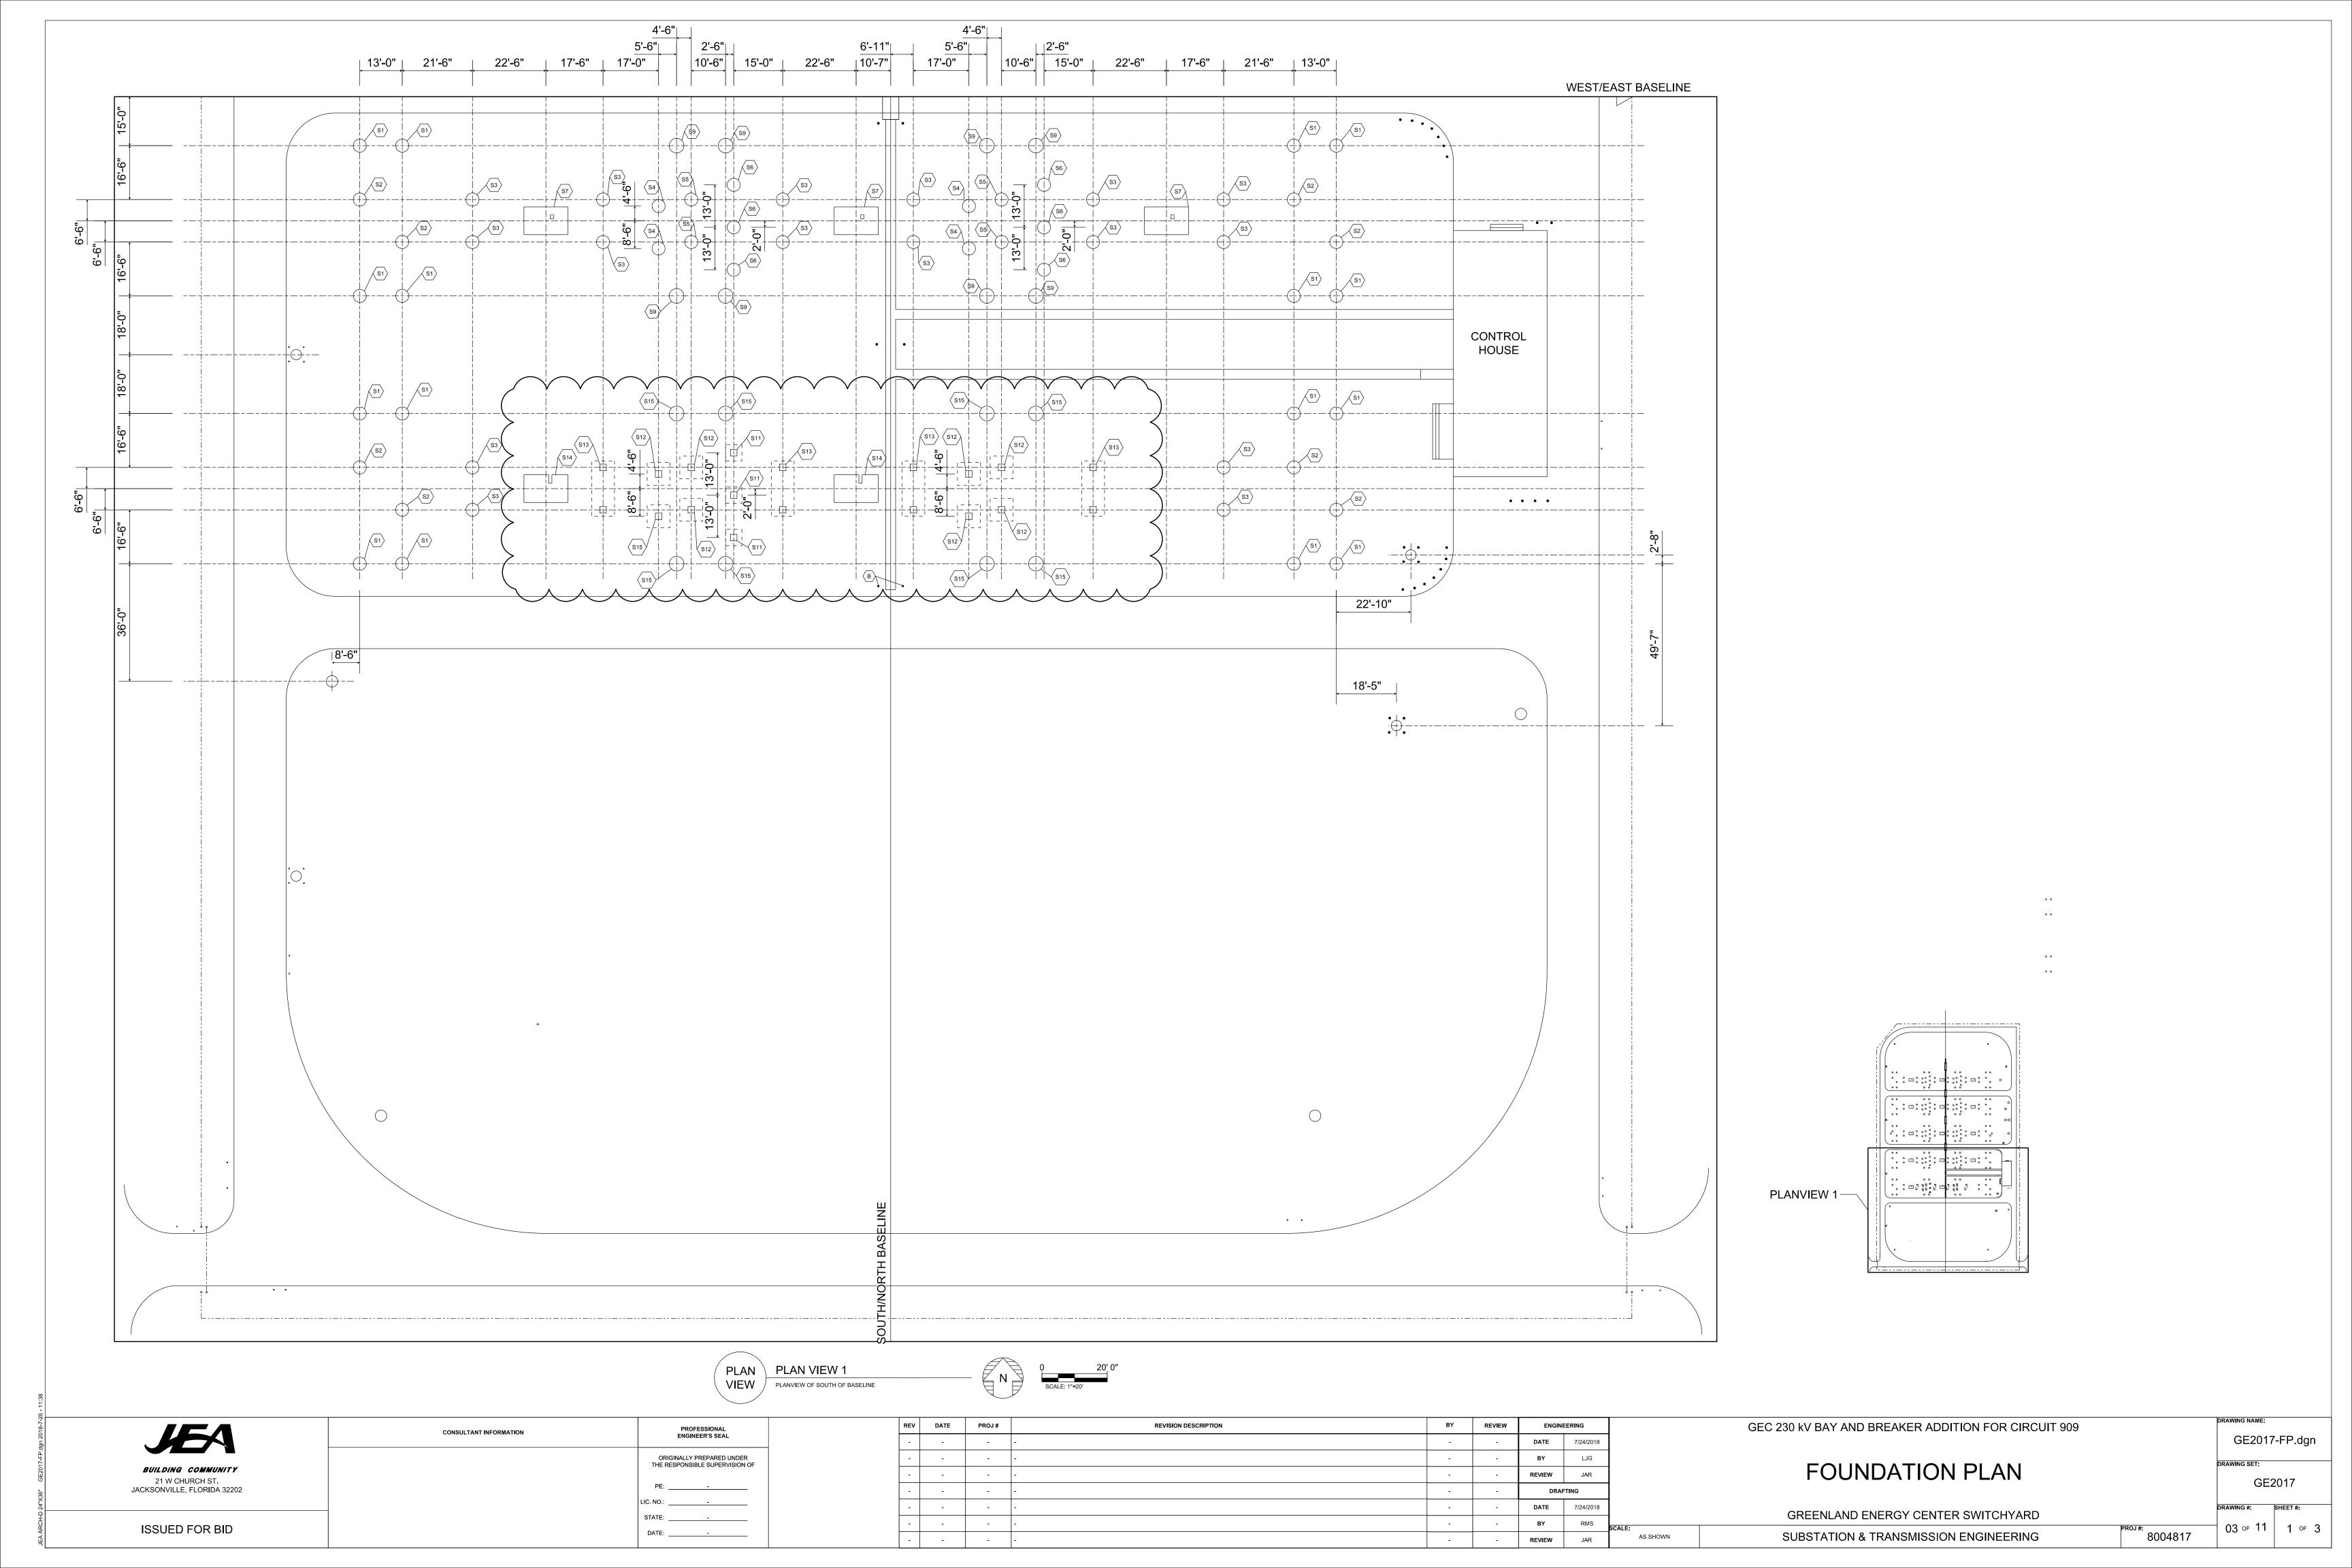

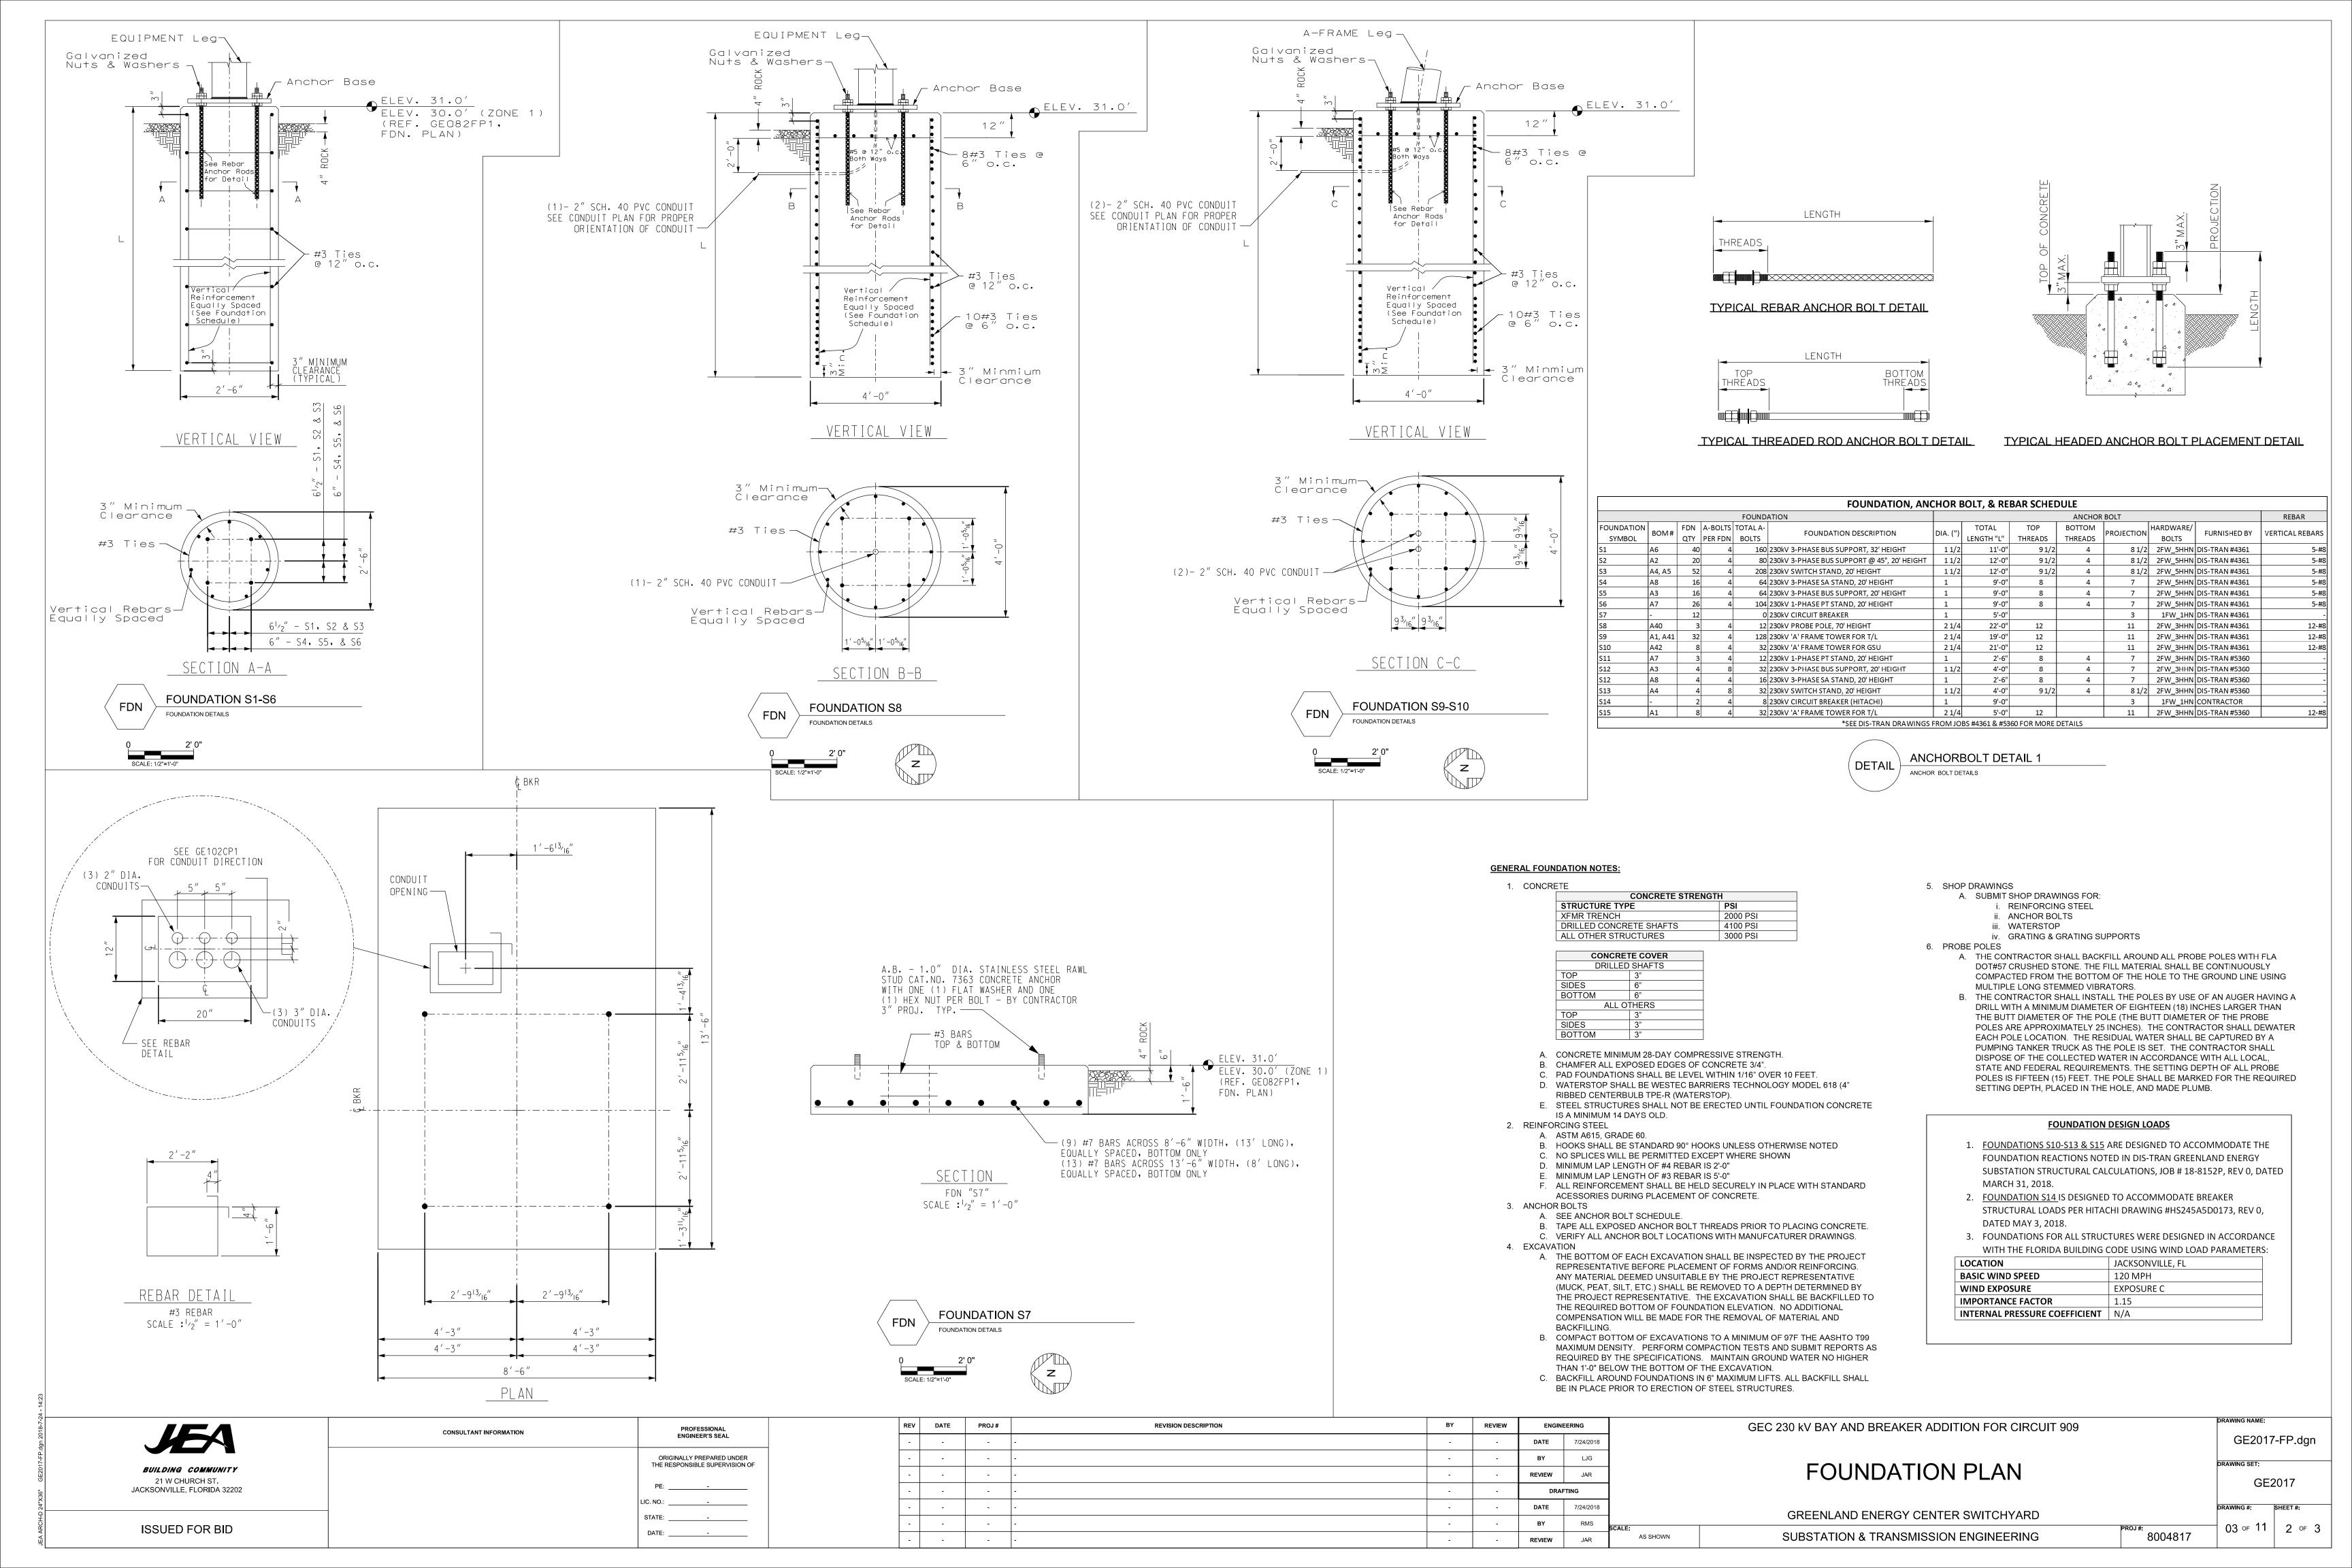


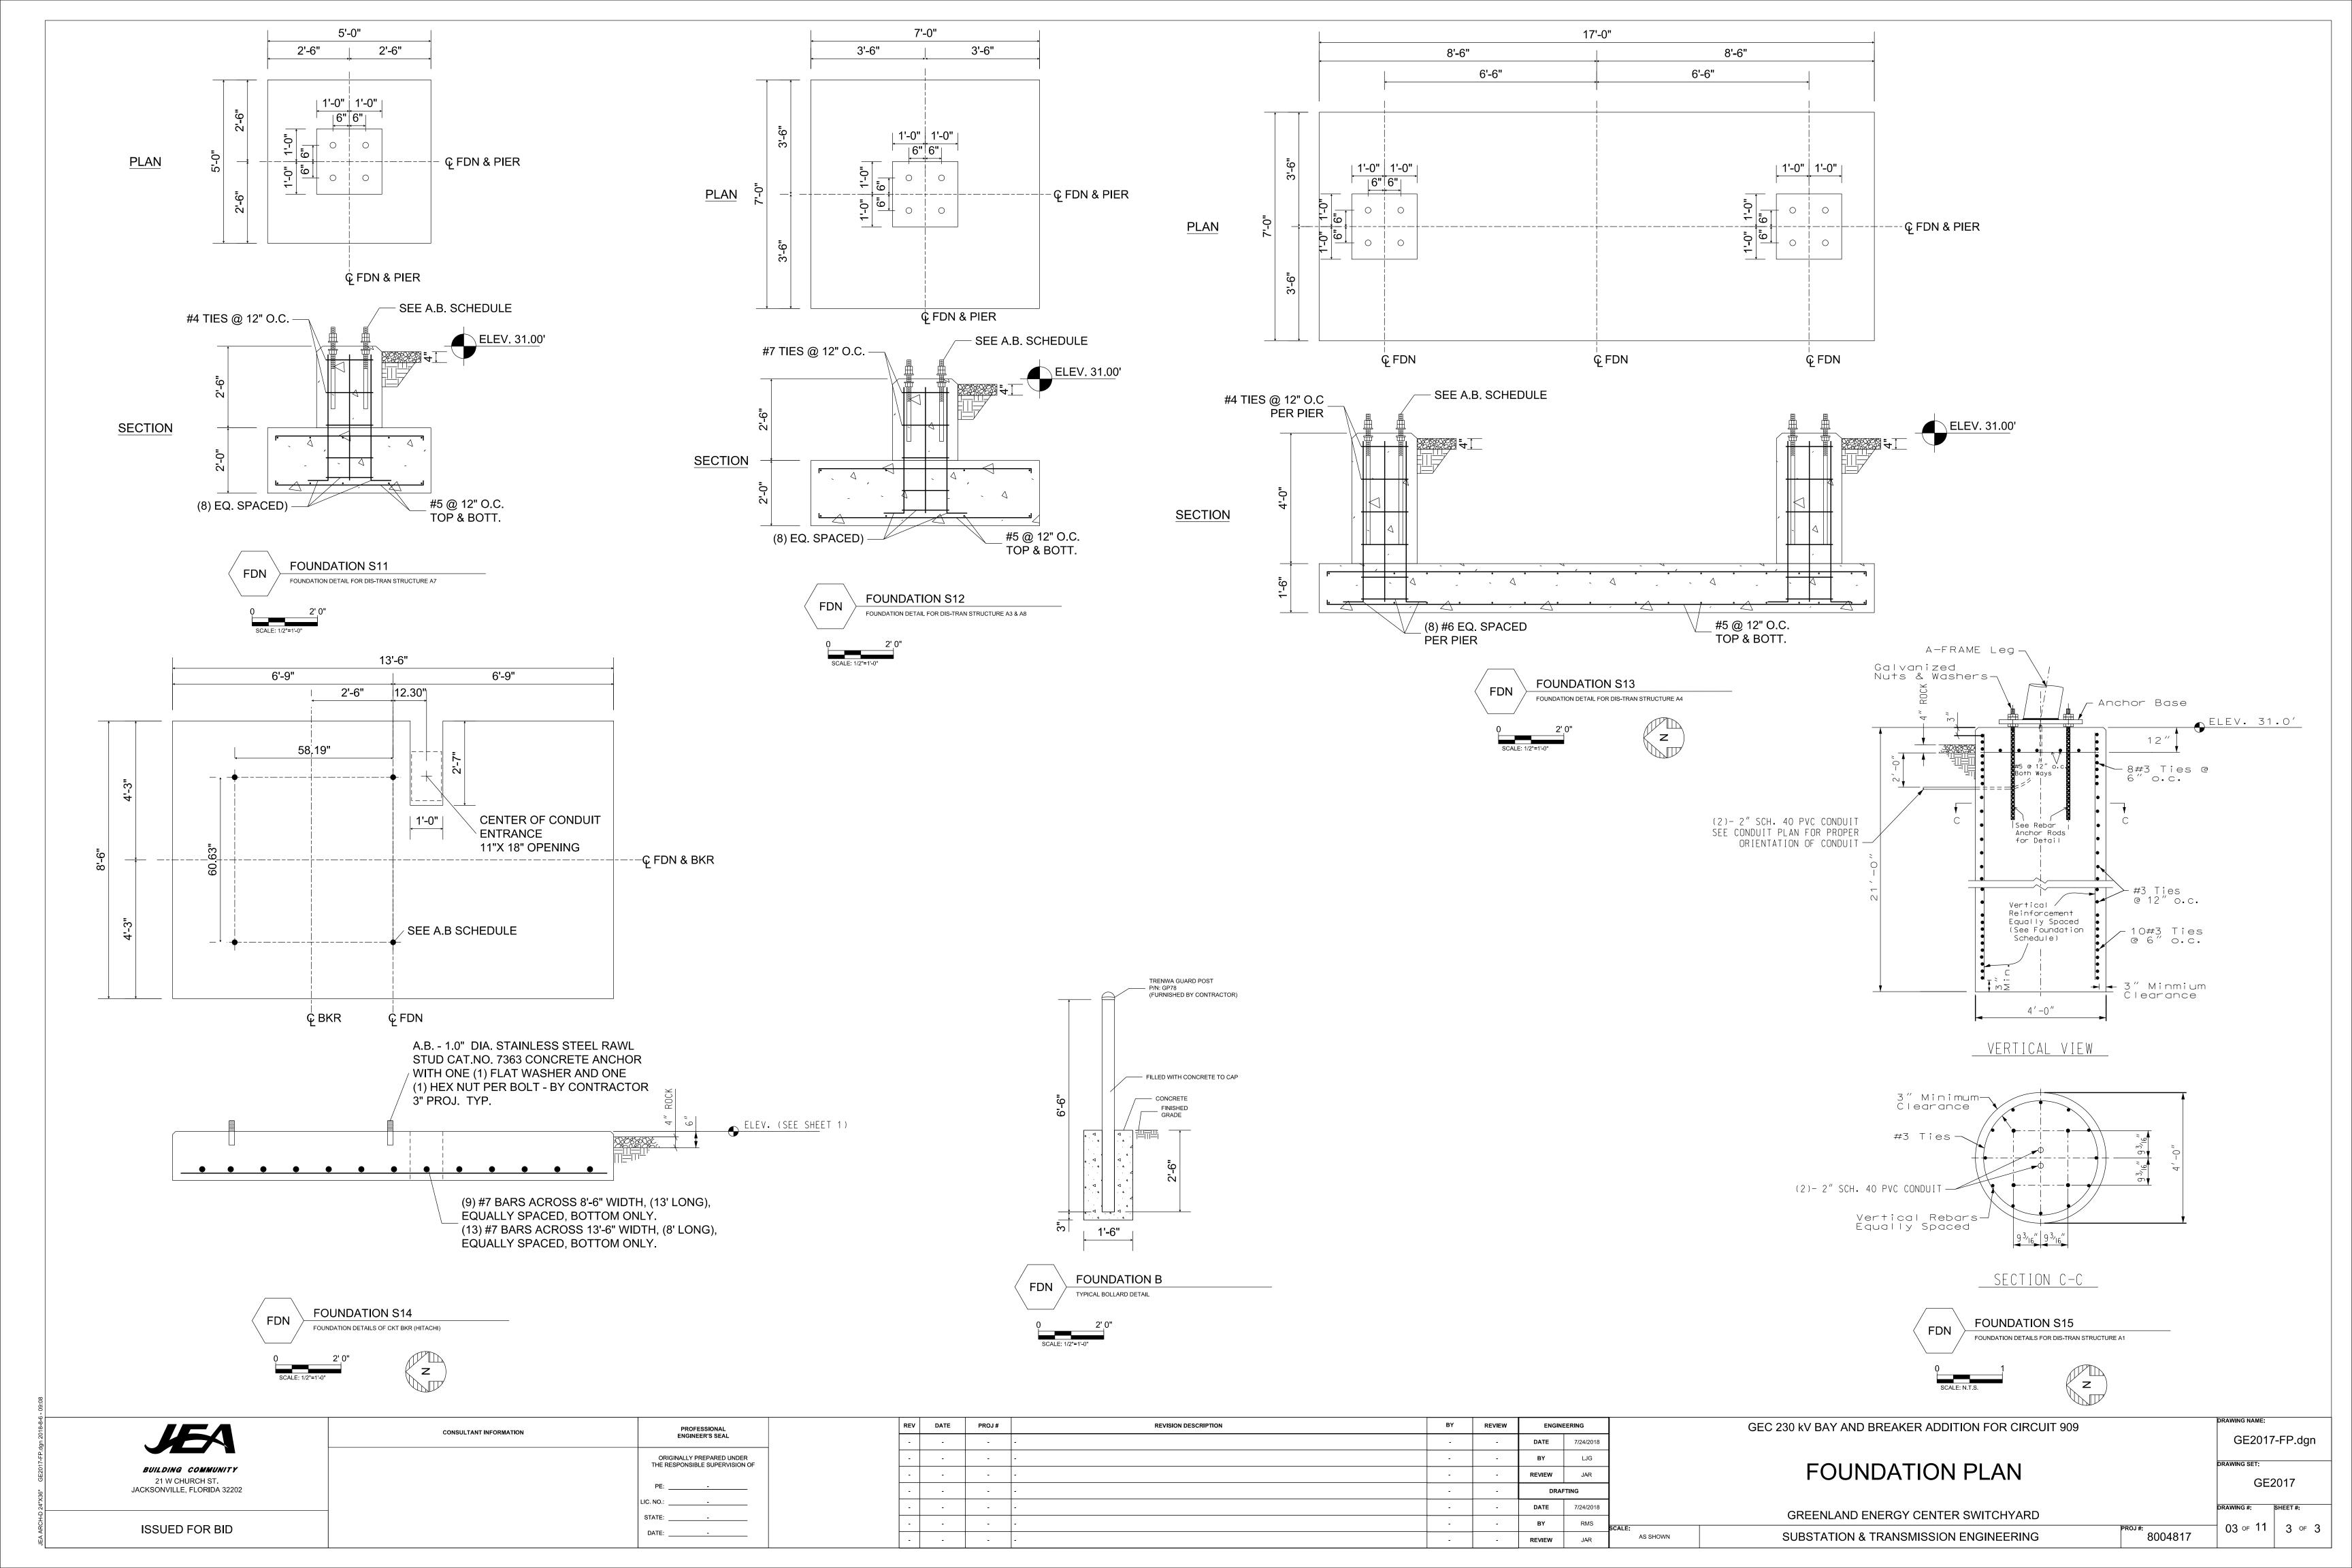

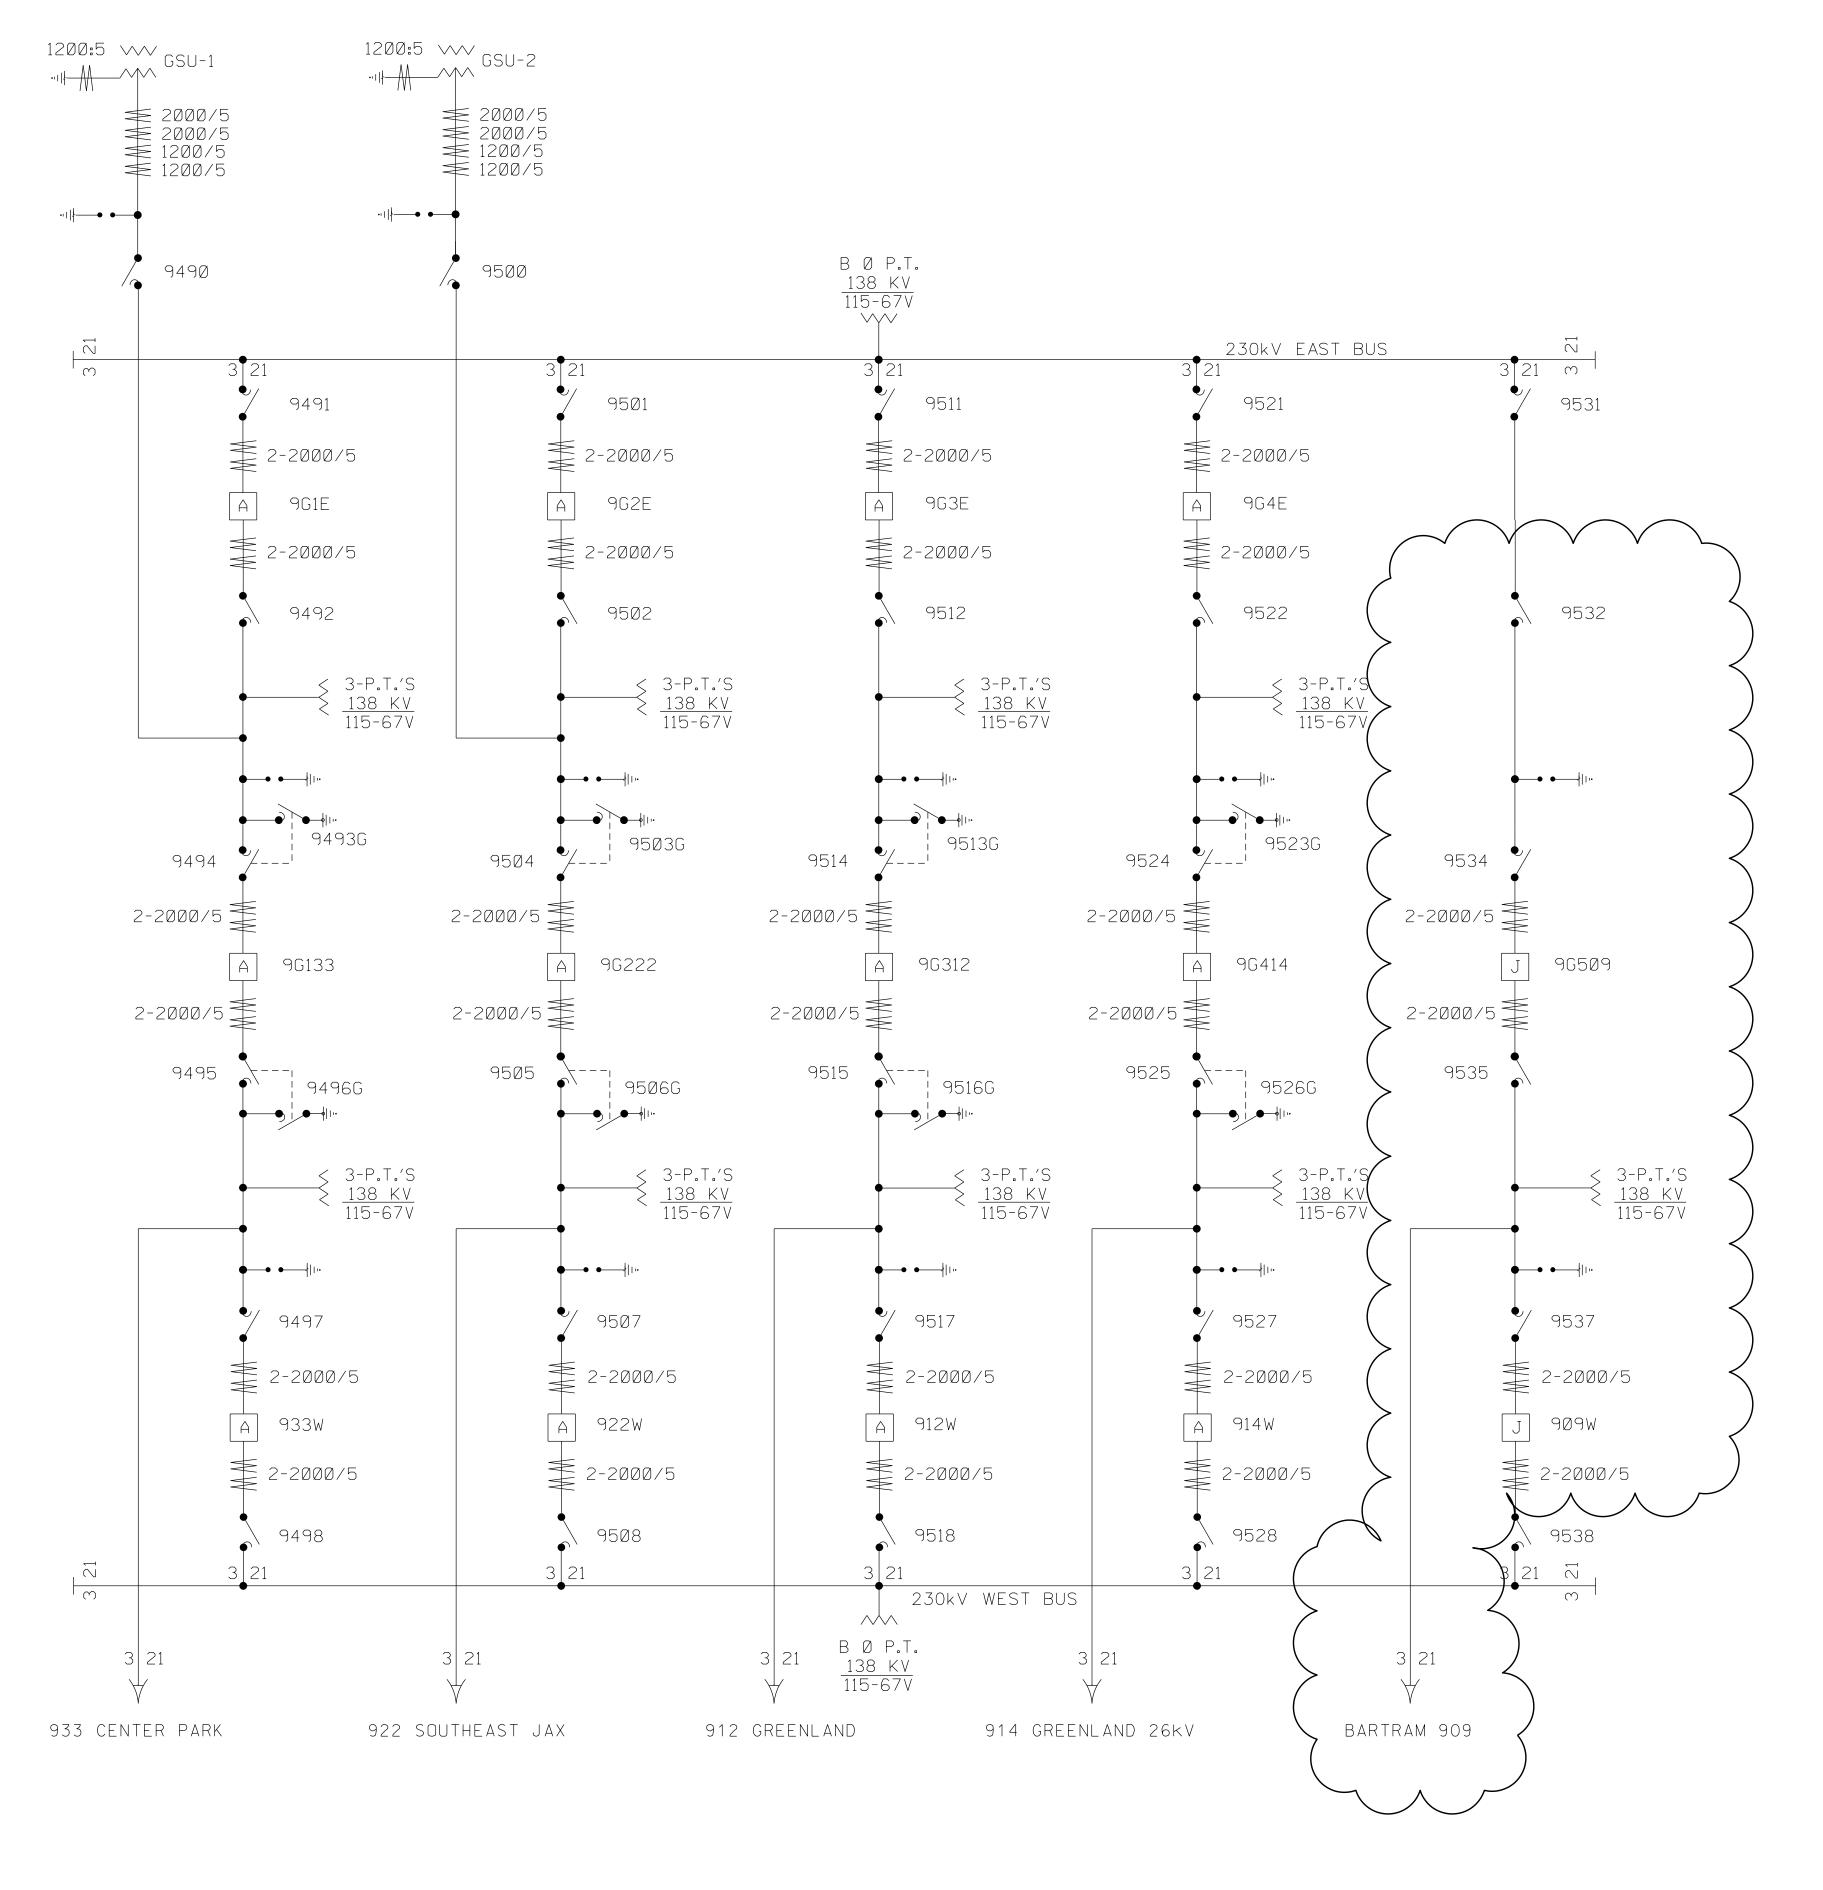


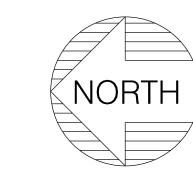


7 - 08									
	CONSULTANT INFORMATION	PROFESSIONAL	REV DATE	PROJ#	REVISION DESCRIPTION	BY REVIEW	ENGINEERING	GEC 230 kV BAY AND BREAKER ADDITION FOR CIRCUIT 909	
Jack Signal State	55105277811 811 51411771 514	ENGINEER'S SEAL					DATE 7/24/201	GE2017-SL.0	ngk
ν. γ.		ORIGINALLY PREPARED UNDER THE RESPONSIBLE SUPERVISION OF					BY RMS	RMS DRAWING SET:	
BUILDING COMMUNITY 21 W CHURCH ST							REVIEW JAR	SINGLE LINE DIAGRAM GE2017	
21 W CHURCH ST. JACKSONVILLE, FLORIDA 32202		PE:					DRAFTING	GEZU17	
20		LIC. NO.:					DATE 7/24/201	GREENLAND ENERGY CENTER SWITCHYARD ORAWING #: SHEET #:	:
ISSUED FOR BID		STATE:					BY RMS		of 1
		DATE:					REVIEW JAR	JAR AS SHOWN SUBSTATION & TRANSMISSION ENGINEERING 8004817	

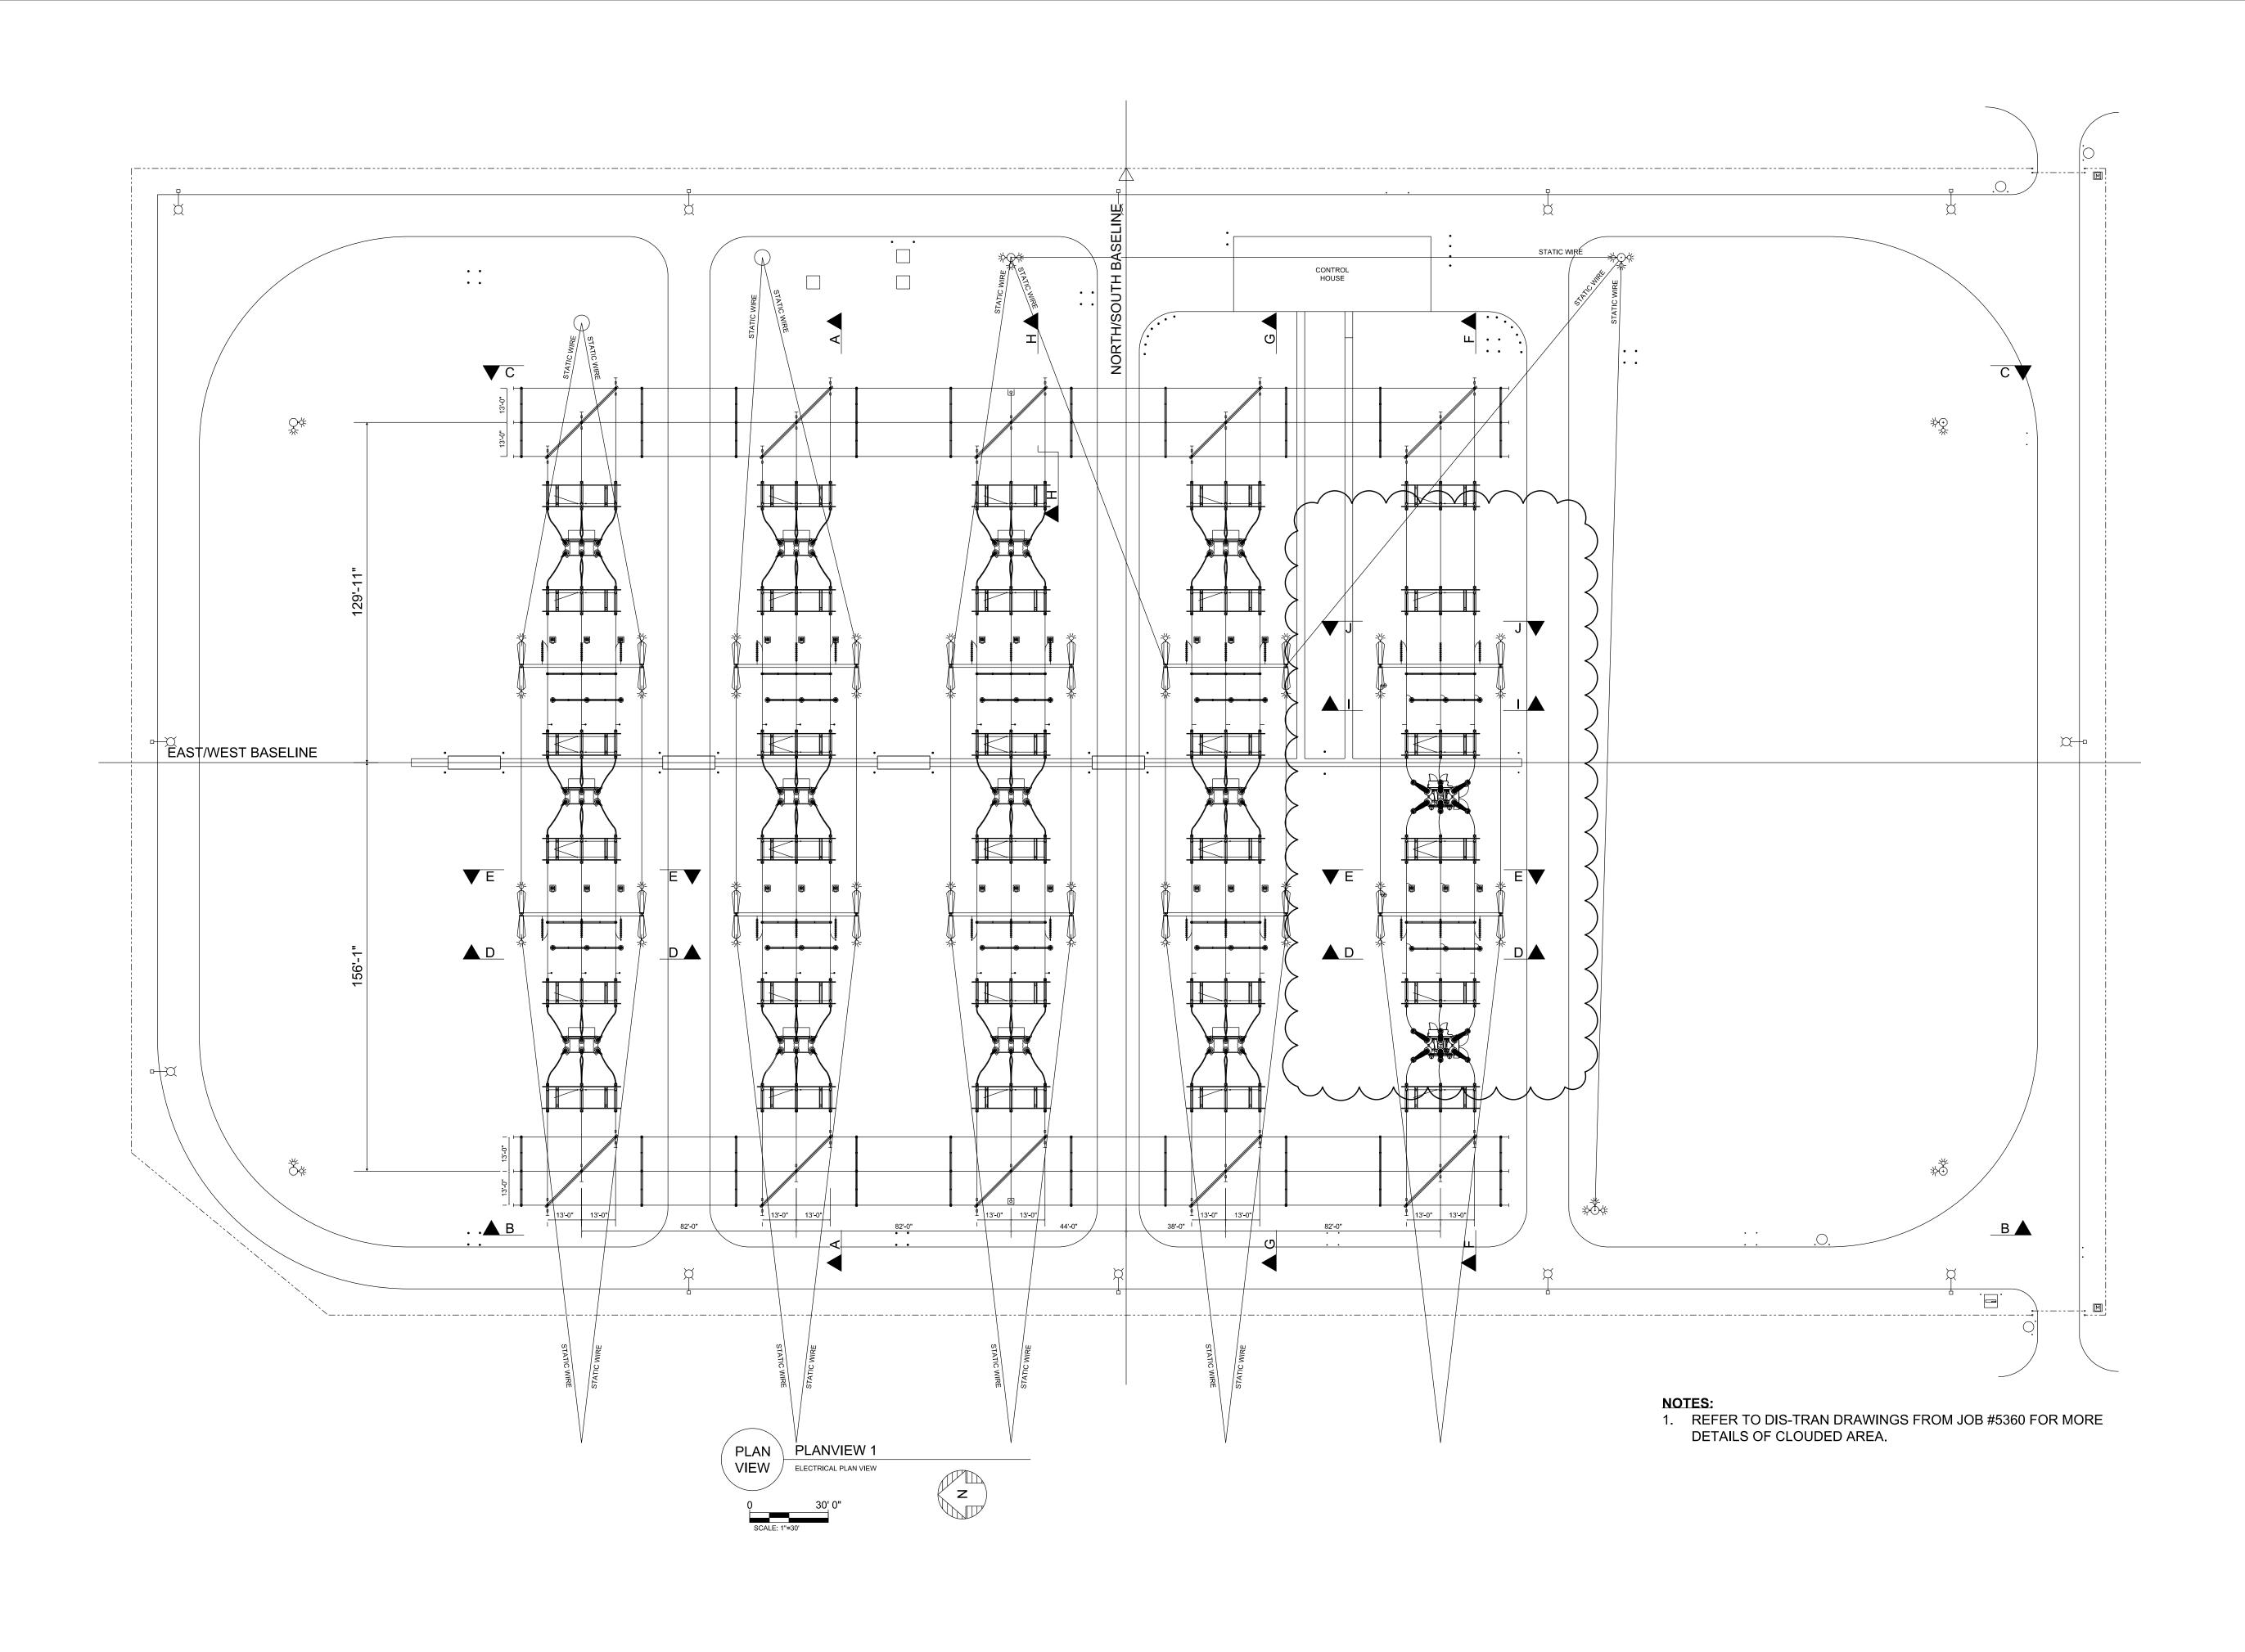

27 - 08								
	CONSULTANT INFORMATION	PROFESSIONAL ENGINEER'S SEAL	REV DATE PROJ#	REVISION DESCRIPTION	BY REVIEW	W ENGINEERING	GEC 230 kV BAY AND BREAKER ADDITION FOR CIRCUIT 909	DRAWING NAME:
	CONSOLIANT INFORMATION	ENGINEER'S SEAL				DATE 7/24/2018	_i	GE2017-EP.dgn
——————————————————————————————————————		ORIGINALLY PREPARED UNDER THE RESPONSIBLE SUPERVISION OF			- <u>-</u>	BY RMS		DRAWING SET:
BUILDING COMMUNITY 21 W CHURCH ST		THE NEST STORES SOLETONS ST.				REVIEW JAR	ELECTRICAL PLAN	GE2017
21 W CHURCH ST. JACKSONVILLE, FLORIDA 32202		PE:				DRAFTING	1	GE2017
7,"		LIC. NO.:				DATE 7/24/2018	GREENLAND ENERGY CENTER SWITCHYARD	DRAWING #: SHEET #:
ISSUED FOR BID		STATE:				BY RMS	SCALE: PROJ #:	#: 05 of 11 1 of 5
A ISSOED FOR BID		DATE:				REVIEW JAR	AS SHOWN SUBSTATION & TRANSMISSION ENGINEERING 80	8004817

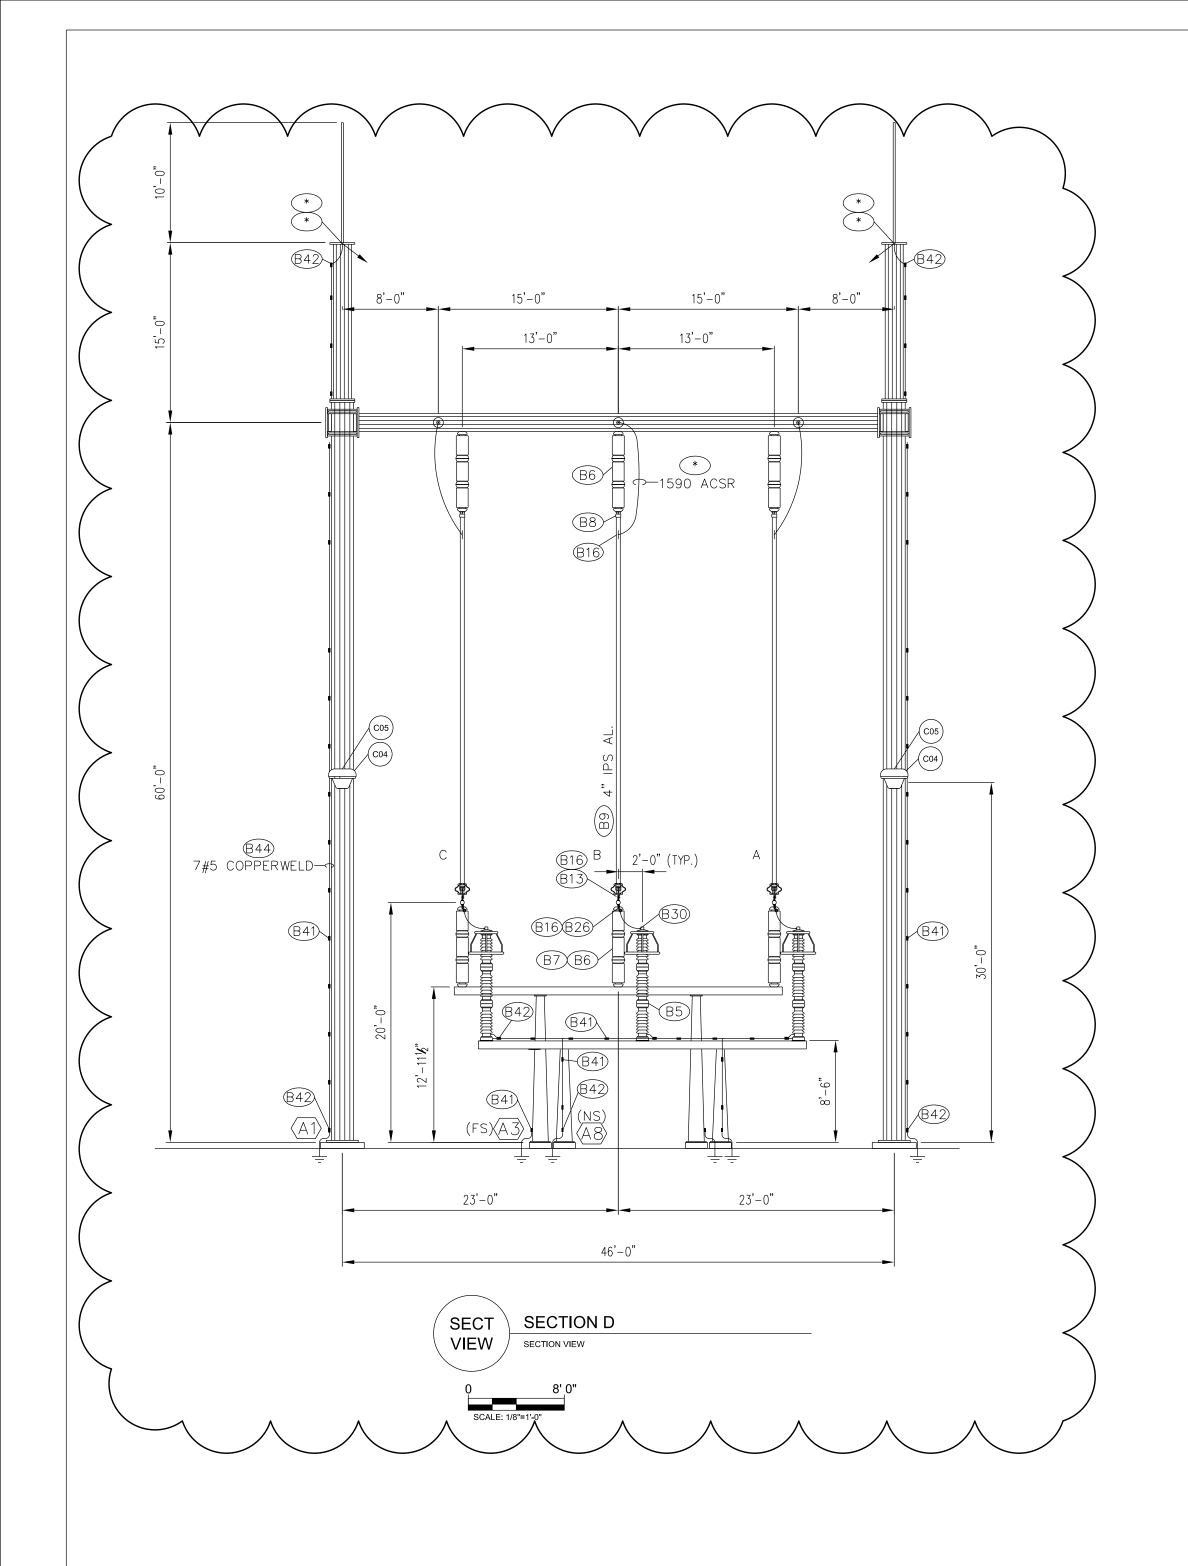

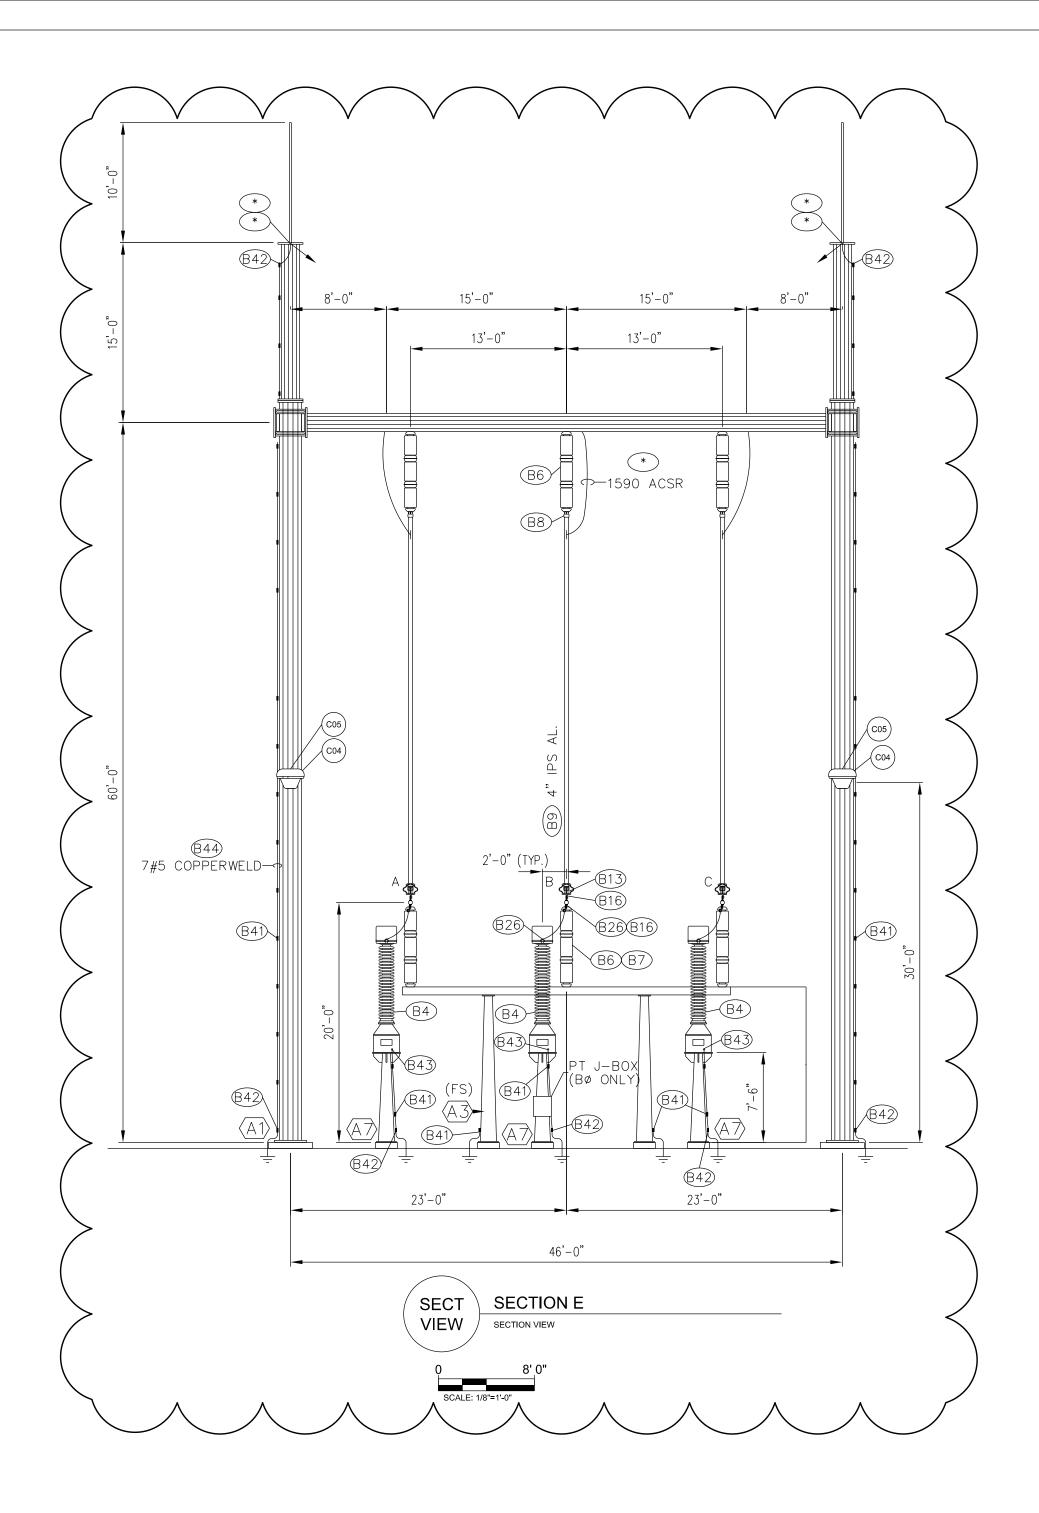

LEGEND:

* - MATERIAL FURNISHED BY OTHERS

- REFER TO BILL OF MATERIAL

— STRUCTURE DESIGNATION


RIGID BUS FITTING

💲 – SLIP BUS FITTING

\& – EXPANSION BUS FITTING

→ OPERATING MECHANISM

79											To a second seco	WING NAME:
	CONSULTANT INFORMATION	PROFESSIONAL	REV	DATE	PROJ#	REVISION DESCRIPTION	ВҮ	REVIEW	ENG	INEERING	GEC 230 kV BAY AND BREAKER ADDITION FOR CIRCUIT 909	
dgn 20		ENGINEER'S SEAL	-	-	- -		-	-	DATE	7/24/2018		GE2017-EP.dgn
		ORIGINALLY PREPARED UNDER THE RESPONSIBLE SUPERVISION OF	-	-			-	-	ВҮ	RMS	DRAW	WING SET:
BUILDING COMMUNITY		THE RESI CHOISE SOI ENVISION OF	-	-			-	-	REVIEW	JAR	ELECTRICAL PLAN	
21 W CHURCH ST. JACKSONVILLE, FLORIDA 32202		PE:	-	-			-	-	DR	RAFTING		GE2017
X.X.		LIC. NO.:	-	-			-	-	DATE	7/24/2018	DRAWI	WING #: SHEET #:
ICCLIED FOR DID		STATE:	-	-			-	-	BY	RMS	GREENLAND ENERGY CENTER SWITCHYARD	05 of 11 2 of 5
ISSUED FOR BID		DATE:	-	-			-	-	REVIEW	JAR	SCALE: AS SHOWN SUBSTATION & TRANSMISSION ENGINEERING PROJ #: 05	2 0 5

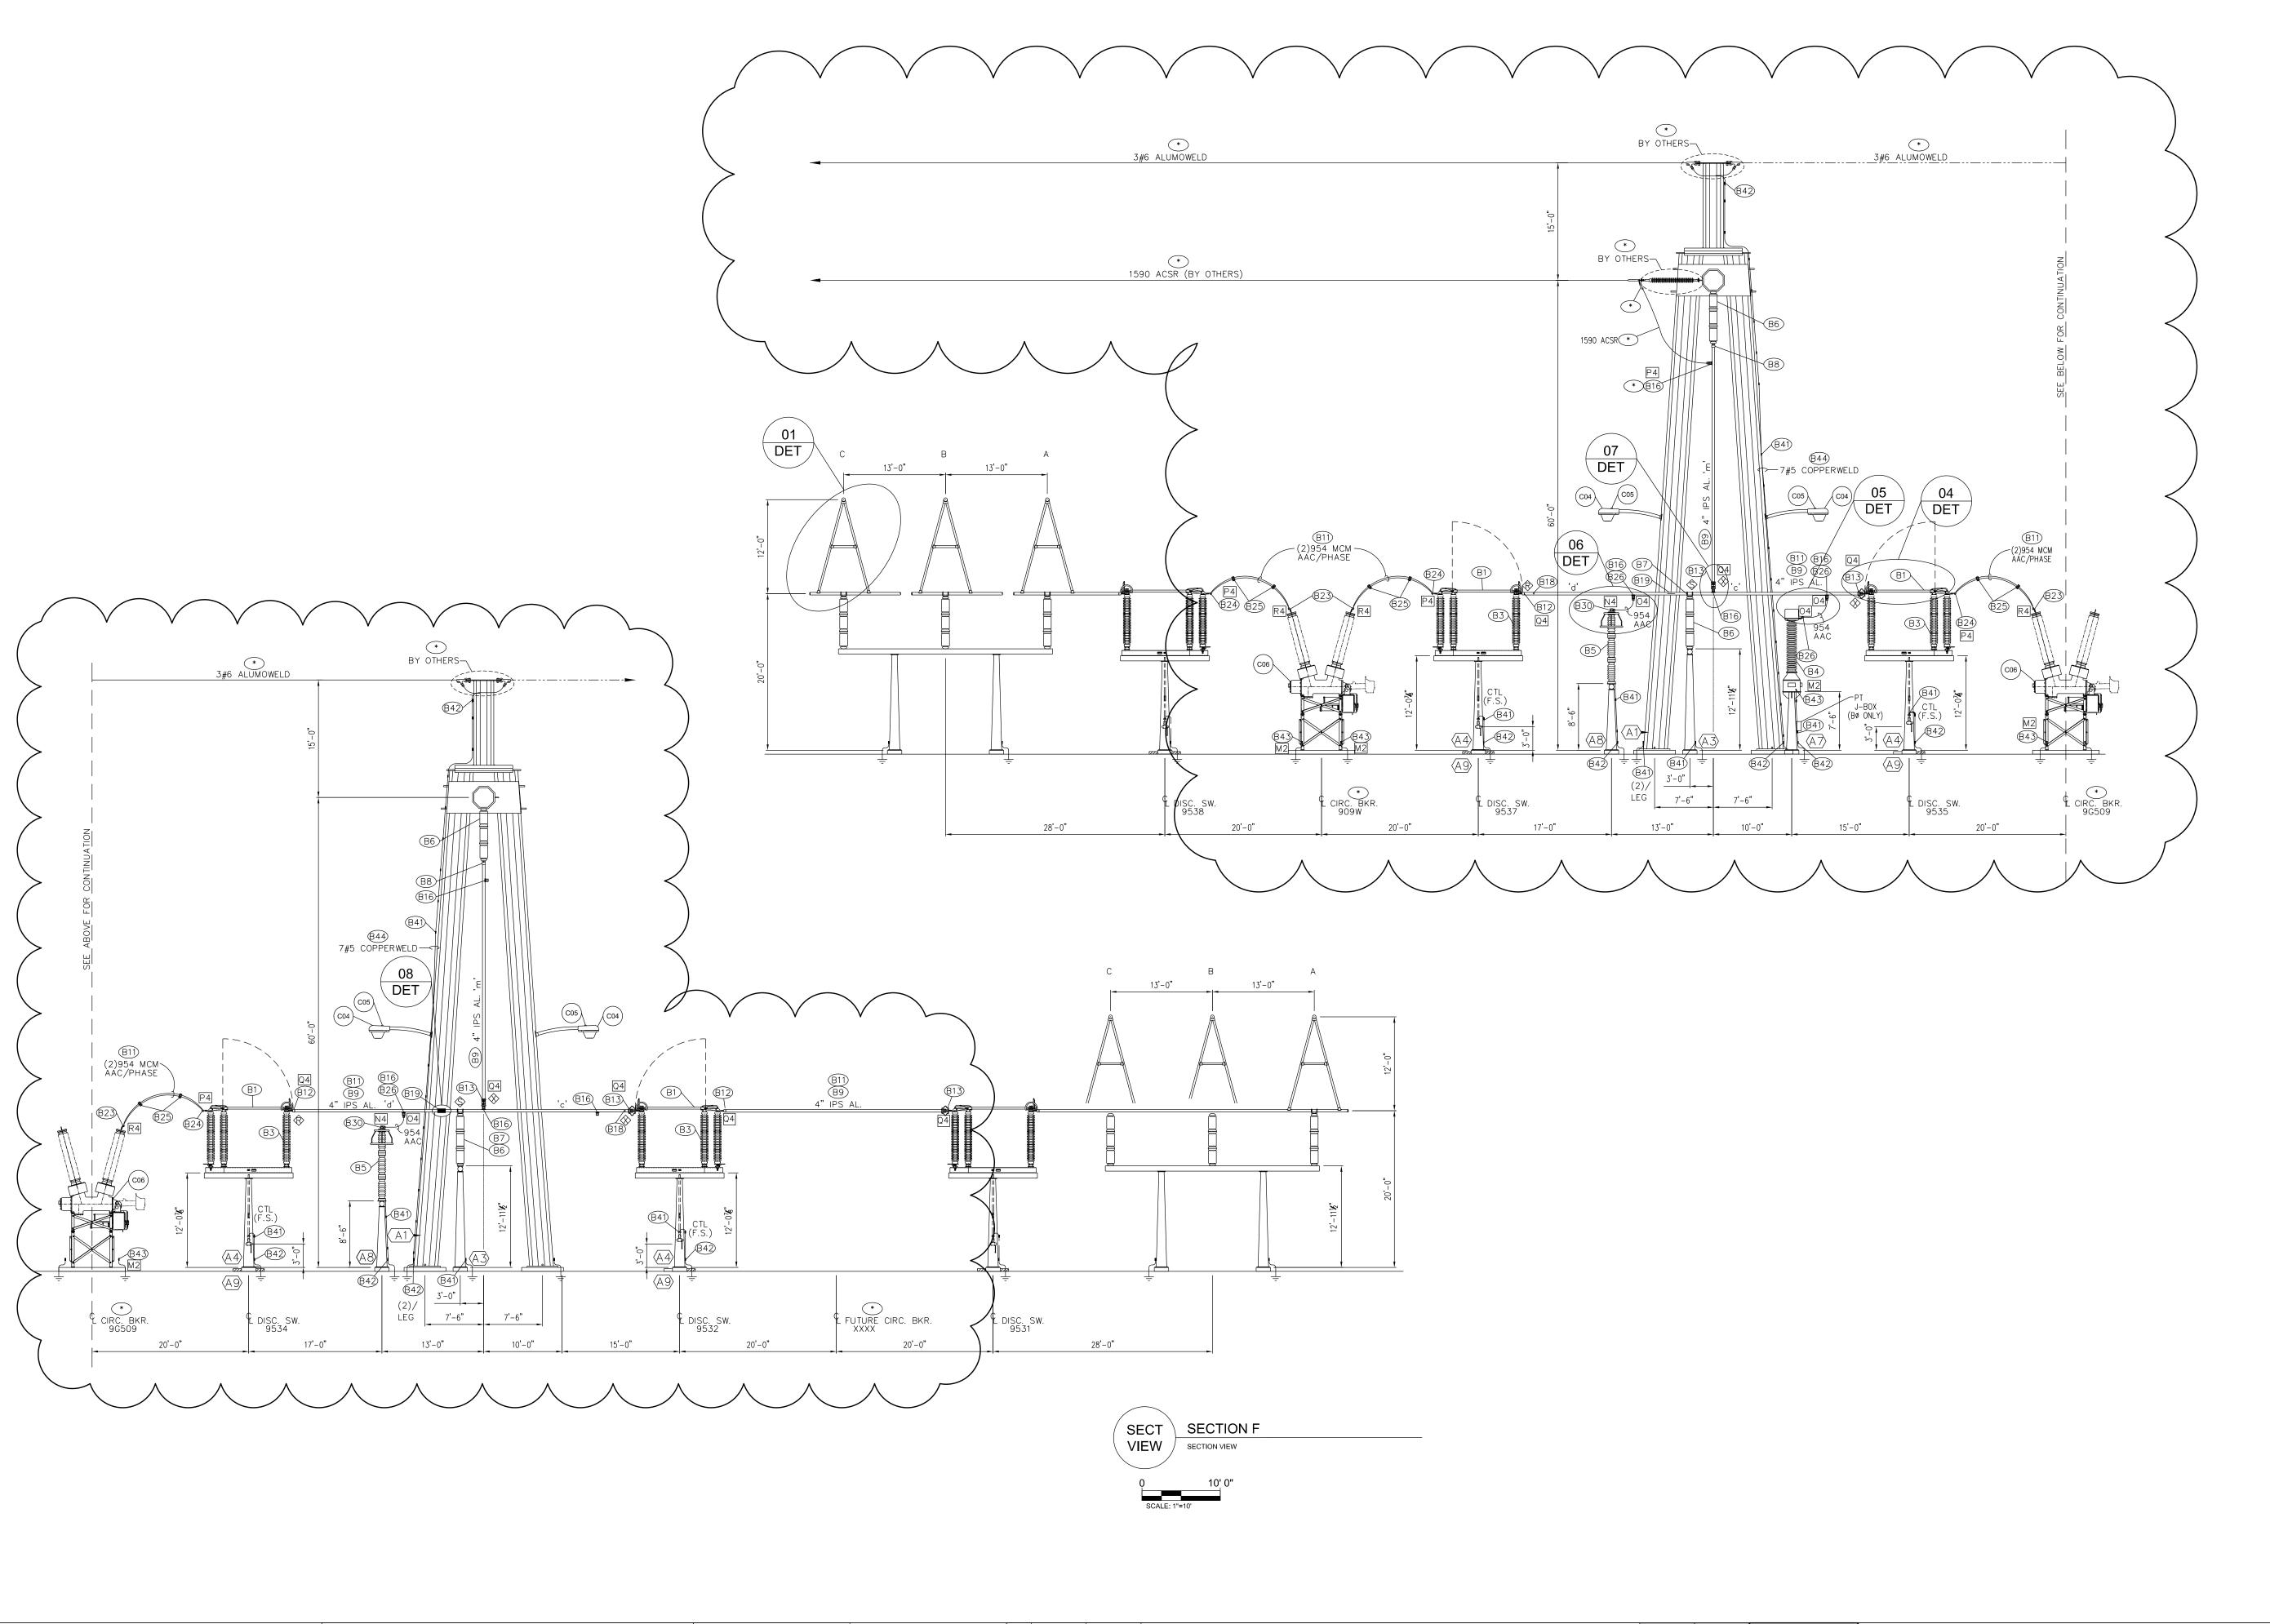

LEGEND:

* - MATERIAL FURNISHED BY OTHERS

- REFER TO BILL OF MATERIAL

— STRUCTURE DESIGNATION

RIGID BUS FITTING


S - SLIP BUS FITTING

♦ – EXPANSION BUS FITTING

→ OPERATING MECHANISM

----- - FUTURE STRUCTURES/EQUIPMENT

GEC 230 kV BAY AND BREAKER ADDITION FOR CIRCUIT 909 REV DATE REVISION DESCRIPTION PROFESSIONAL ENGINEER'S SEAL CONSULTANT INFORMATION GE2017-EP.dgn **DATE** 7/24/2018 ORIGINALLY PREPARED UNDER THE RESPONSIBLE SUPERVISION OF ELECTRICAL PLAN REVIEW JAR 21 W CHURCH ST. JACKSONVILLE, FLORIDA 32202 GE2017 DRAFTING **DATE** 7/24/2018 DRAWING #: SHEET #: GREENLAND ENERGY CENTER SWITCHYARD RMS ISSUED FOR BID 05 of 11 3 of 5 REVIEW ** 8004817 SUBSTATION & TRANSMISSION ENGINEERING

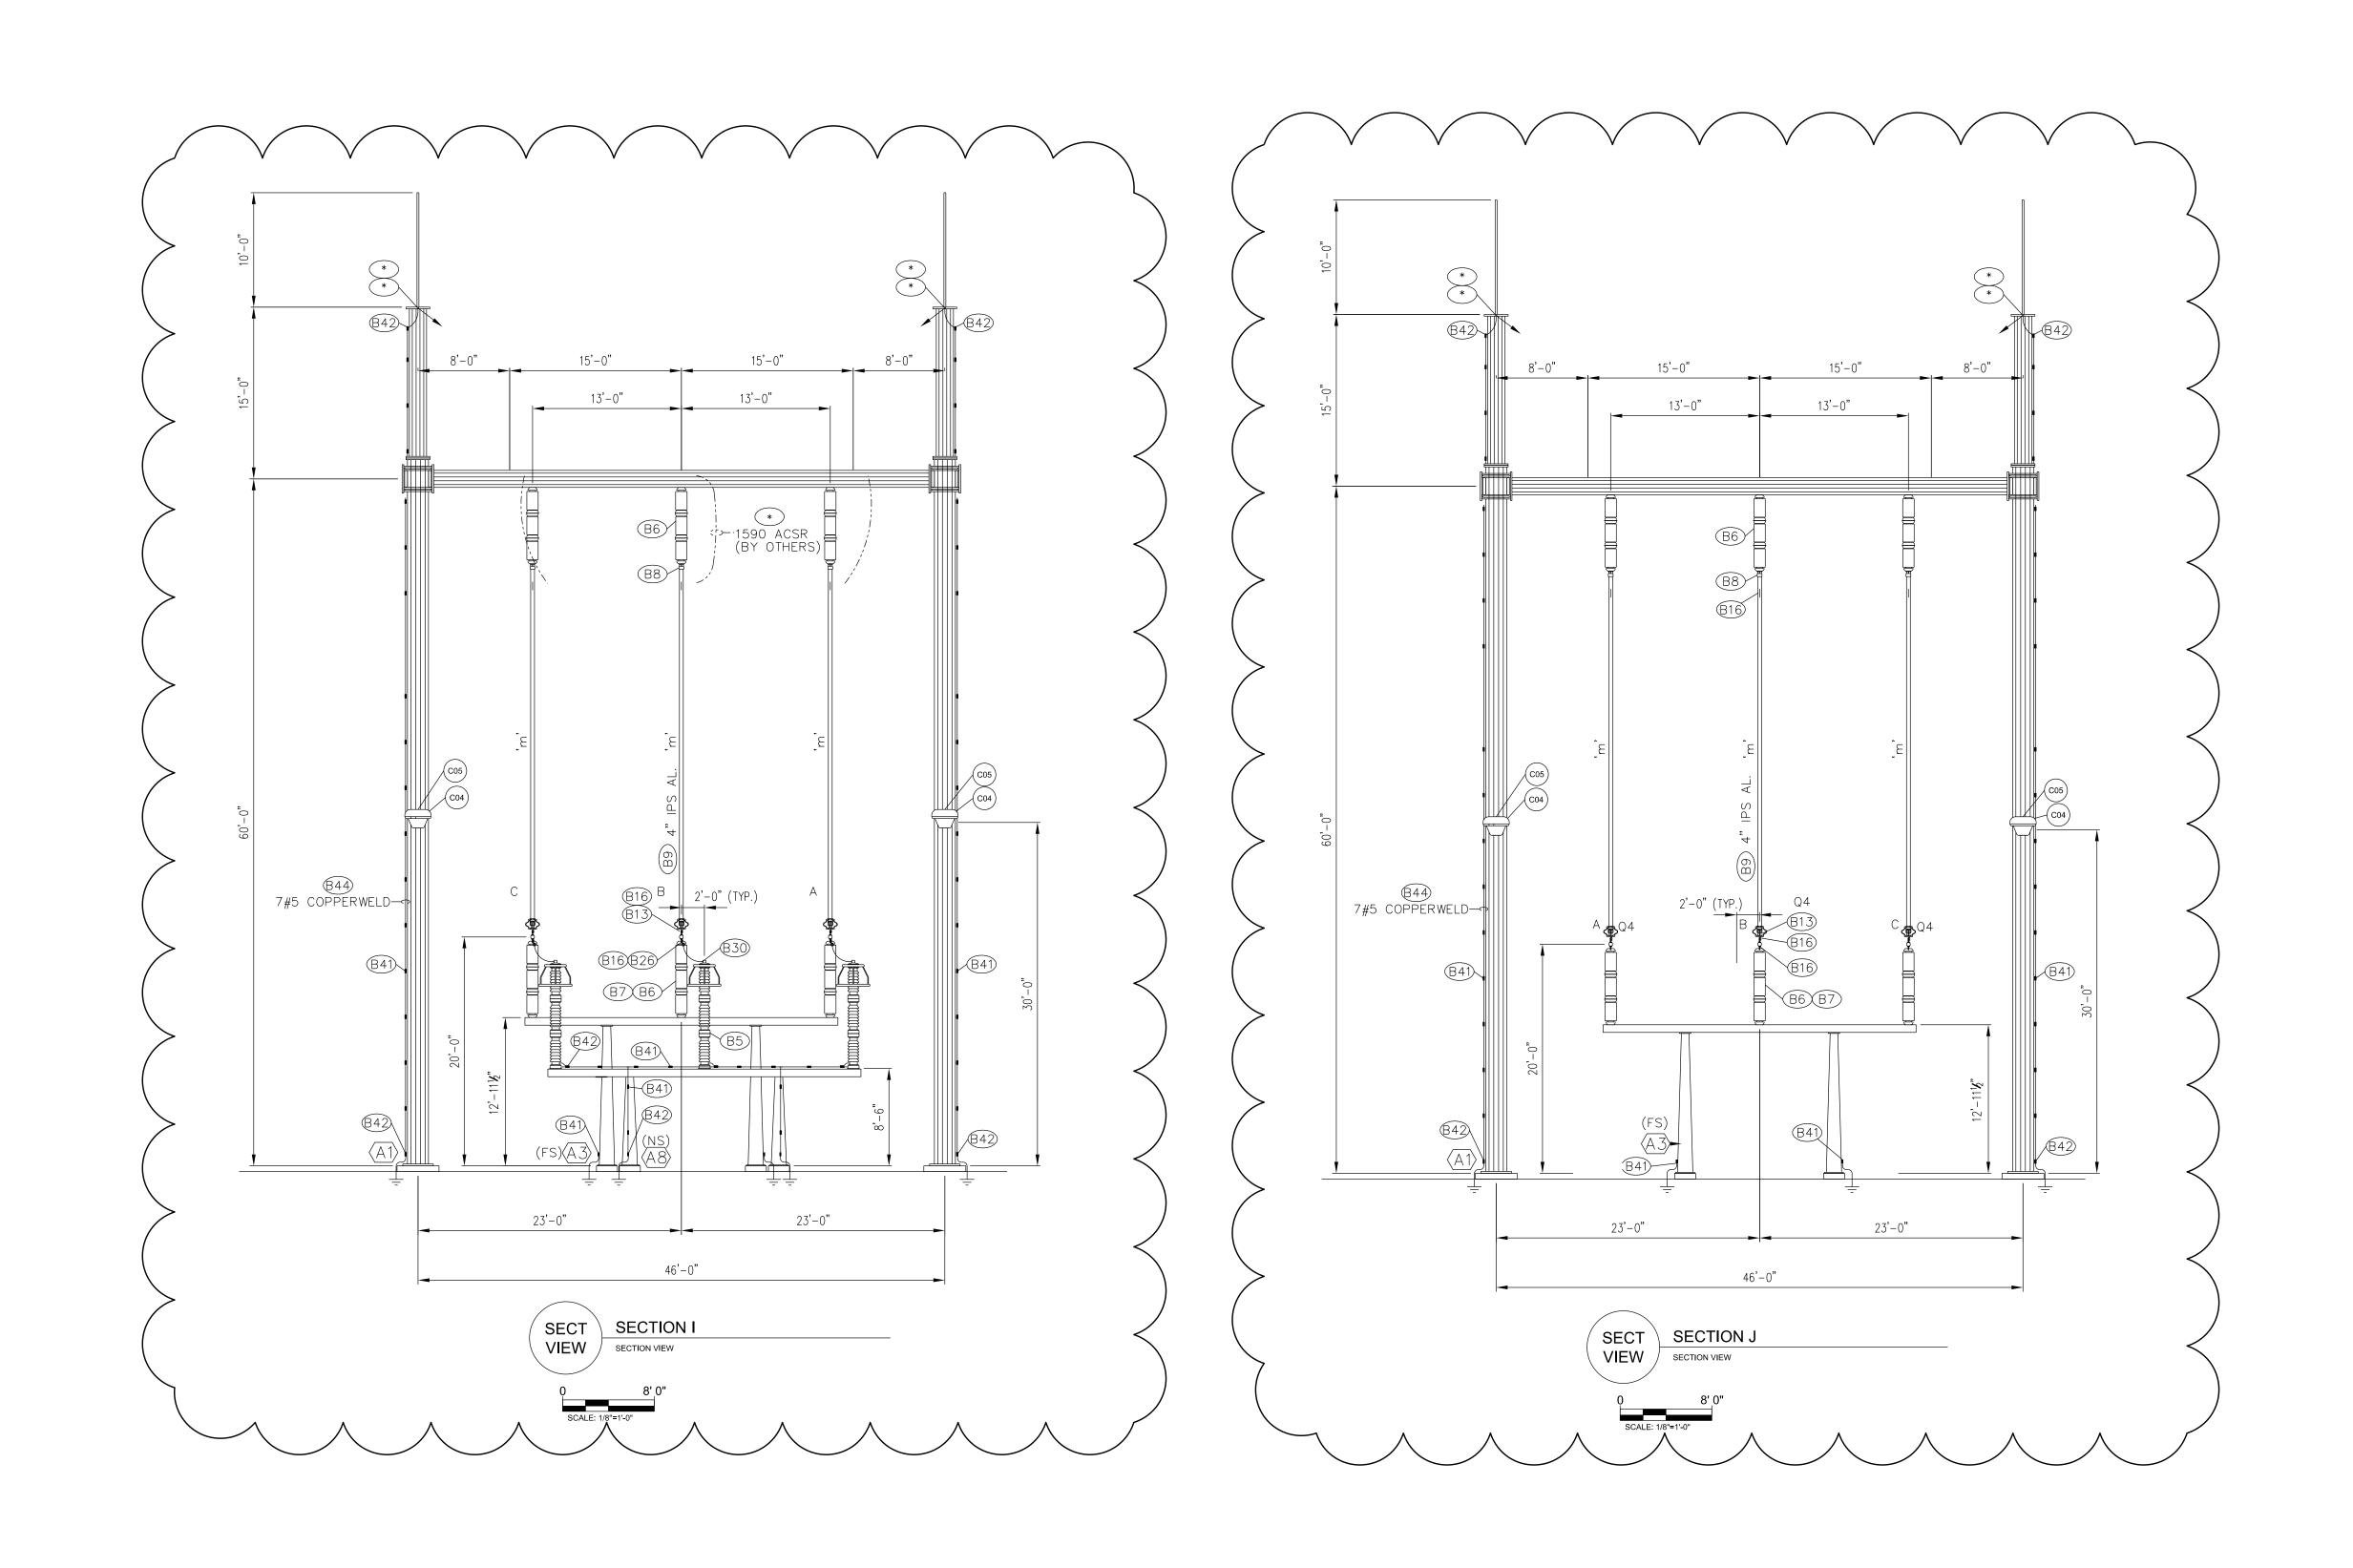

LEGEND:

* - MATERIAL FURNISHED BY OTHERS

- REFER TO BILL OF MATERIAL — STRUCTURE DESIGNATION


RIGID BUS FITTING


S - SLIP BUS FITTING

- Expansion bus fitting


OPERATING MECHANISM


	CONSULTANT INFORMATION	PROFESSIONAL ENGINEER'S SEAL	REV DATE	PROJ#	REVISION DESCRIPTION	BY	REVIEW	ENGINEERING	GEC 230 kV BAY AND BREAKER ADDITION FOR CIRCUIT 909	DRAWING NAME:
dgn 20	CONSCITANTINFORMATION	ENGINEER'S SEAL		-	-	-	-	DATE 7/24/2018		GE2017-EP.dgn
<u>—————————————————————————————————————</u>		ORIGINALLY PREPARED UNDER THE RESPONSIBLE SUPERVISION OF		-	-	-	-	BY RMS		DRAWING SET:
BUILDING COMMUNITY 21 W CHURCH ST.				-	-	-	-	REVIEW JAR	ELECTRICAL PLAN	GE2017
21 W CHURCH ST. JACKSONVILLE, FLORIDA 32202		PE:		-	-	-	-	DRAFTING		GLZ017
-D 24"		LIC. NO.:		-	-	-	-	DATE 7/24/2018	GREENLAND ENERGY CENTER SWITCHYARD	DRAWING #: SHEET #:
ISSUED FOR BID		DATE:		-	-	-	-	BY RMS SCALE:		05 of 11 4 of 5
) LE VIELLE CONTRACTOR		DAIL.		-	-	-	-	REVIEW JAR AS SHOWN	SUBSTATION & TRANSMISSION ENGINEERING 8	004817

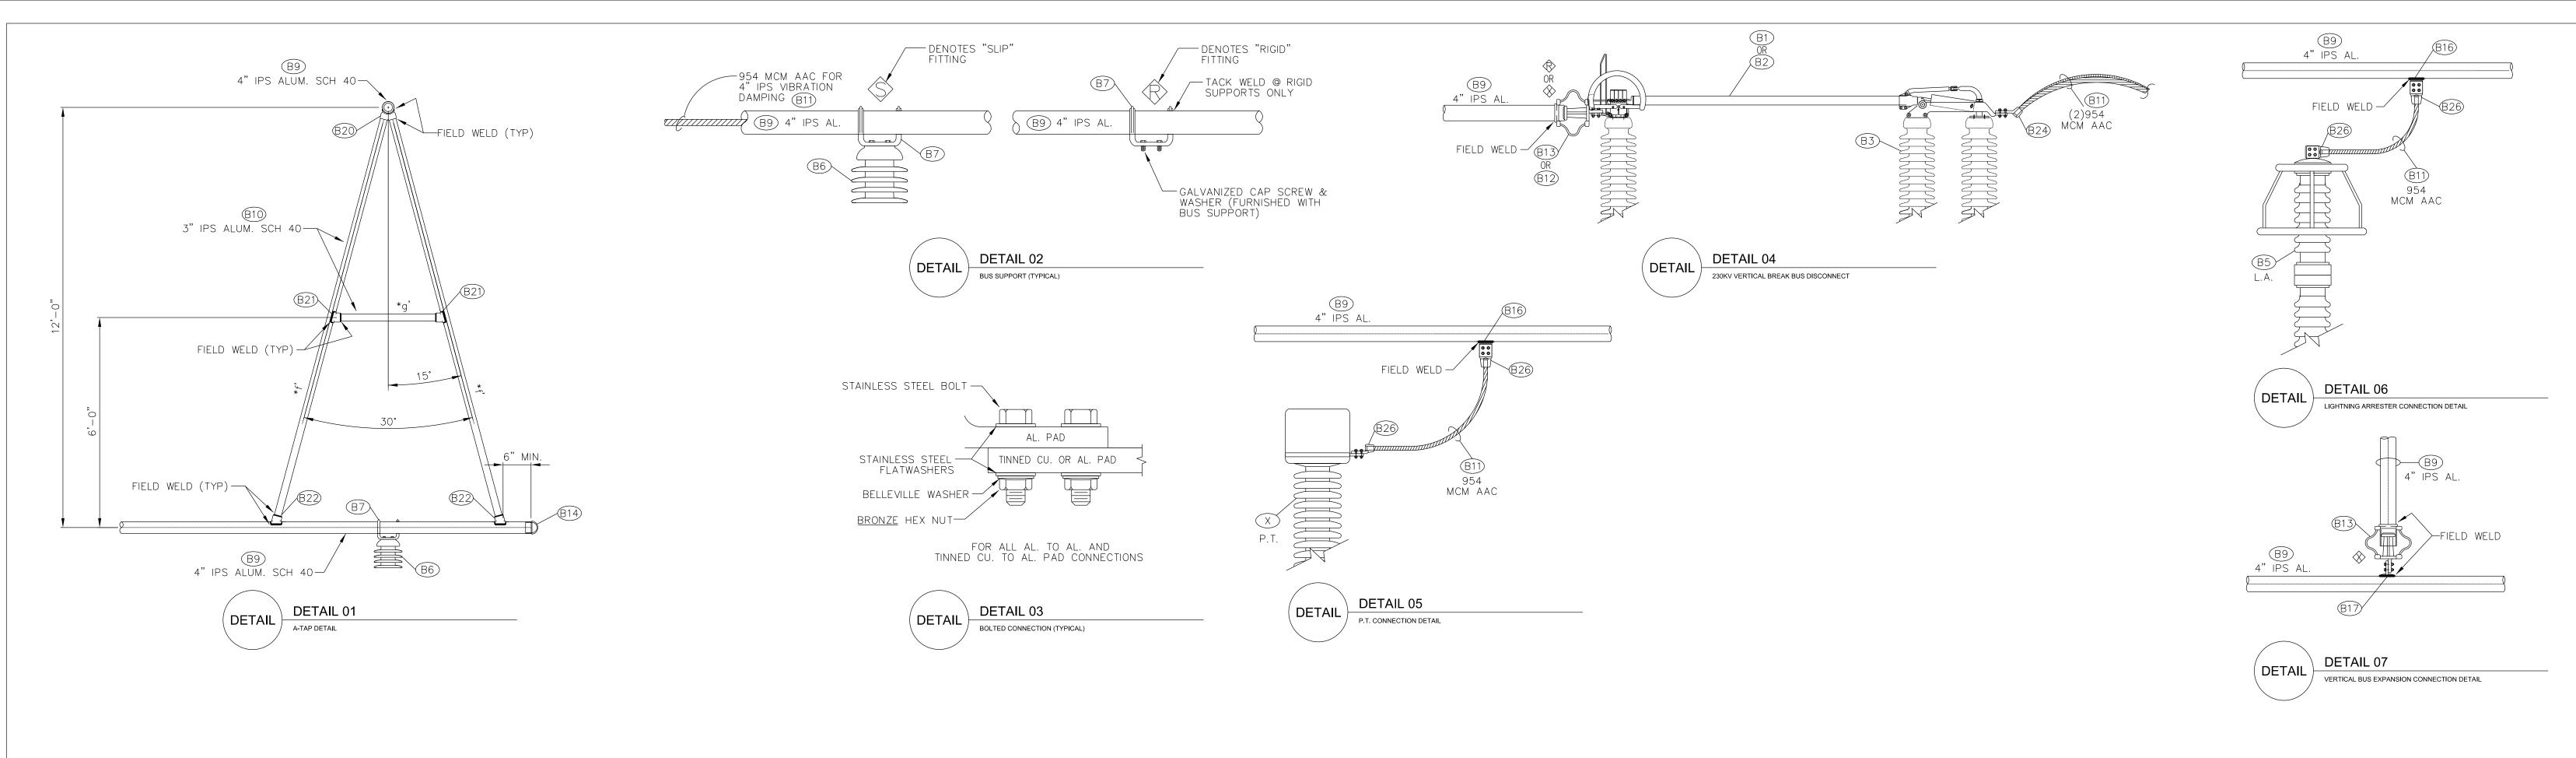

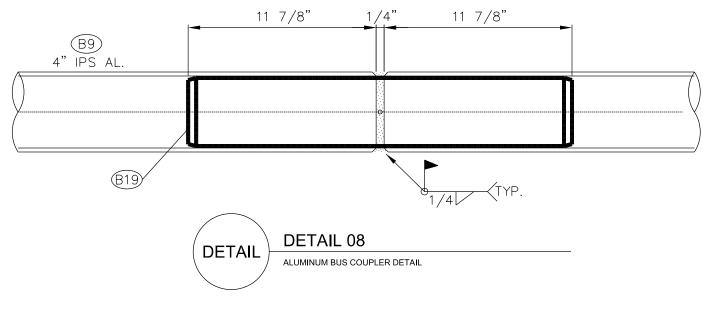

	CONSULTANT INFORMATION	PROFESSIONAL	REV DATE	PROJ#	REVISION DESCRIPTION	BY REVIEW	ENGIN	NEERING	GEC 230 kV BAY AND BREAKER ADDITION FOR CIRCUIT 909	DRAWING NAME:
	CONSCIANTINI SIMIATION	ENGINEER'S SEAL					DATE	7/24/2018		GE2017-EP.dgn
		ORIGINALLY PREPARED UNDER THE RESPONSIBLE SUPERVISION OF					ВҮ	RMS		DRAWING SET:
BUILDING COMMUNITY		THE RESPONSIBLE SUPERVISION OF					REVIEW	JAR	ELECTRICAL PLAN	
21 W CHURCH ST. JACKSONVILLE, FLORIDA 32202		PE:					DRA	AFTING		GE2017
		LIC. NO.:					DATE	7/24/2018	ODEEN! AND ENERGY OF LITER CVAITOUNARD	DRAWING #: SHEET #:
		STATE:					ВҮ	RMS	GREENLAND ENERGY CENTER SWITCHYARD	05 of 11 5 of 5
ISSUED FOR BID		DATE:					REVIEW	JAR	SCALE: AS SHOWN SUBSTATION & TRANSMISSION ENGINEERING 8004817	05 0 11 5 0 5

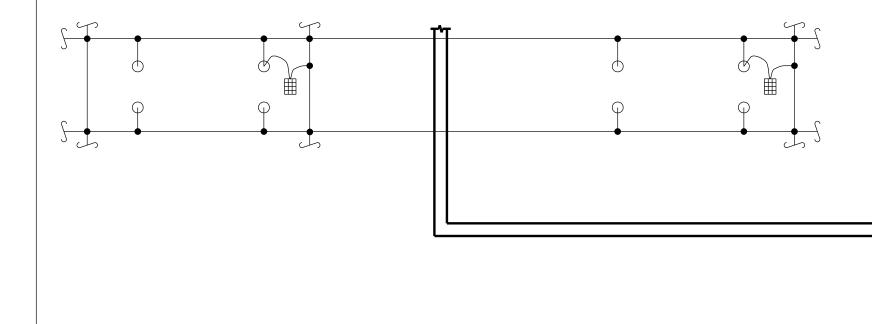

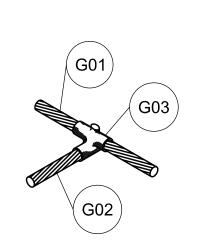

ITEM	QTY	DESCRIPTION	MANUFACTURER	Mfg. P/N	FURNISHED BY
G01	*	19#8 COPPERWELD, 40% CONDUCTIVITY, HIGH STRENGTH, SOFT ANNEALED	COPPERWELD		N/A
G02	*	7#5 COPPERWELD, 40% CONDUCTIVITY, HIGH STRENGTH, SOFT ANNEALED	COPPERWELD		CONTRACTOR
G03	*	WELDED GROUND CONNECTION, 19#8 CABLE MAIN TO 7#5 CABLE TAP, WITH WELD METAL (AS REQUIRED).	CADWELD/ERICO	TAC9G9E / 150PLUSF20	CONTRACTOR
* CC	NTRAC	TOR TO DETERMINE			

DETAIL D

DETAIL 01

TYPICAL BELOW GRADE CONNECTIONS

CONSTRUCTION NOTES:

1. NO ADDITIONAL MAIN GROUND GRID OR GROUND RODS REQUIRED. CONTRACTOR TO GROUND ALL STRUCTURES AND EQUIPMENT IN CLOUDED AREA.


LEGEND:

19#8 COPPERWELD CONDUCTOR FOR MAIN GRID
7#5 COPPERWELD CONDUCTOR FOR STRUCTURE & EQUIPMENT GROUNDING TO MAIN GRID

GROUND CONNECTOR


GROUND ROD

■ GROUND PLATFORM

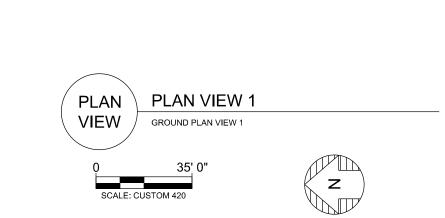

	CONSULTANT INFORMATION	PROFESSIONAL ENGINEER'S SEAL	REV DATE	PROJ#	REVISION DESCRIPTION	ву	REVIEW	ENGINEERING	GEC 230 kV BAY AND BREAKER ADDITION FOR CIRCUIT 909	DRAWING NAME:
	CONSCIANT IN CAMARION	ENGINEER'S SEAL		-	-	-	-	DATE 7/24/2018		GE2017-GP
		ORIGINALLY PREPARED UNDER THE RESPONSIBLE SUPERVISION OF		-	-	-	-	BY RMS		DRAWING SET:
BUILDING COMMUNITY		THE RESI CHOIDEE SOI ERVISION OF		-	-	-	-	REVIEW JAR	GROUNDING PLAN	GE201
21 W CHURCH ST. JACKSONVILLE, FLORIDA 32202		PE:		-	-	-	-	DRAFTING		GE201
		LIC. NO.:		-	-	-	-	DATE 7/24/2018	GREENLAND ENERGY CENTER SWITCHYARD	DRAWING #: SHEE
ISSUED FOR BID		STATE:		-	-	-	-	BY RMS SCALE:	PROJ#	06 of 11
1000ED 1 OIV BID		DATE:		-	-	-	-	REVIEW JAR AS SHOWN	SUBSTATION & TRANSMISSION ENGINEERING 8	004817

| P R | | | |

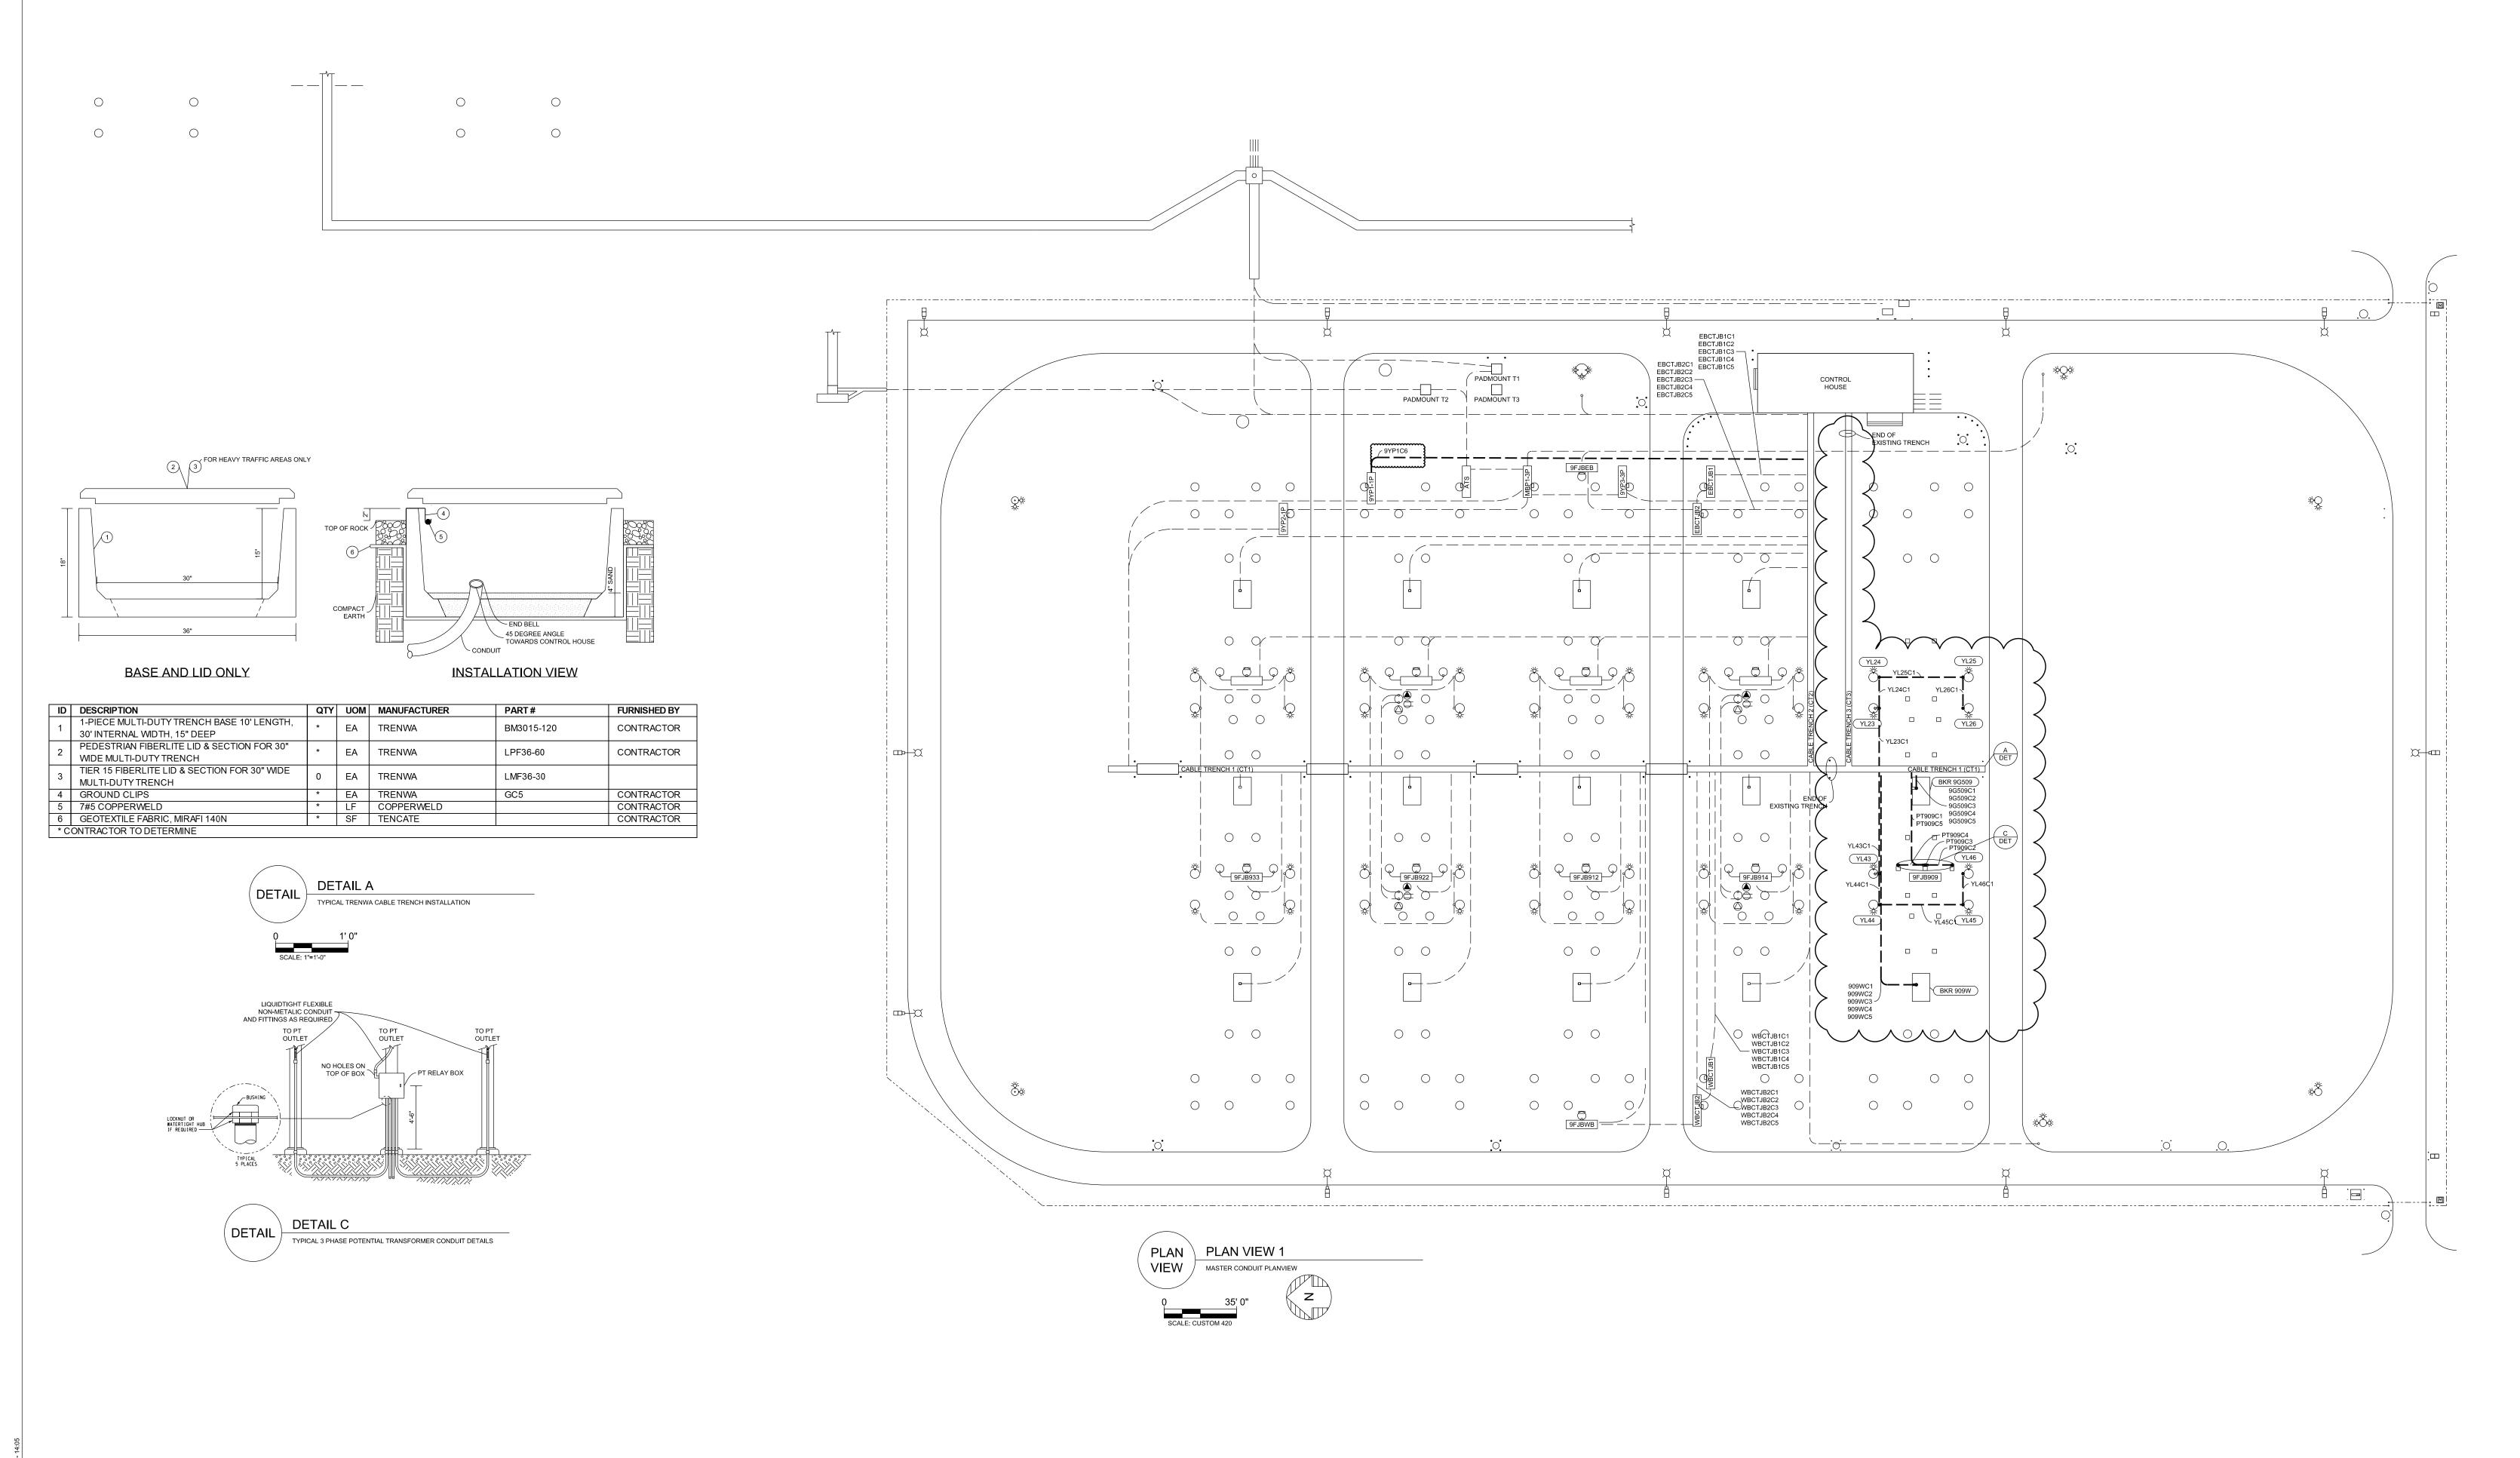

	CONSULTANT INFORMATION	PROFESSIONAL ENGINEER'S SEAL	REV DATE	PROJ#	REVISION DESCRIPTION	ВУ	REVIEW	ENGINEERING		GEC 230 kV BAY AND BREAKER ADDITION FOR CIRCUIT 909	DRAWING NAME:	
dgn 2/1		ENGINEER'S SEAL		-	-	-	-	DATE 11/14/2017			GE2017-CP.dgn	
		ORIGINALLY PREPARED UNDER THE RESPONSIBLE SUPERVISION OF		-	-	-	-	BY RMS			DRAWING SET:	
BUILDING COMMUNITY 21 W CHURCH ST		THE REST STROIGHE SST EXTRIBITION ST		-	-	-	-	REVIEW JAR		CONDUIT PLAN		
21 W CHURCH ST. JACKSONVILLE, FLORIDA 32202		PE:		-	-	-	-	DRAFTING			GE2017	
7.47.X		LIC. NO.:		-	-	-	-	DATE 11/14/2017		GREENLAND ENERGY CENTER SWITCHYARD	DRAWING #: SHEET #:	
ISSUED FOR BID		STATE:		-	-	-	-	BY RMS	SCALE:	P	PROJ#: 07 OF 11 1 OF 1	
TOOGLE TOTO TO THE PART OF THE		DATE:	DATE:		-	-	-		REVIEW JAR	AS SHOWN	SUBSTATION & TRANSMISSION ENGINEERING	8004817

CONDUIT NOTES:

- 1. THE CONTRACTOR SHALL BE RESPONSIBLE FOR ALL NECESSARY CONDUIT MATERIALS, INCLUDING FITTINGS.
- 2. THE CONTRACTOR SHALL BE RESPONSIBLE FOR VERIFICATION OF ALL CONDUIT LENGTHS. CONDUIT LENGTHS ARE APPROXIMATE.
- 3. CONTROL HOUSE CONDUIT EXPOSED RUNS SHALL BE EMT. CONTRACTOR MAY CONCEAL CONTROL HOUSE CONDUIT WITHIN BLOCK WALLS UNLESS STATED OTHERWISE IN THE DRAWINGS. CONTRACTOR SHALL NOT CONCEAL ALUMINUM CONDUIT RUNS.
- 4. ALL RUNS WITHIN BATTERY ROOM SHALL UTILIZE ALUMINUM CONDUIT. PENETRATIONS THROUGH THE BLOCK WALL SHALL UTILIZE PVC COATED ALUMINUM TO PROVIDE SUFFICIENT ALKALI CORROSION PROTECTION, WITH PENETRATION PROPERLY SEALED.

CONDUIT SCHEDULE

CONDUIT LEGEND:

UV RESISTANT PVC CONDUIT, SCH 40 FLEX FLEXIBLE UV RESISTANT PVC CONDUIT, SCH 40 EMT ELECTRICAL METALLIC TUBING

RMC RIGID METALLIC (GALVANIZED STEEL) CONDUIT IMC INTERMEDIATE METALLIC CONDUIT

LFMC LIQUID-TIGHT FLEXIBLE METALLIC CONDUIT

SQAURE WIREWAY ALUMINUM CONDUIT

ID	CONDUIT #	FROM	то	SIZE	TYPE	LENGTH (FT)	CABLES IN CONDUIT	REMARKS	DWG SET	REV
647	9G509C1	BREAKER 9G509	CABLE TRENCH 1	3	UV	15	9G509/C1, 9G509/909PR-1, 9G509/909SC-1, 9G509/EBD1		GE2017	
648	9G509C2	BREAKER 9G509	CABLE TRENCH 1	3	UV	15	9G509/C2, 9G509/909PR-2, 9G509/909SC-2, 9G509/EBD2		GE2017	
649	9G509C3	BREAKER 9G509	CABLE TRENCH 1	2	UV	15	9G509/AC		GE2017	
650	9G509C4	BREAKER 9G509	CABLE TRENCH 1	2	UV	15		SPARE	GE2017	
651	9G509C5	BREAKER 9G509	CABLE TRENCH 1	2	UV	15		SPARE	GE2017	
652	909WC1	BREAKER 909W	CABLE TRENCH 1	3	UV	125	909W/C1, 909W/909PR-1, 909W/909SC-1, 909W/WBD1		GE2017	
653	909WC2	BREAKER 909W	CABLE TRENCH 1	3	UV	125	909W/C2, 909W/909PR-2, 909W/909SC-2, 909W/WBD2		GE2017	
654	909WC3	BREAKER 909W	CABLE TRENCH 1	2	UV	125	909W/AC		GE2017	
655	909WC4	BREAKER 909W	CABLE TRENCH 1	2	UV	125		SPARE	GE2017	
656	909WC5	BREAKER 909W	CABLE TRENCH 1	2	UV	125		SPARE	GE2017	
657	PT909C1	230KV PTJB 9FJB909	CABLE TRENCH 1	2	UV	50	909PT1/JB, 909PT2/JB, 909PT/AC		GE2017	
658	PT909C2	230KV PTJB 9FJB909	909PT PH A	1.5	UV	15	909PT/A		GE2017	
659	PT909C3	230KV PTJB 9FJB909	909PT PH B	1.5	UV	5	909PT/B		GE2017	
660	PT909C4	230KV PTJB 9FJB909	909PT PH C	1.5	UV	15	909PT/C		GE2017	
661	PT909C5	230KV PTJB 9FJB909	CABLE TRENCH 1	2	UV	50		SPARE	GE2017	
	YL23C1	YARD LIGHT 23	CABLE TRENCH 1	1.5	UV	45	YL23/AC		GE2017	
663	YL24C1	YARD LIGHT 24	YARD LIGHT 23	1.5	UV	20	YL24/AC		GE2017	
664	YL25C2	YARD LIGHT 25	YARD LIGHT 24	1.5	UV	45	YL25/AC		GE2017	
665	YL26C2	YARD LIGHT 26	YARD LIGHT 25	1.5	UV	20	YL26/AC		GE2017	
666	YL43C1	YARD LIGHT 43	CABLE TRENCH 1	1.5	UV	55	YL43/AC		GE2017	
667	YL44C1	YARD LIGHT 44	YARD LIGHT 43	1.5	UV	20	YL44/AC		GE2017	
668	YL45C1	YARD LIGHT 45	YARD LIGHT 44	1.5	UV	45	YL45/AC		GE2017	
669	YL46C1	YARD LIGHT 46	YARD LIGHT 45	1.5	UV	20	YL46/AC		GE2017	
670	9YP1C6	YD PNL 9YP1-1P	CABLE TRENCH 2	3	UV	220	YL23/AC, YL43/AC, 909W/AC, 9G509/AC, 909PT/AC		GE2017	

	CONSULTANT INFORMATION	PROFESSIONAL		ATE PROJ#	REVISION E	REVISION DESCRIPTION		REVIEW	ENGIN	EERING		GEC 230 kV BAY AND BR
		ENGINEER'S SEAL	-		-		-	-	DATE	7/24/2018		
		ORIGINALLY PREPARED UNDER THE RESPONSIBLE SUPERVISION OF			-				вү	RMS		
BUILDING COMMUNITY 21 W CHURCH ST.			-		-		ı	-	REVIEW	JAR		CONDUI
JACKSONVILLE, FLORIDA 32202		PE:	-		-		-	-	DRAI	FTING		
		LIC. NO.:	-		-		-	-	DATE	7/24/2018	1	GREENLAND ENE
ISSUED FOR RID		STATE:	-		-		-	-	ВҮ	RMS	SCALE:	
1930ED FOR BID		DATE:	-		-		-	-	REVIEW	JAR	AS SHOWN	SUBSTATION & TR
ISSUED FOR BID		DATE:	-		-		-	-	BY REVIEW		SCALE: AS SHOWN	

BREAKER ADDITION FOR CIRCUIT 909 DUIT SCHEDULE

GE2017-CS.dgn GE2017

8004817

ENERGY CENTER SWITCHYARD & TRANSMISSION ENGINEERING

08 of 11 | 1 of 1

CABLE NOTES:

- TYPE B, BS, F, AND FO CABLE SHALL BE FURNISHED BY THE OWNER, UNLESS OTHERWISE SPECIFIED.
- 2. THE CONTRACTOR SHALL FURNISH ALL OTHER CABLE, AS SPECIFIED.
- 3. THE CONTRACTOR SHALL BE RESPONSIBLE FOR VERIFICATION OF ALL CABLE LENGTHS. CABLE LENGTHS ARE APPROXIMATE.

CABLE SCHEDULE

CABLE LEGEND:

A THHN INSULATED COPPER CONDUCTOR

B CONTROL CABLE

BS SHIELDED CONTROL CABLE

C RHW, THHW, OR THWN INSULATED COPPER CONDUCTOR

GE2017-CT.dgn

F INSTRUMENT CABLE FO FIBER OPTIC CABLE


M MULTIPLE CONDUCTOR

S SINGLE CONDUCTOR

CY CONTROL HOUSE CABLE TRAY
CT CONTROL HOUSE CABLE TRENCH

ID	CABLE#	FROM	то	VOLT (V)	SIZE	#C	S/M	TYPE	LENGTH (FT)	CONDUIT ROUTE	REMARKS	DWG SET	RE\
480 YL2	3/AC	YARD LIGHT 23	YARD PANEL 9YP1-1P	600	10	2	М	С	500	YL23C1, CT2, 9YP1C6		GE2017	+
181 YL2		YARD LIGHT 24	YARD LIGHT 23	600	10	2	S	C	50	YL24C1		GE2017	+
82 YL2		YARD LIGHT 25	YARD LIGHT 24	600	10	2	S	C	50	YL25C1		GE2017	+
83 YL2		YARD LIGHT 26	YARD LIGHT 25	600	10	2	S	C	50	YL26C1		GE2017	+
184 YL4		YARD LIGHT 43	YARD PANEL 9YP1-1P	600	10	2	M	C	500	YL43C1, CT2, 9YP1C6		GE2017	†
485 YL4		YARD LIGHT 44	YARD LIGHT 43	600	10	2	S	C	50	YL44C1		GE2017	†
186 YL4		YARD LIGHT 45	YARD LIGHT 44	600	10	2	S	C	50	YL45C1		GE2017	
187 YL4		YARD LIGHT 46	YARD LIGHT 45	600	10	2	S	С	50	YL46C1		GE2017	
188 9G5		BKR 9G509	230KV PNL 17	600	10	21	М	BS	250	9G509C1, CT1, CT3, TRAY	BKR 9G509 CONTROL	GE2017	1
89 9G5	609/C2	BKR 9G509	230KV PNL 17	600	10	21	М	BS	250	9G509C2, CT1, CT3, TRAY	BKR 9G509 CONTROL	GE2017	
90 9G5	609/909PR-1	BKR 9G509	230KV PNL 17	600	10	4	М	BS	250	9G509C1, CT1, CT3, TRAY	LINE 909 PRIMARY PROTECTION	GE2017	
191 9G5	609/909PR-2	BKR 9G509	230KV PNL 17	600	10	4	М	BS	250	9G509C2, CT1, CT3, TRAY	LINE 909 PRIMARY PROTECTION	GE2017	
192 9G5	609/909SC-1	BKR 9G509	230KV PNL 17	600	10	4	М	BS	250	9G509C1, CT1, CT3, TRAY	LINE 909 SECONDARY PROTECTION	GE2017	
493 9G5	609/909SC-2	BKR 9G509	230KV PNL 17	600	10	4	М	BS	250	9G509C2, CT1, CT3, TRAY	LINE 909 SECONDARY PROTECTION	GE2017	
494 9G5	09/EBD1	BKR 9G509	EBCTJB1	600	10	4	М	BS	275	9G509C1, CT1, EBCTJB1C3	230KV EAST BUS PRIMARY PROTECTION	GE2017	
495 9G5	609/EBD2	BKR 9G509	EBCTJB2	600	10	4	М	BS	275	9G509C2, CT1, EBCTJB2C3	230KV EAST BUS SECONDARY PROTECTION	GE2017	
496 9G5	609/AC	BKR 9G509	YARD PANEL 9YP1-1P	600	6	3	S	С	450	9G509C3, CT1, CT2. 9YP1C6	240VAC POWER	GE2017	
197 909		BKR 909W	230KV PNL 17	600	10	21	М	BS	350	909WC1, CT1, CT3, TRAY	BKR 909W CONTROL	GE2017	
198 909		BKR 909W	230KV PNL 17	600	10	21	M	BS	350	909WC2, CT1, CT3, TRAY	BKR 909W CONTROL	GE2017	
	W/909PR-1	BKR 909W	230KV PNL 17	600	10	4	М	BS	350	909WC1, CT1, CT3, TRAY	LINE 909 PRIMARY PROTECTION	GE2017	
909	W/909PR-2	BKR 909W	230KV PNL 17	600	10	4	M	BS	350	909WC2, CT1, CT3, TRAY	LINE 909 PRIMARY PROTECTION	GE2017	
501 909\	W/909SC-1	BKR 909W	230KV PNL 17	600	10	4	М	BS	350	909WC1, CT1, CT3	LINE 909 SECONDARY PROTECTION	GE2017	
502 909\	W/909SC-2	BKR 909W	230KV PNL 17	600	10	4	М	BS	350	909WC2, CT1, CT3	LINE 909 SECONDARY PROTECTION	GE2017	
503 909	W/WBD1	BKR 909W	WBCTJB1	600	10	4	М	BS	350	909WC1, CT1, WBCTJB1C3	230KV WEST BUS PRIMARY PROTECTION	GE2017	
	W/WBD2	BKR 909W	WBCTJB2	600	10	4	М	BS	350	909WC2, CT1, WBCTJB2C3	230KV WEST BUS SECONDARY PROTECTION	GE2017	
505 909		BKR 909W	YARD PANEL 9YP1-1P	600	6	3	S	С	550	909WC3, CT1. CT2, 9YP1C6	240VAC AC POWER	GE2017	
06 9091		LINE 909 PHASE "A" PT	909PTJB	600	10	8	М	BS	30	PT909C2	LINE 909 PT - PHASE "A"	GE2017	
07 9091		LINE 909 PHASE "B" PT	909PTJB	600	10	8	M	BS	20	PT909C3	LINE 909 PT - PHASE "B"	GE2017	
08 9091	PT/C	LINE 909 PHASE "C" PT	909PTJB	600	10	8	М	BS	30	PT909C4	LINE 909 PT - PHASE "C"	GE2017	
9091	PT1/JB	230KV PT FUSE JUNCTION BOX 909PTJB	230KV PNL 17	600	10	8	М	BS	300	PT909C1, CT1, CT3, TRAY	LINE 909 PT'S TO PNL 17	GE2017	
510 9091	PT2/JB	230KV PT FUSE JUNCTION BOX 909PTJB	230KV PNL 17	600	10	4	М	BS	300	PT909C1, CT1, CT3, TRAY	LINE 909 PT'S TO PNL 17	GE2017	
511 9091	PT/AC	230KV PT FUSE JUNCTION BOX 909PTJB	YARD PANEL 9YP1-1P	600	10	3	М	С	485	PT909C2, CT1, CT2, 9YP1C6	120VAC AC POWER	GE2017	

BUILDING COMMUNITY 21 W CHURCH ST. JACKSONVILLE, FLORIDA 32202	CONSULTANT INFORMATION	PROFESSIONAL	REV DATE PROJ# REVISION DESCRIPTION		ROJ#	REVISION DESCRIPTION BY	REVIEW ENGINEERING			GEC 230 kV BAY AND BREAKER ADDITION FOR CIRCUIT 909
		ENGINEER'S SEAL		-		·	-	DA	Γ E 7/24/20	018
		ORIGINALLY PREPARED UNDER THE RESPONSIBLE SUPERVISION OF		-	- -	· ·	-	В	r RMS	
				-	- -	· ·	-	REVI	EW JAR	CABLE SCHEDULE
		PE:		-		·	-		DRAFTING	
X X		LIC. NO.:		-		-	-	DA	ΓE 7/24/20 ⁻	GREENLAND ENERGY CENTER SWITCHYARD
ISSUED FOR BID		DATE:		-		-	-	В	RMS	S
				-		-	-	REVI	EW JAR	AS SHOWN SUBSTATION & TRANSMISSION ENGINEERING 8004

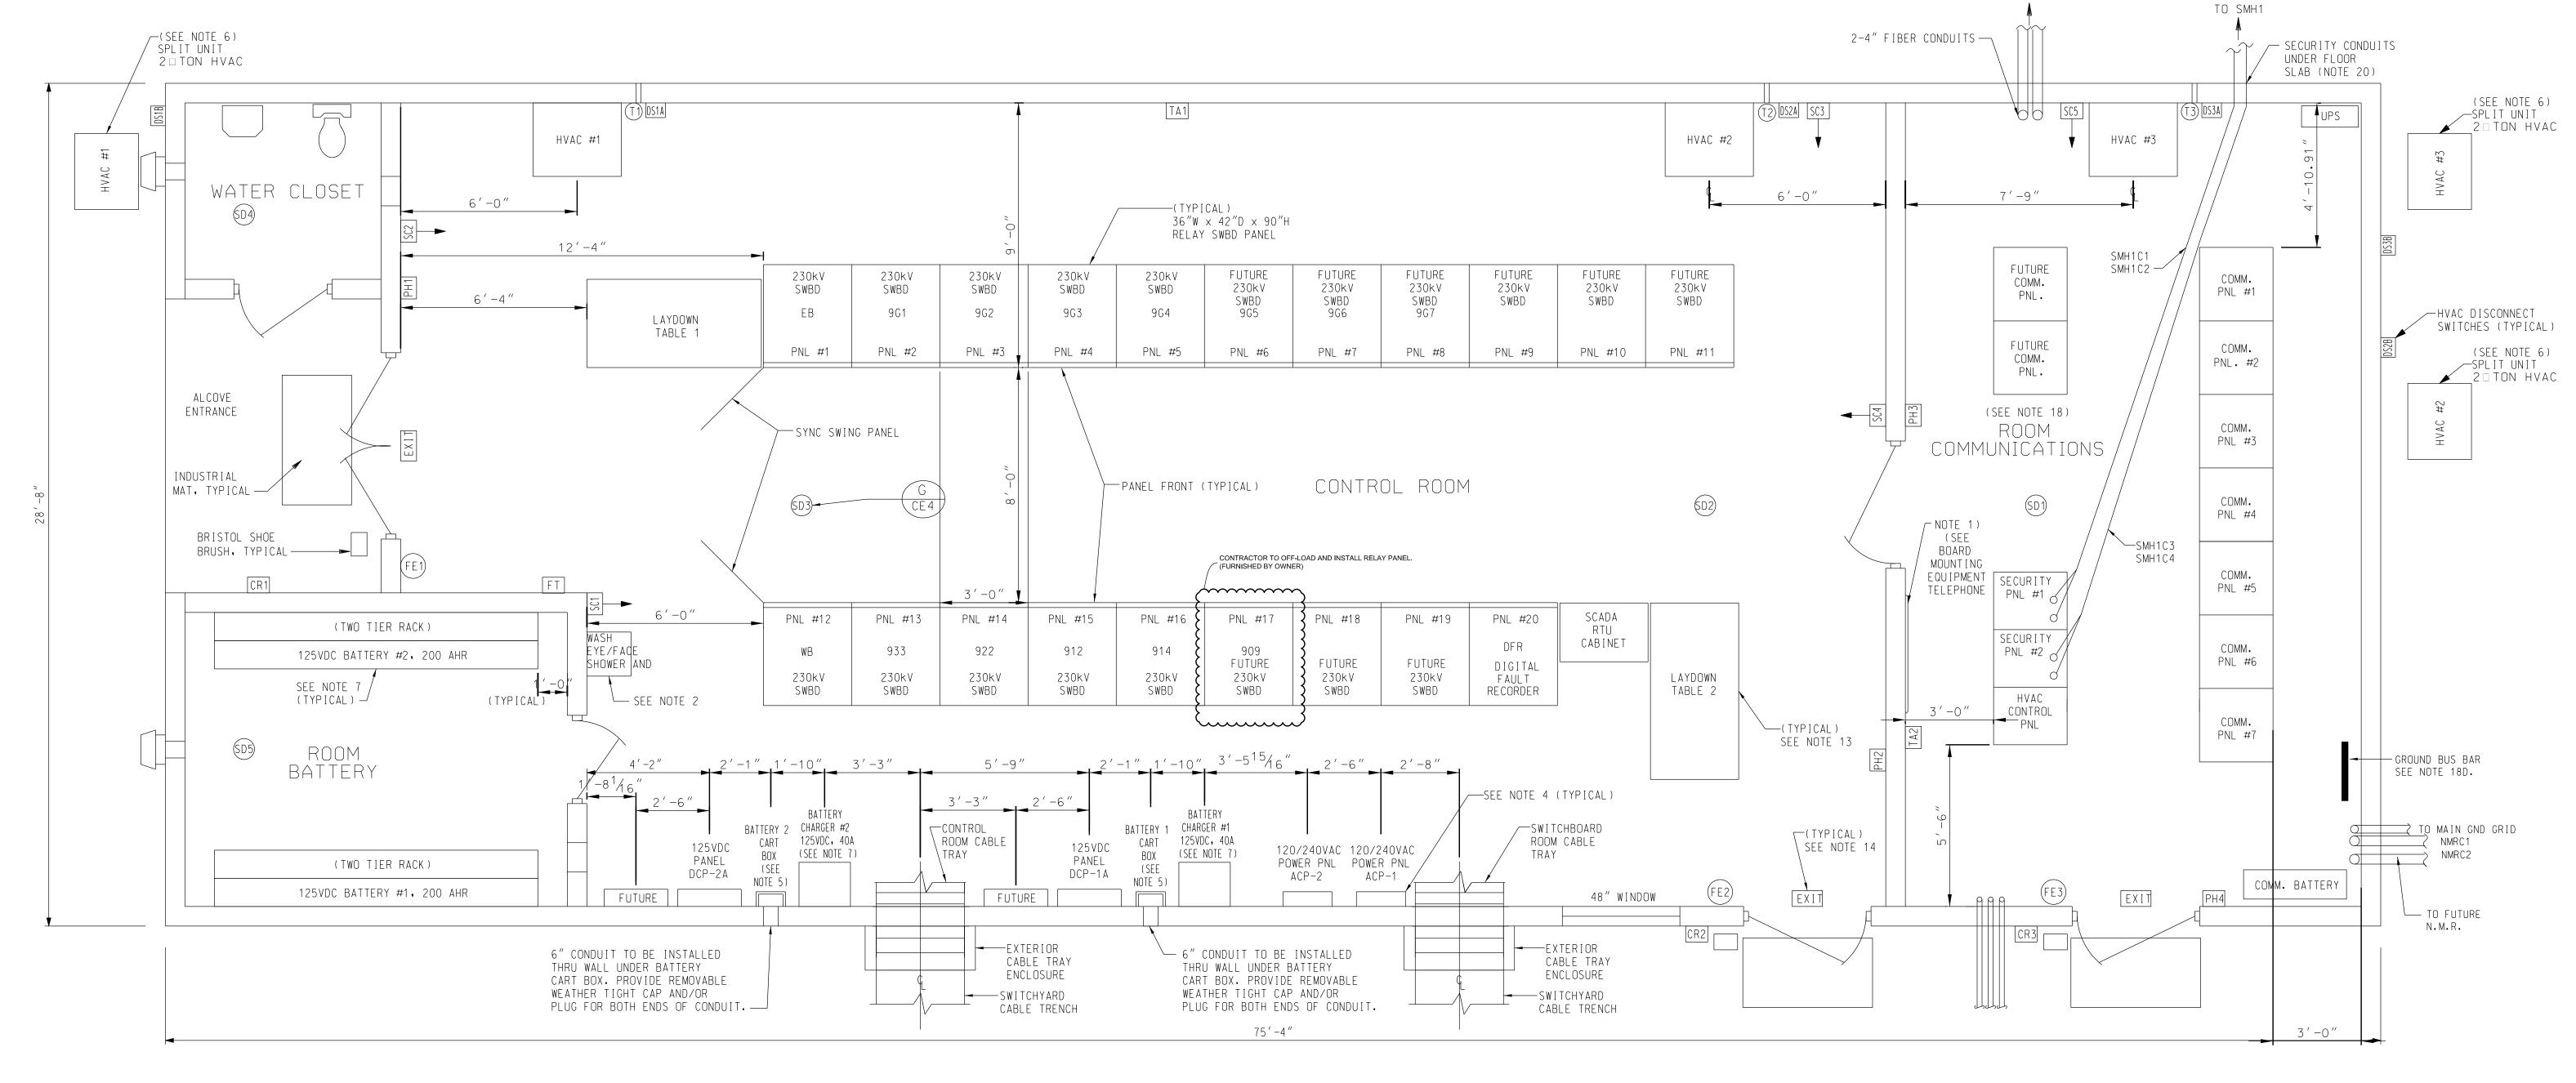

NOTES

- 1. CONTRACTOR SHALL FURNISH AND INSTALL TWO 3' X 30"X PLYWOOD TELEPHONE EQUIPMENT MOUNTING BOARDS IN THE LOCATIONS SHOWN ON THIS DRAWING. THE TOP OF THE TELEPHONE BOARDS SHALL BE MOUNTED 6'-0" ABOVE THE FINISHED FLOOR.
 - A. PAINT EACH TELEPHONE BOARD WITH FIRE RETARDANT PAINT. FINISH COLOR TO BE WHITE.

 B. ATTACH 48" X 48" X TELEPHONE BOARD TO WALL IN COMMUNICATIONS ROOM WITH TOP 6'-0" ABOVE THE FINISHED FLOOR.
- 2. CONTRACTOR SHALL FURNISH AND INSTALL ONE EYE/FACE WASH UNIT (WALL MOUNTED), SPEAKMAN MODEL NO. SE-603.
- 3. CONTRACTOR SHALL FURNISH AND INSTALL TWO TEMPERATURE ALARM THERMOSTATS AT LOCATIONS SHOWN ON THIS DRAWING. THE THERMOSTATS SHALL HAVE TEMPERATURE RANGE FROM 50°F TO 90°F, WITH AN ADJUSTABLE TEMPERATURE DIFFERENTIAL OF 3°F TO 30°F, AND AN ALARM CONTACT RATED 0.5 AMPERE, 125 VDC. THERMOSTATS SHALL BE JOHNSON CONTROLS A72AA-3 OR ACCEPTABLE EQUAL. THERMOSTATS SHALL BE MOUNTED ON WALL 4'-6" ABOVE FINISHED FLOOR.
- 4. CONTRACTOR SHALL FURNISH AND INSTALL ALL AC AND DC STATION SERVICE POWER PANELS AT THE LOCATIONS SHOWN ON THIS DRAWING. THE TOP OF THE AC AND DC POWER PANELS SHALL BE MOUNTED 6'-6" ABOVE FINISHED FLOOR. THE AC AND DC POWER PANELS SHALL BE IN ACCORDANCE WITH DRAWING GE102LV1 AND THE SPECIFICATIIONS.
- 5. CONTRACTOR SHALL FURNISH AND INSTALL THE BATTERY CART BOXES (QTY 2) IN ACCORDANCE WITH DETAIL J. DRAWING GE102CE5. THE TOP OF THE BATTERY CART BOX SHALL BE 4'-0" ABOVE FINISHED FLOOR.
- 6. THE CONTRACTOR SHALL FURNISH AND INSTALL TWO TOON SPLIT UNIT HVAC UNITS, COMPLETE WITH THERMOSTAT

 AND DUCT WORK IN THE CONTROL ROOM ALSO, THE CONTRACTOR SHALL FURNISH AND INSTALL ONIEDNO SPLIT HVAC UNITS, COMPLETE WITH THERMOSTAT UNGONTRACTOR—FURNISHED LEGAL FILES AND TWO (2) OF THE FOUR (4) ASSEMBLED SHEET—FILE PLAN CENTERS SHALL COMPLETE WITH THERMOSTAT AND DUCT WORK IN THE COMMUNICATIONS ROOM. THE CONTRACTOR SHALL FURNISH AND

 INSTALL INTERIOR AND EXTERIOR HVAC DISCONNECT SWITCHES, SEE DETAIL G, DRAWING GE102CE5. THE CONTRACTOR

 SHALL BE PLACED AT LOCATIONS DETERMINED BY THE JEA PROJECT REPRESENTATIVE..

 SHALL BE PLACED AT LOCATIONS DETERMINED BY THE JEA PROJECT REPRESENTATIVE..

- 7. THE OWNER WILL FURNISH TWO (2), 125VDC BATTERIES, RACKS AND CHARGERS, PICKUP AND TRANSPORTATION TO THE SITE BY THE CONTRACTOR, INSTALLATION OF THE BATTERY CHARGERS WITH ASSEMBLY AND INSTALLATION OF BATTERIES AND RACKS BY MANUFACTURER.
- 8. THE OWNER WILL FURNISH THE 230KV SWITCHBOARD PANELS AND SCADA RTU CABINET. THE RELAY PANELS SHALL BE DELIVERED TO THE JOB SITE BY THE RELAY PANEL MANUFACTURER. CONTRACTOR SHALL UNLOAD THEM FROM THE TRUCK AND INSTALL THEM PER THESE PLANS AND DRAWINGS. INSTALLATION SHALL INCLUDE ANCHORING THE EQUIPMENT TO THE CONTROL BUILDING FLOOR AND CONNECTING THE PANELS/CABINETS TO THE CABLE TRAY GROUND CONDUCTOR.
- 9. THE CARD READERS, SECURITY CAMERAS AND SECURITY PANELS WILL BE FURNISHED AND INSTALLED BY THE OWNER.
- 10. THE COMMUNICATIONS AND NETWORK PANELS WILL BE FURNISHED AND INSTALLED BY THE OWNER.
- 11. SEE DRAWING GE102CP2 AND DRAWING GE102CP3 FOR CONTINUATION OF CONDUIT RUNS.
- 12. TOP OF CONTRACTOR FURNISHED AND INSTALLED DRY SODA TYPE FIRE EXTINGUISHER SHALL NOT EXCEED 5'-0" ABOVE FINISHED FLOOR, BOTTOM OF FIRE EXTINGUISHER SHALL NOT BE LOWER THAN 6" ABOVE FINISHED FLOOR.
- 13. THE CONTRACTOR SHALL FURNISH TWO (2) 3' x 6' LAYDOWN TABLES, BOISE OFFICE FURNITURE #E8UTM3672WPCHR.
 THE CONTRACTOR SHALL ALSO FURNISH AND INSTALL, IN A LOCATION APPROVED BY THE PROJECT REPRESENTATIVE,
 FOUR (4) EACH SHEET-FILE PLAN CENTERS, OFFICE MAX #20092150, FOUR (4) EACH SHEET HANGING CLAMP (2
 CARTONS OF 6), OFFICE MAX #20092189, ONE (1) EACH HON STEEL STORAGE CABINET WITH 5 ADJUSTABLE
 SHELVES, 7134"H X 36"W X 2414"D, LIGHT GRAY, OFFICE DEPOT ITEM # 989780, AND FOUR (4) LEGAL FILE 530
 SERIES FOUR-DRAWER, OFFICE MAX #20555061, OR APPROVED EQUAL. TWO (2) OF THE FOUR (4)

 AC UNGONTRACTOR-FURNISHED LEGAL FILES AND TWO (2) OF THE FOUR (4) ASSEMBLED SHEET-FILE PLAN CENTERS SHALL
 BE DELIVERED BY THE CONTRACTOR TO THE JEA DOCUMENT CENTER IN JACKSONVILLE, FL. THE REMAINING ITEMS
 SHALL BE PLACED AT LOCATIONS DETERMINED BY THE JEA PROJECT REPRESENTATIVE..

- 14. CONTRACTOR SHALL FURNISH AND INSTALL EXIT SIGN OVER EVERY EXIT DOOR, LIGHTWORLD MODEL L-XR-EM WITH BATTERY BACKUP, PUSH TO TEST AND OPERATES ON 120VAC.
- 15. THE CONTRACTOR TO COORDINATE LOCATIONS OF TELEPHONES WITH JEA PROJECT REPRESENTATIVE. APPROXIMATE LOCATIONS ARE INDICATED. RACEWAY AND WALL MOUNT BOXES FURNISHED AND INSTALLED BY THE CONTRACTOR. JEA WILL FURNISH AND INSTALL CABLES AND TELEPHONE HANDSETS.
- 16. THE CONTRACTOR SHALL INSTALL A MINIMUM OF 4-4" AND 8-2" CONDUITS IN CONTROL HOUSE FLOOR WITH CONNECTIONS TO RACEWAY EXTERNAL TO THE CONTROL HOUSE. LOCATION OF THESE CONDUITS SHALL BE COORDINATED WITH JEA PROJECT REPRESENTATIVE.
- 17. SCADA RTU FURNISHED BY JEA FOR TRANSPORTATION TO THE SITE, INSTALLATION AND CONNECTION BY THE CONTRACTOR, INSTALLATION SHALL INCLUDE ANCHORING THE EQUIPMENT TO THE CONTROL HOUSE FLOOR AND CONNECTING TO THE CABLE TRAY GROUND CONDUCTOR.
- 18. COMMUNICATIONS ROOM:

 A. FLOOR IN COMMUNICATIONS ROOM SHALL BE FINISHED BUT NOT SEALED. JEA SHALL FURNISH AND
 - INSTALL PAINT FOR THE COMMUNICATIONS ROOM FLOOR
 - B. THE CONTRACTOR SHALL COORDINATE SCHEDULE OF WORK IN THE COMMUNICATIONS ROOM WITH JEA.

 C. PANELS, BATTERY AND CABLE TRAY IN COMMUNICATIONS ROOM FURNISHED AND INSTALLED BY JEA.

 D. THE CONTRACTOR SHALL FURNISH AND INSTALL A GROUND BUS BAR ON THE COMMUNICATIONS ROOM

 WALL AS SHOWN. THIS GROUND BUS SHALL BE 4" X 60" COPPER

 BAR WITH CONNECTION TO THE CABLE TRAY GROUND AT A SINGLE POINT. GROUND BUS SHALL BE MOUNTED
- 19. THE CONTRACTOR SHALL FURNISH AND INSTALL FIVE (5) SMOKE DETECTORS GE MODEL 350CX IN THE LOCATIONS SHOWN ON THIS DRAWING. MOUNT SMOKE DECTECTOR ELECTRICAL BOX TO NEAREST UNOBSTRUCTED CEILING JOIST.

ON INSULATORS WITH DRILLING AND TAPPING AS DIRECTED BY JEA.


20. CONTRACTOR TO FURNISH AND INSTALL FOUR (4) 2" SCH. 40 PVC CONDUITS FROM SECURITY MANHOLE SMH1 TO SECURITY PANELS 1 & 2 AS SHOWN ON THIS DRAWING. STUB UP THROUGH FLOOR IN LOCATION SHOWN.

LEGEND:


TO FOMH1

- CR CARD READER (FURNISHED & INSTALLED BY JEA)
- DS HVAC ELECTRICAL DISCONNECT SWITCH
- (FE) FIRE EXTINGUISHER (SEE NOTE 12)
- PH WALLMOUNT/ TELEPHONE HANDSET (SEE NOTE 15)
- SC SECURITY CAMERA (FURNISHED & INSTALLED BY JEA)
- (SD) SMOKE DETECTOR (FURNISHED & INSTALLED BY CONTRACTOR)
- (T) HVAC UNIT THERMOSTAT (FURNISHED & INSTALLED BY JEA)
- TA TEMPERATURE ALARM THERMOSTAT (FURNISHED & INSTALLED BY JEA)


- FT INTERMATIC FAN TIMER MODEL T1975 (FURNISHED AND INSTALLED BY CONTRACTOR)

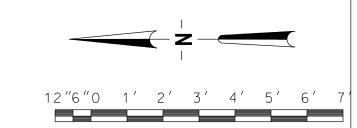

	CONSULTANT INFORMATION	PROFESSIONAL	REV DATE PRO	#	REVISION DESCRIPTION	BY REVI	W ENGINEERING		GEC 230 kV BAY AND BREAKER ADDITION FOR CIRCUIT 909	DRAWING NAME:
	CONSULTANT INFORMATION	ENGINEER'S SEAL		-			DATE 7/24/2018]		GE2017-CE.dgn
		ORIGINALLY PREPARED UNDER THE RESPONSIBLE SUPERVISION OF		-			BY RMS			DRAWING SET:
BUILDING COMMUNITY 21 W CHURCH ST.				-			REVIEW JAR		CONTROL HOUSE ELECTRICAL	GE2017
21 W CHURCH ST. JACKSONVILLE, FLORIDA 32202		PE:		-			DRAFTING]		GLZ017
		LIC. NO.:		-			DATE 7/24/2018	_	GREENLAND ENERGY CENTER SWITCHYARD	DRAWING #: SHEET #:
ISSUED FOR BID		DATE:		-			BY RMS	SCALE:	PROJ#:	10 of 11 1 of 1
.00023 . 0. (515	DA	DATE:		_			REVIEW JAR	AS SHOWN	SUBSTATION & TRANSMISSION ENGINEERING 8	004817

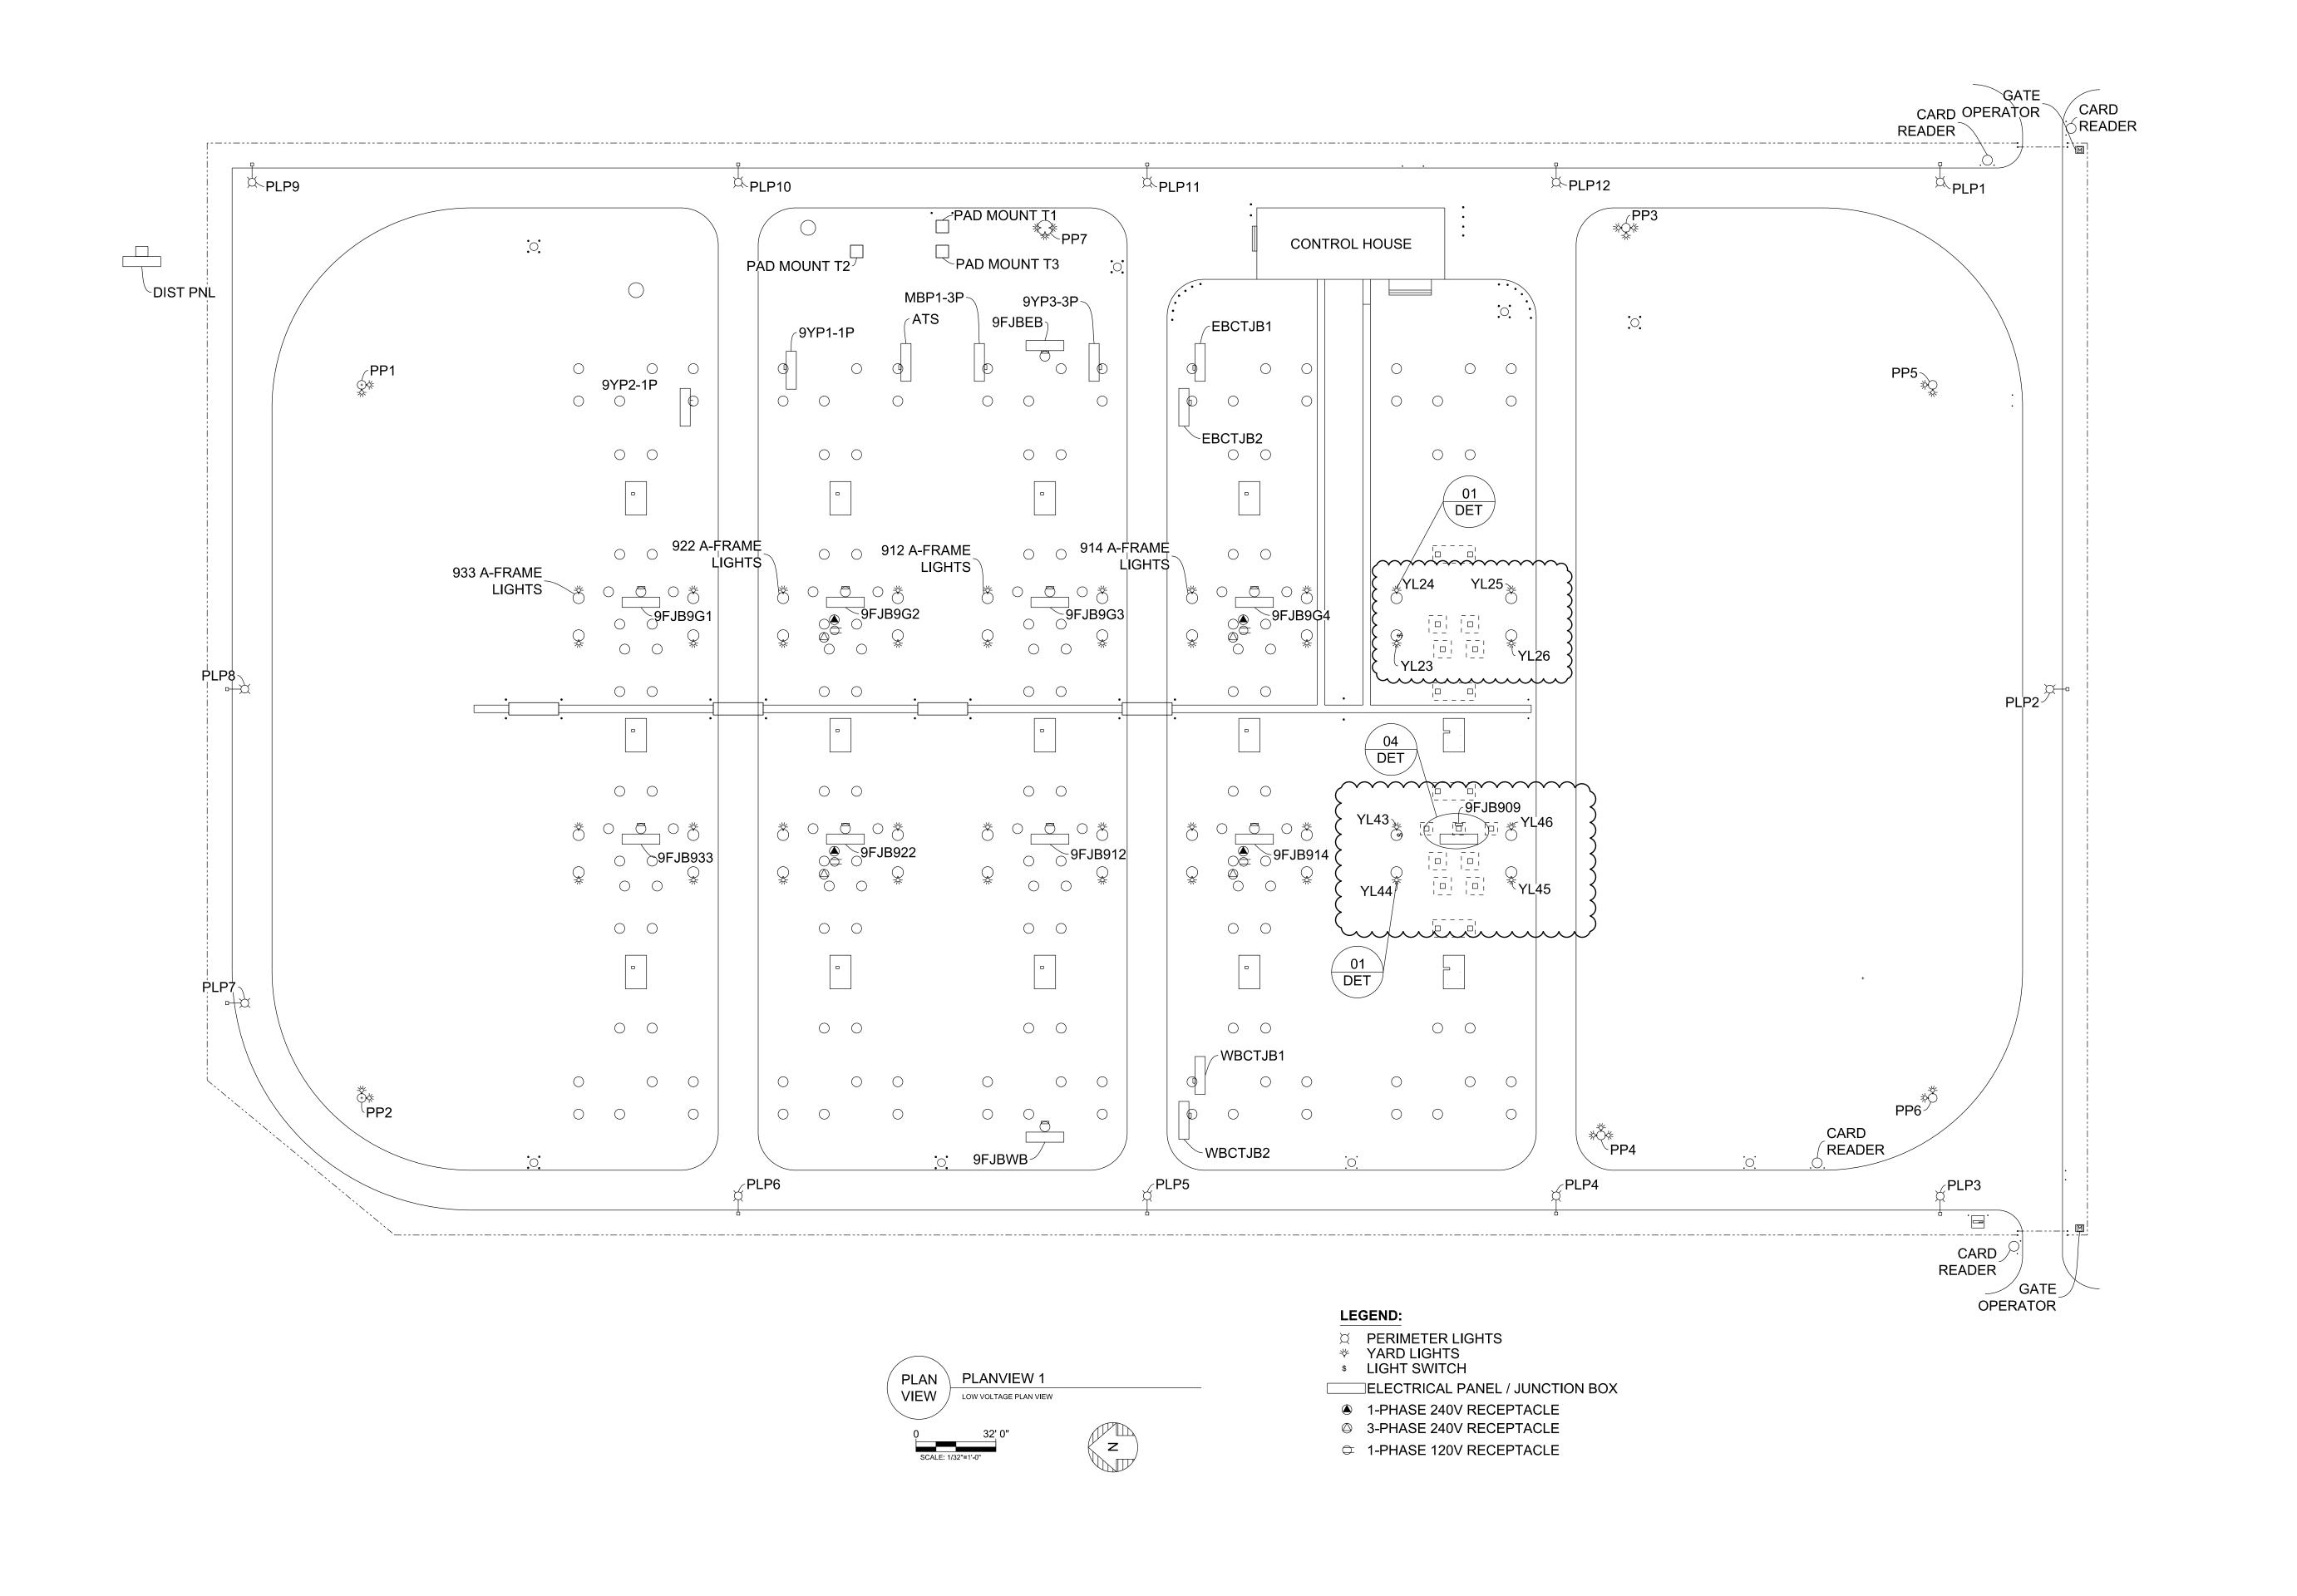


REV DATE GEC 230 kV BAY AND BREAKER ADDITION FOR CIRCUIT 909 PROJ# REVISION DESCRIPTION REVIEW PROFESSIONAL ENGINEER'S SEAL CONSULTANT INFORMATION GE2017-LV.dgn **DATE** 7/24/2018 ORIGINALLY PREPARED UNDER THE RESPONSIBLE SUPERVISION OF LOW VOLTAGE REVIEW JAR GE2017 21 W CHURCH ST. JACKSONVILLE, FLORIDA 32202 DRAFTING DATE 7/24/2018 DRAWING #: GREENLAND ENERGY CENTER SWITCHYARD RMS ISSUED FOR BID 11 of 11 | 1 of 3 ^{**} 8004817 SUBSTATION & TRANSMISSION ENGINEERING AS SHOWN REVIEW

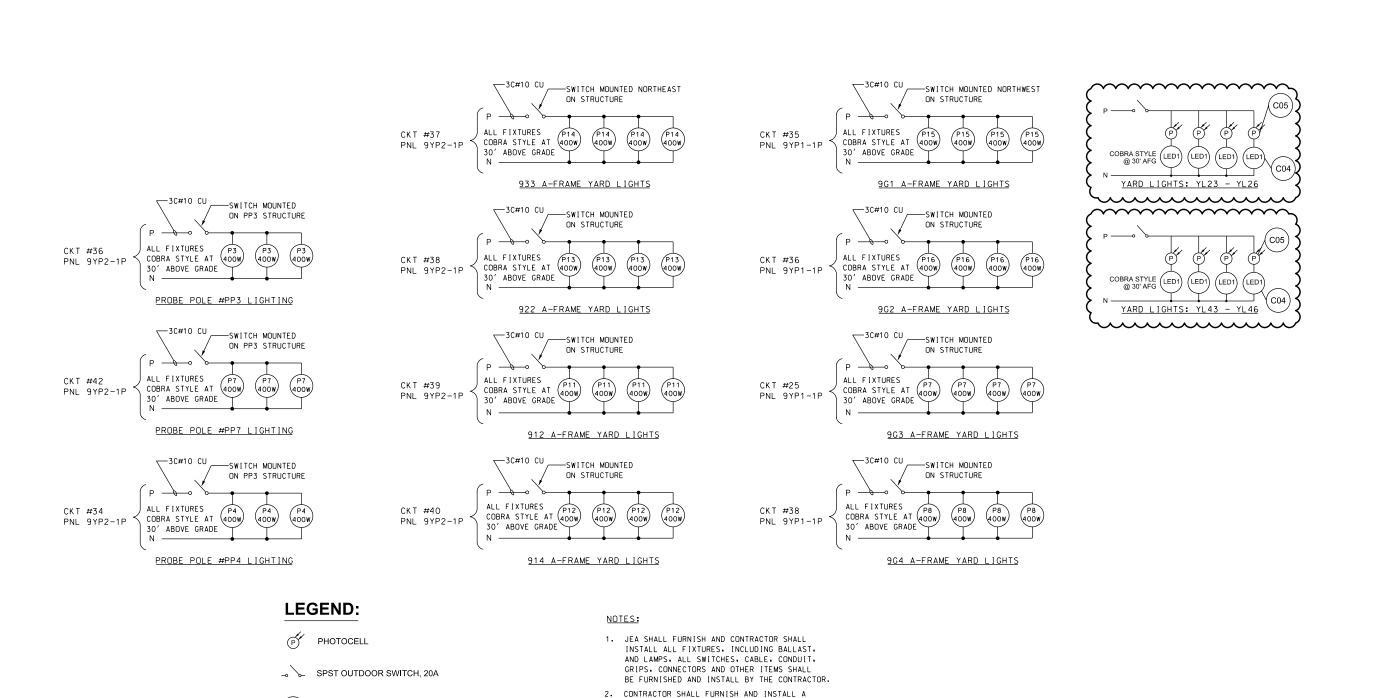

DURABLE LABEL OR ENGRAVING ONTO THE SWITCH FACEPLATE THAT LISTS THE PANEL NAME AND CIRCUIT NUMBER FOR EACH LIGHT CIRCUIT.



(LED1) LUMINAIRE, LED

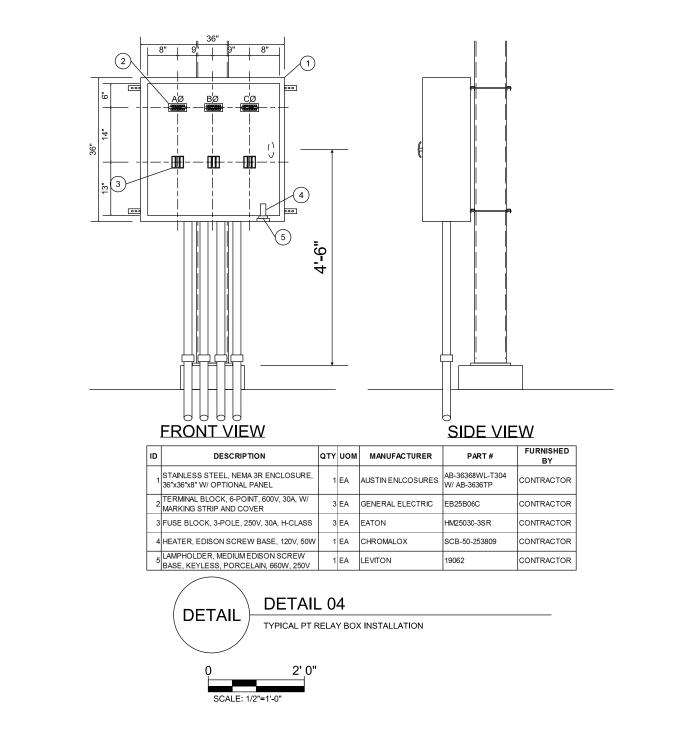

	CONSULTANT INFORMATION	PROFESSIONAL	REV DATE PROJ#	REVISION DESCRIPTION	ву	REVIEW	ENGINEERING		GEC 230 kV BAY AND BREAKER ADDITION FOR CIRCUIT 909		DRAWING NAME:
		ENGINEER'S SEAL		-	·	-	DATE 7/24/2018				GE2017-LV.dgn
BUILDING COMMUNITY 21 W CHURCH ST. JACKSONVILLE, FLORIDA 32202		ORIGINALLY PREPARED UNDER THE RESPONSIBLE SUPERVISION OF		-	-	-	BY RMS			DRAWING SET:	DRAWING SET:
				REVIEW JAR	LOW VOLTAGE		GE2017				
		PE:		-	-	-	DRAFTING				GE2017
		LIC. NO.:		-	-	-	DATE 7/24/2018		GREENLAND ENERGY CENTER SWITCHYARD		DRAWING #: SHEET #:
ISSUED FOR BID		STATE:		-	-	-	BY RMS	SCALE:	PRC	J #:	11 OF 11 2 OF 3
1000ED 1 OIX BID		DATE:		-	-	-	REVIEW JAR	AS SHOWN	SUBSTATION & TRANSMISSION ENGINEERING	8004817	

