
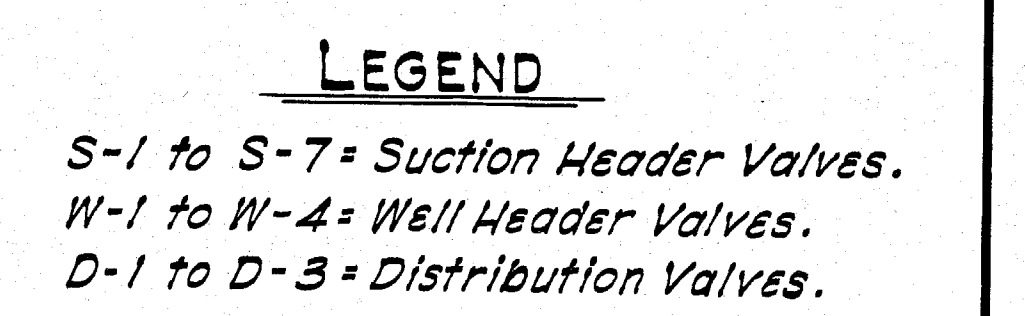


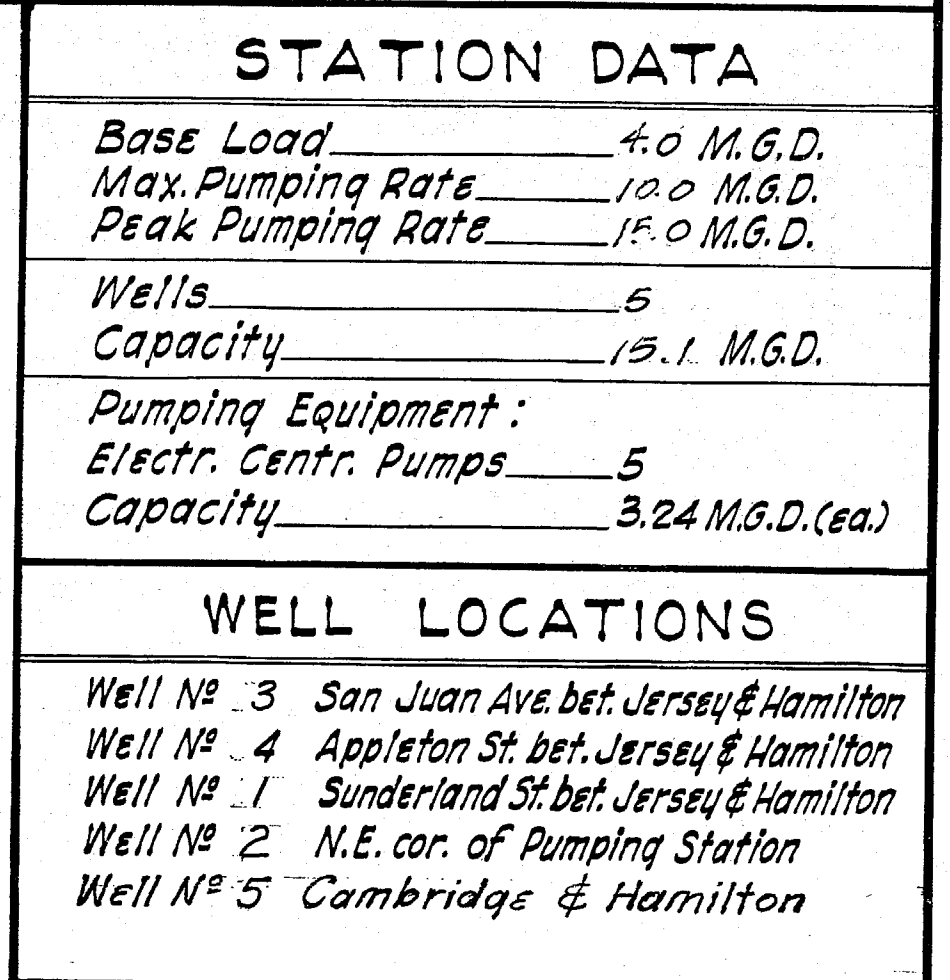

ELECTRIC & WATER ENGINEERING DEPT. CITY OF JACKSONVILLE, FLORIDA			
REVISIONS		DRAWING NO. <u>606K</u>	
DATE BY	DATE	SCALE: <u>None</u>	SECTION HEAD
APR. 24 '70	SUBMITTED	DATE: <u>JAN 28, 1988</u>	APPROVED: <u>[Signature]</u>
9:15 P.M.			ENGINEER
12/72 S.L.	ASST. CHIEF ENGINEER		
	ACCEPTED:	APPROVED:	
	<u>[Signature]</u>	<u>[Signature]</u>	
	SUPT. WATER DEPT.	ENGINEER MANAGER	
W.C.	SHEET NO.	DRAWING NO.	