


House
7913

Driveway



you have 16'
from first line
to back of
ESM.

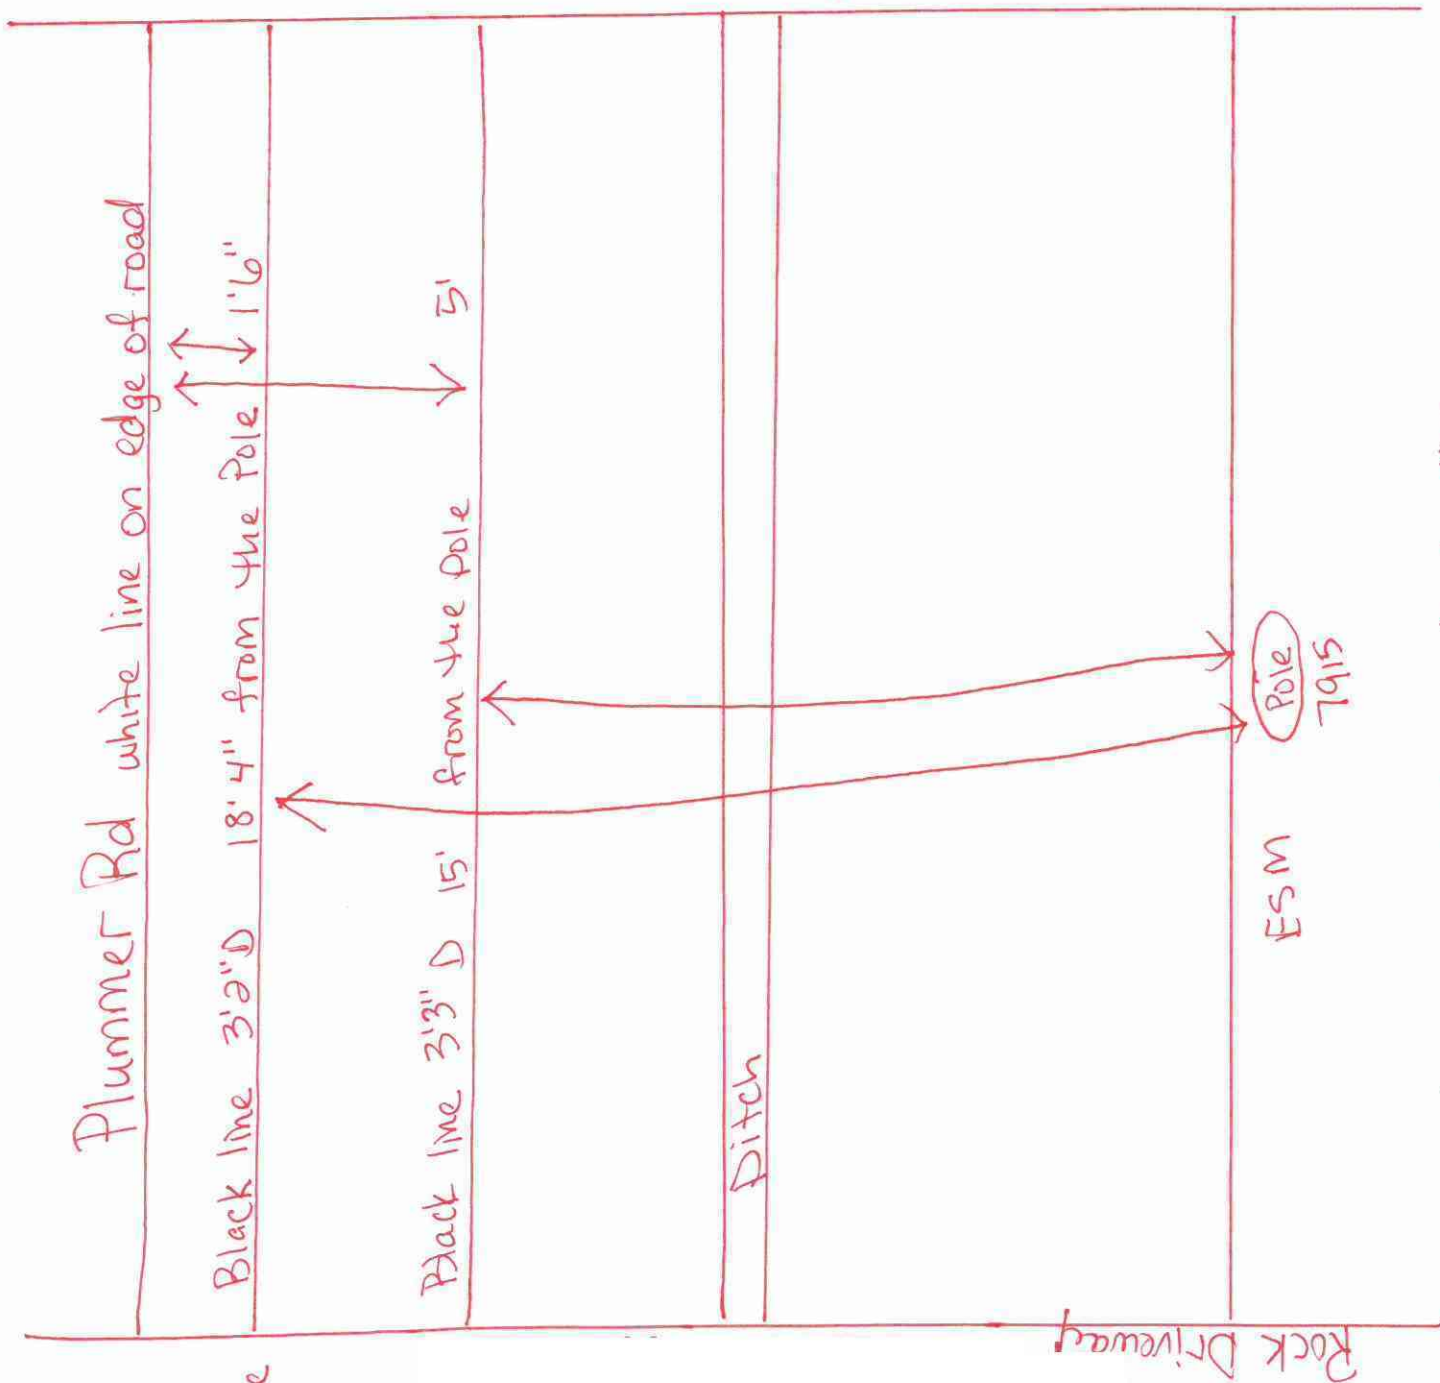

Overhead lines go right over dig location.

Station 04

B5012


Heart Utilities of Jax Project as Built

CA# B5012
Project # 31523701
Complete 6/19/25

House
8049



Project Manager

Plummer Road

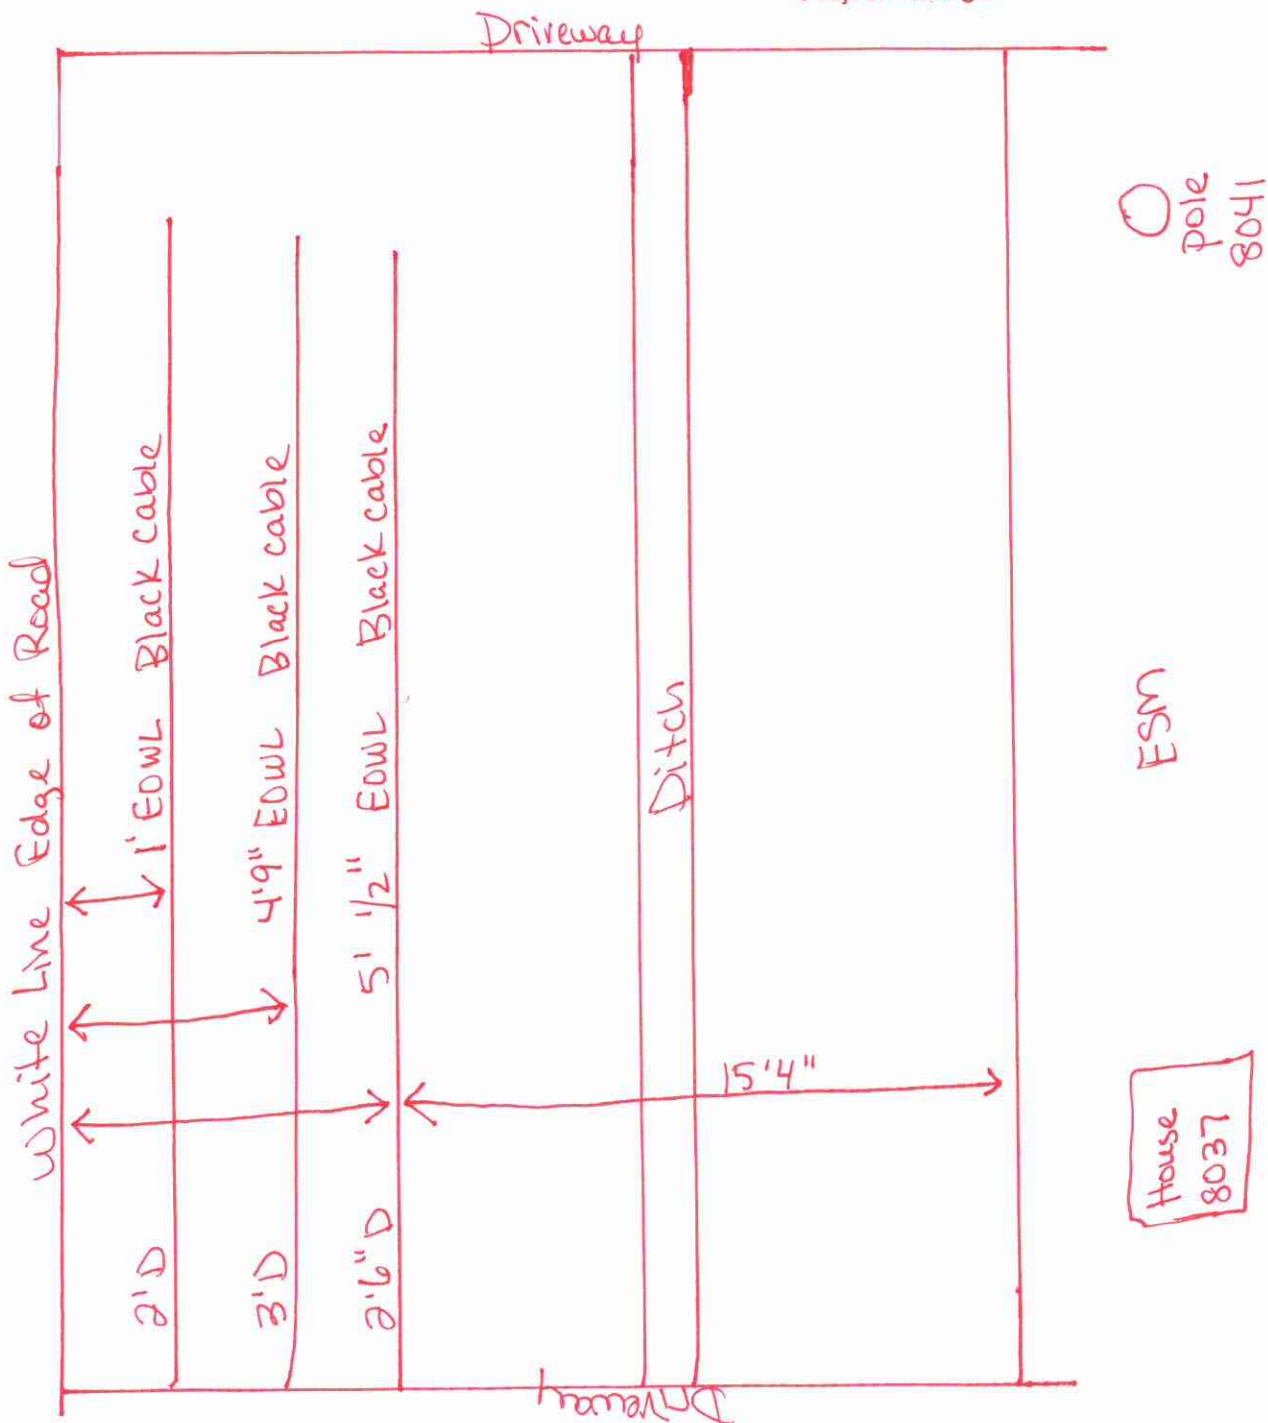


N
↑
S
E

B5012

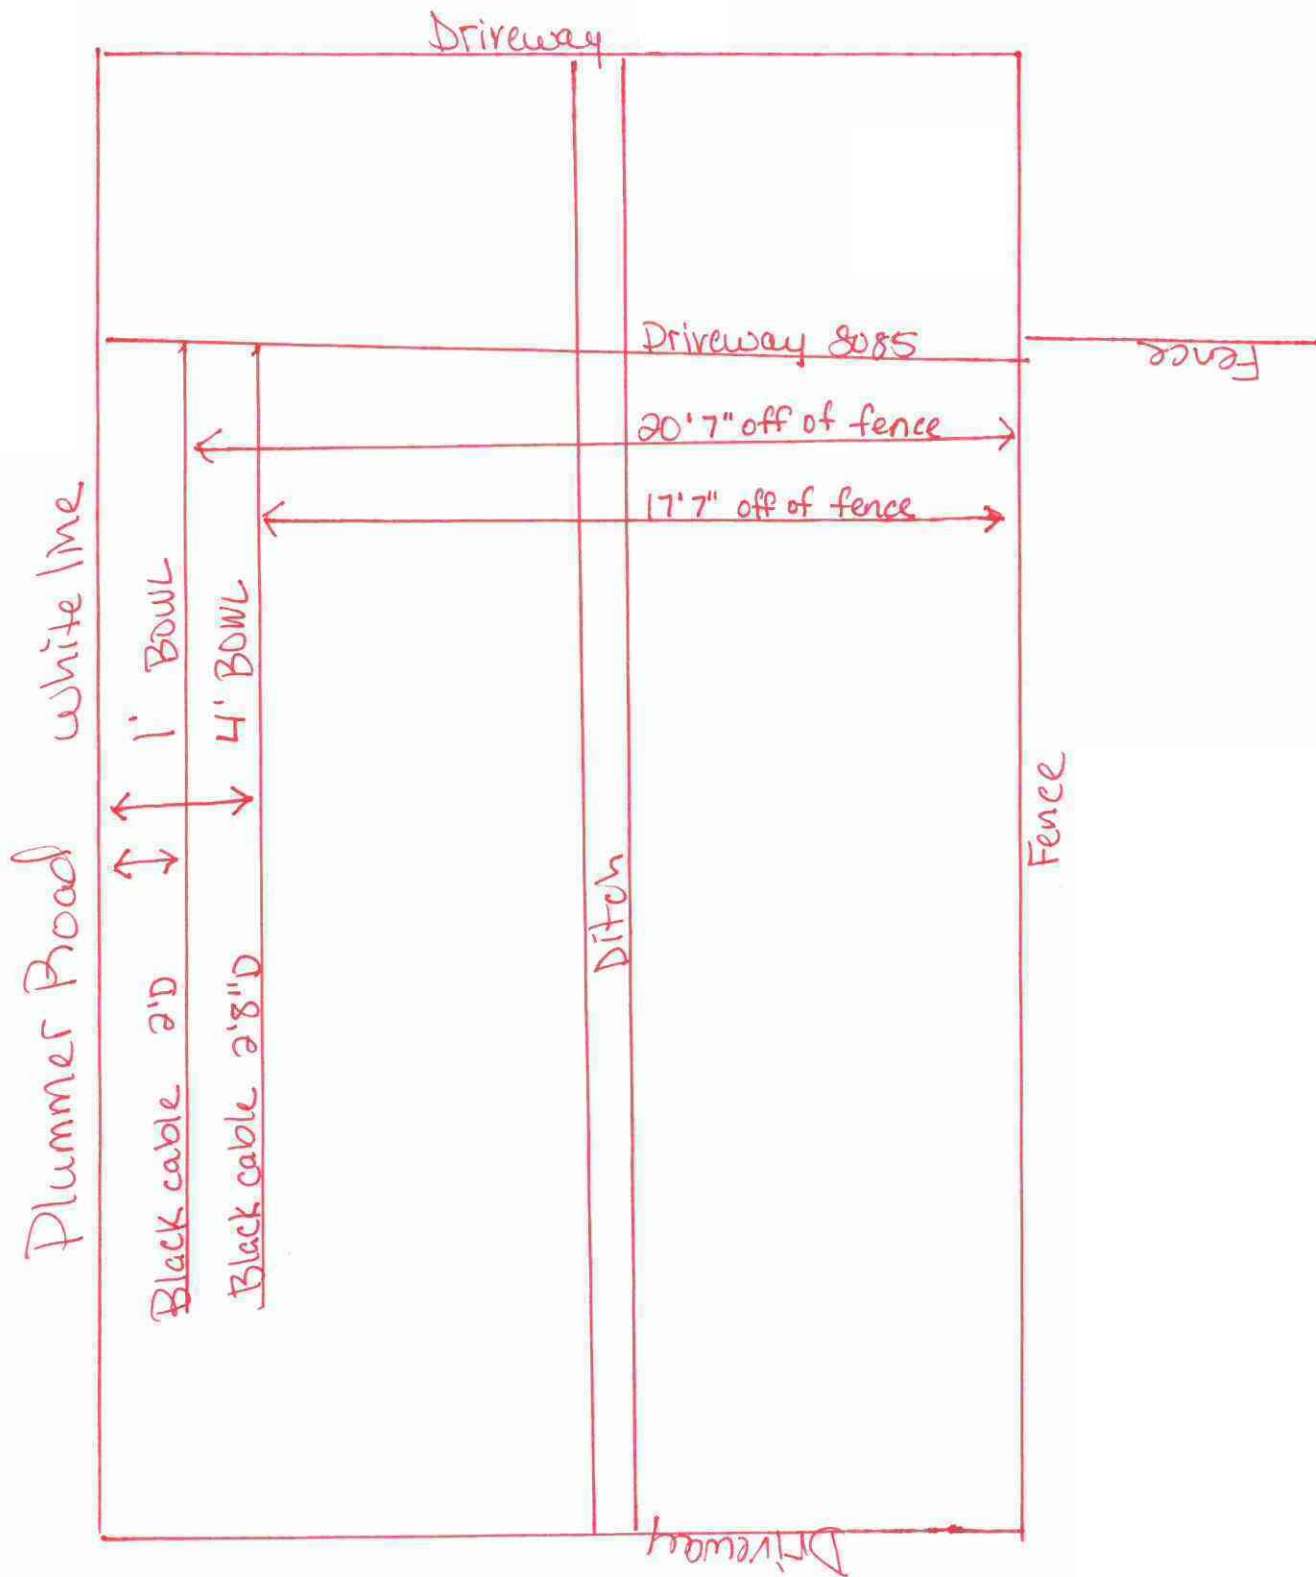


B5012

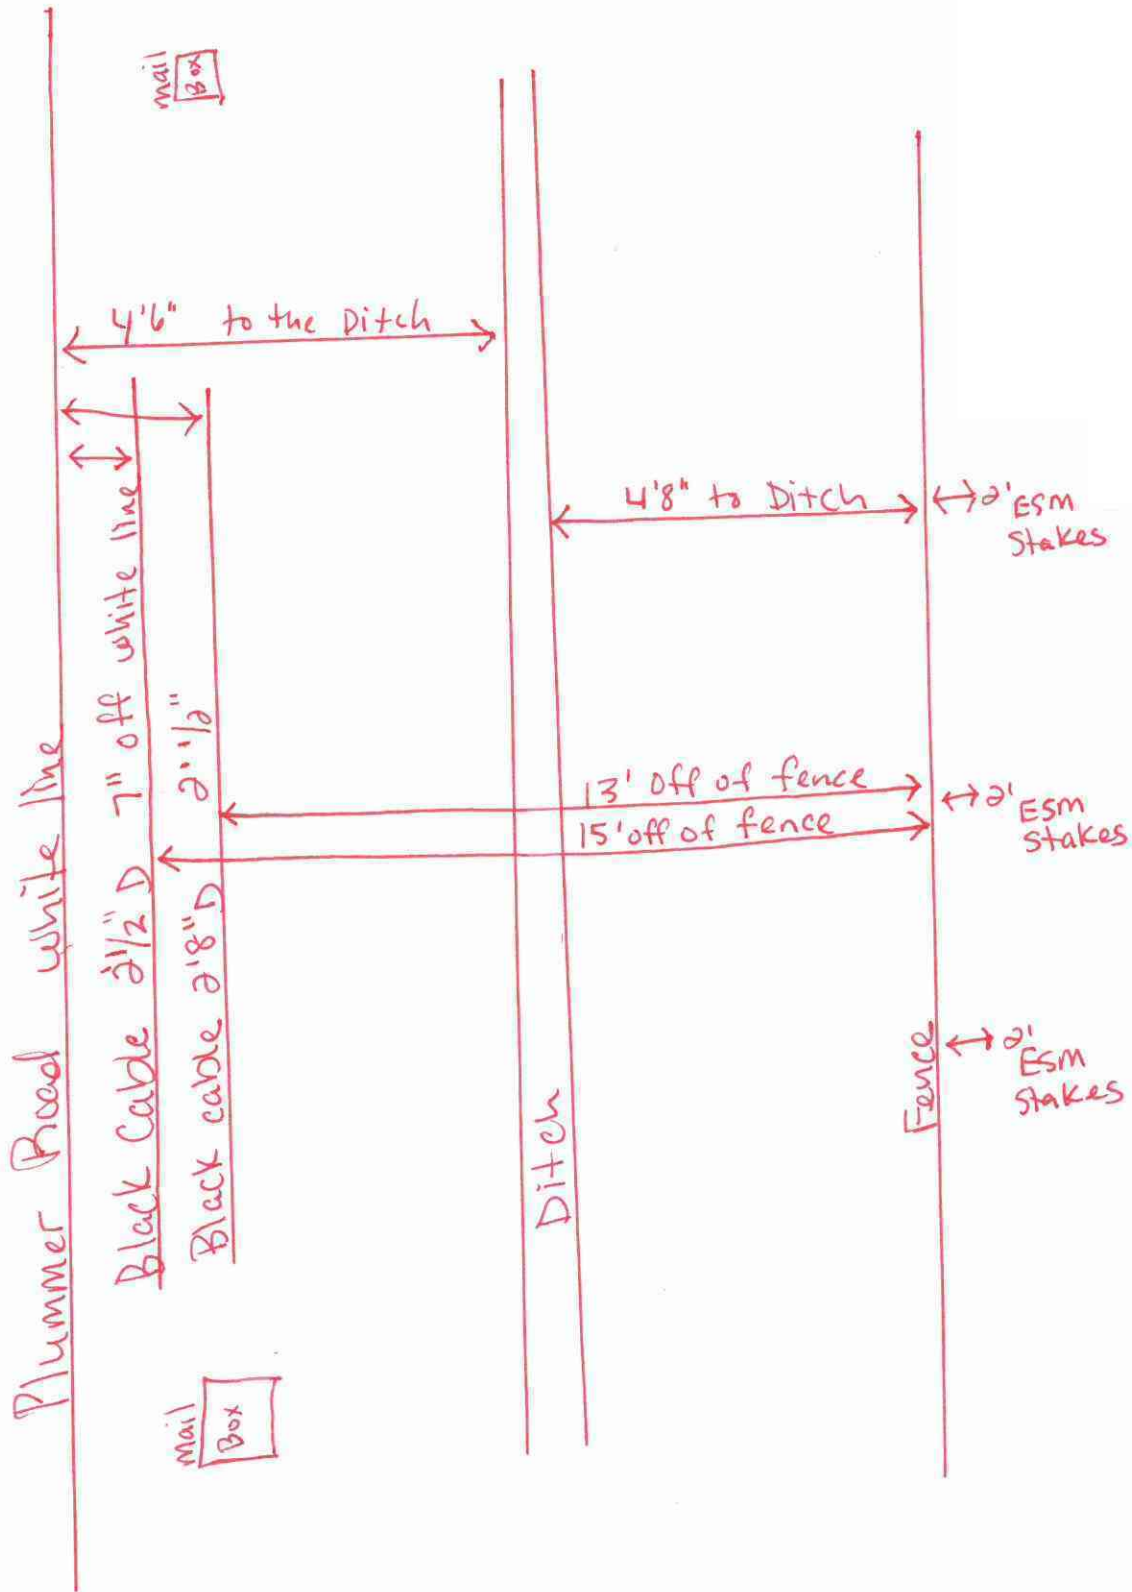

W
N
S
E


B5012

N
W
E
S

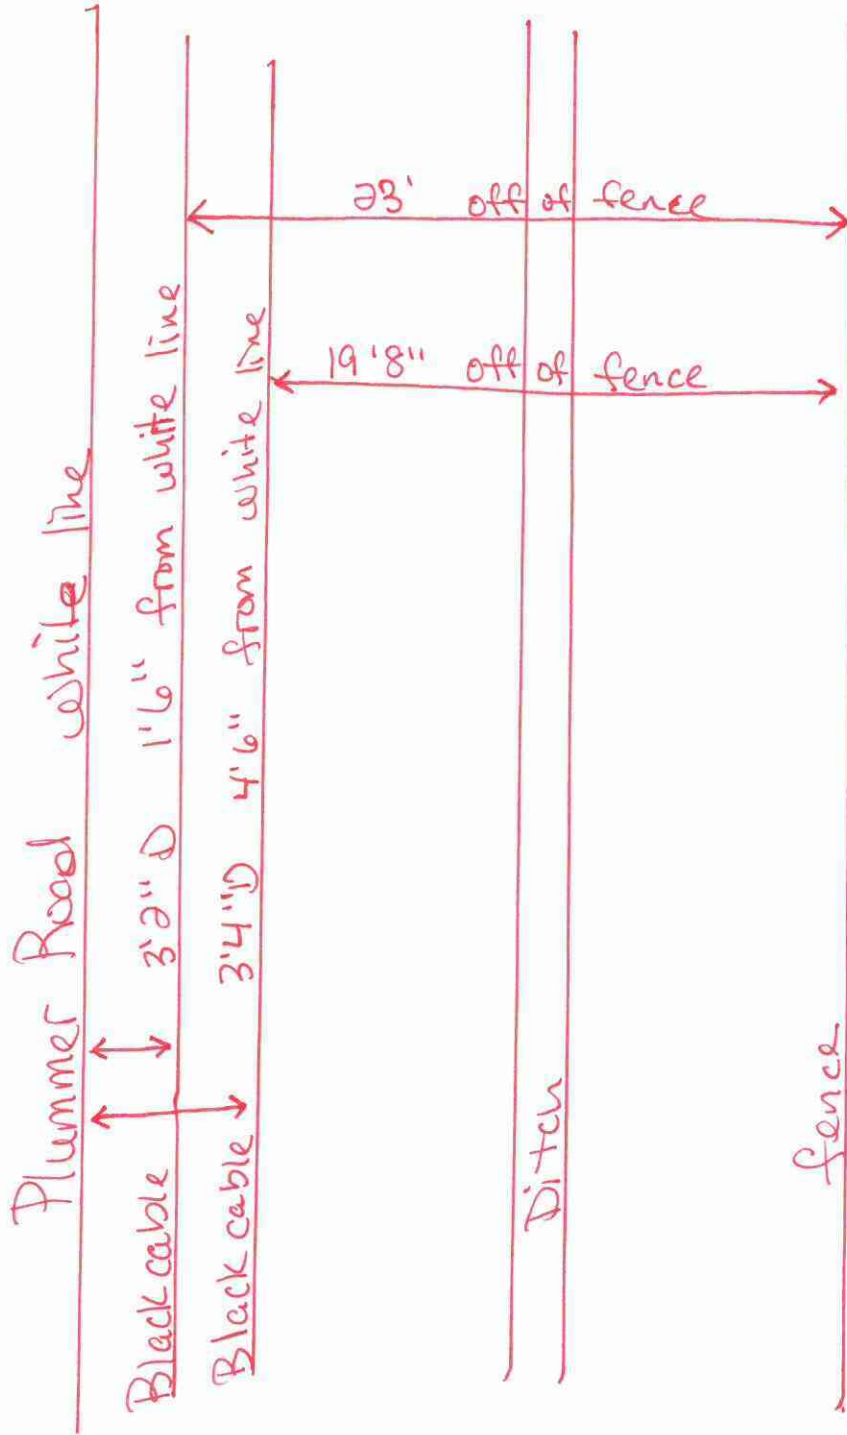

N
E
S

(Ble)

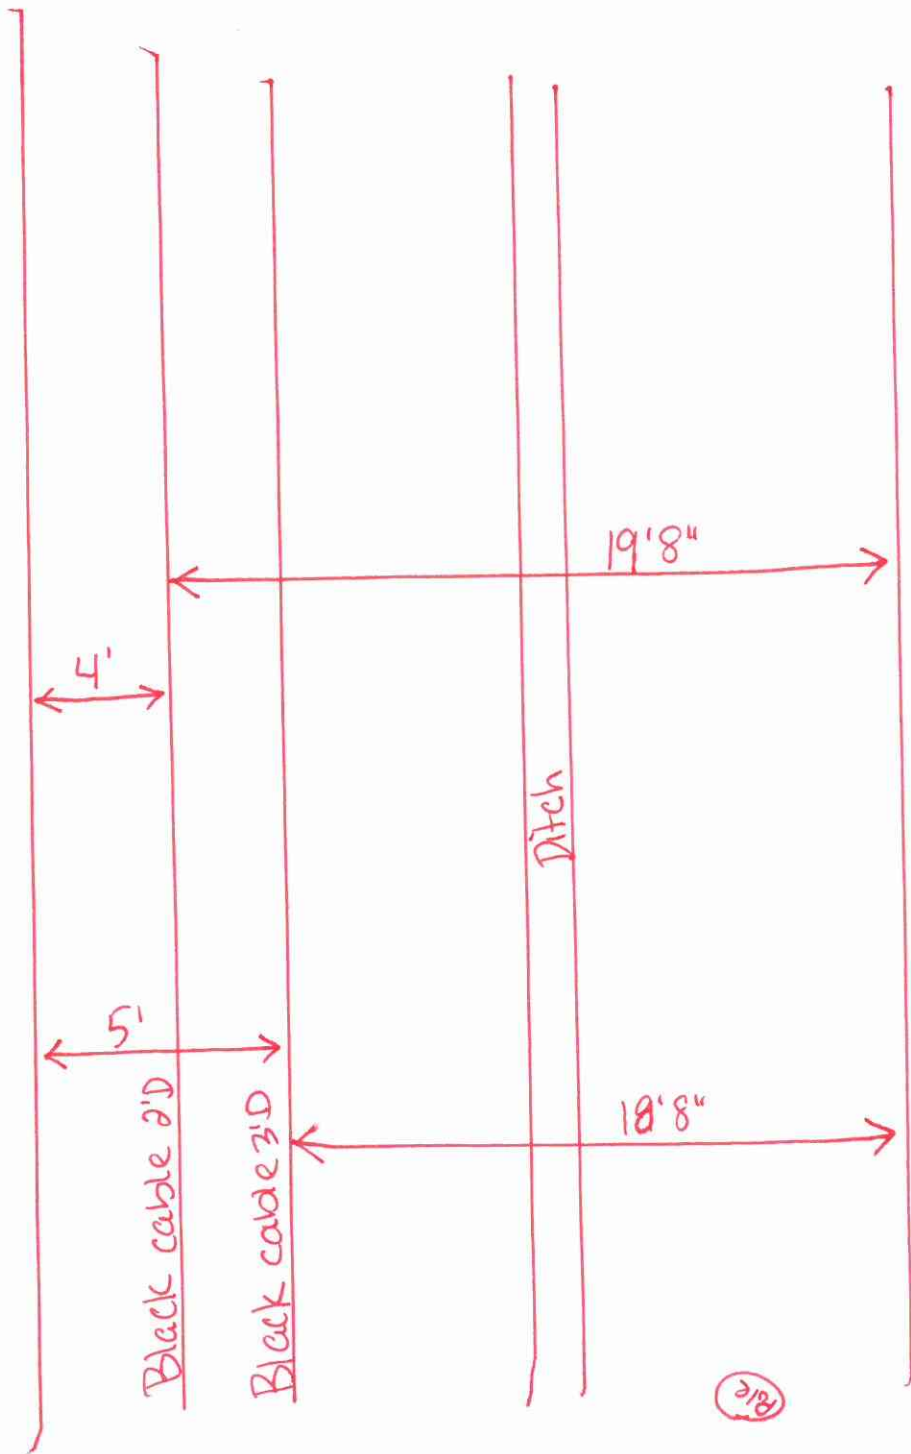

(Ble)

Heart Utilities of Jax

Project as Built

CA# B5012


Project # 31523701

Complete 6/19/25


[Signature]

Project Manager

BSD12

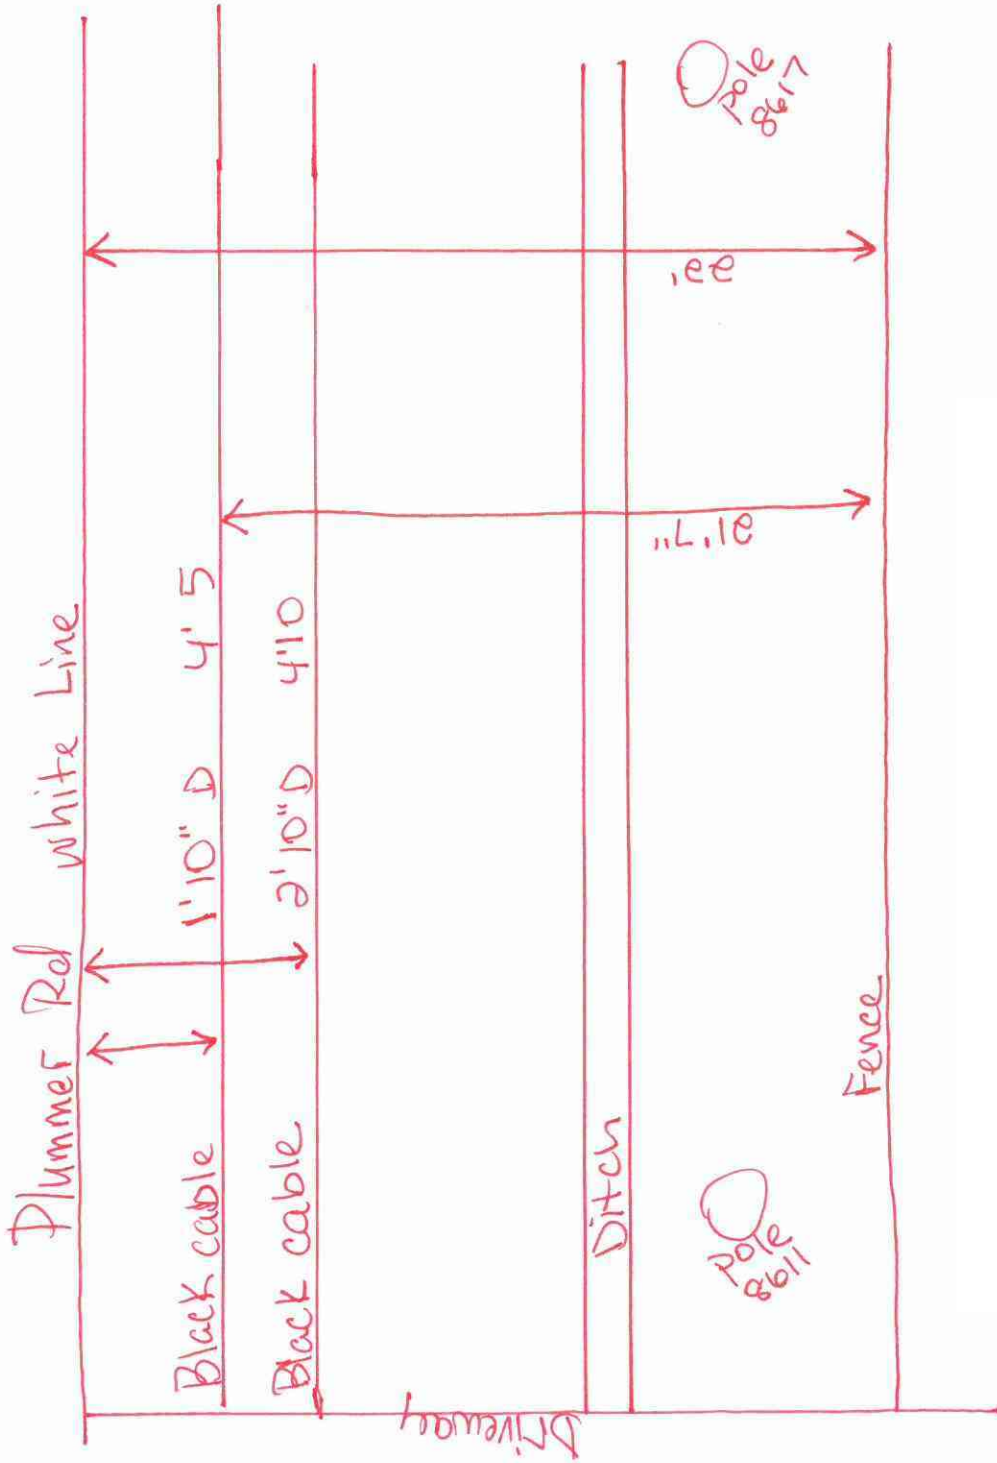


B5012

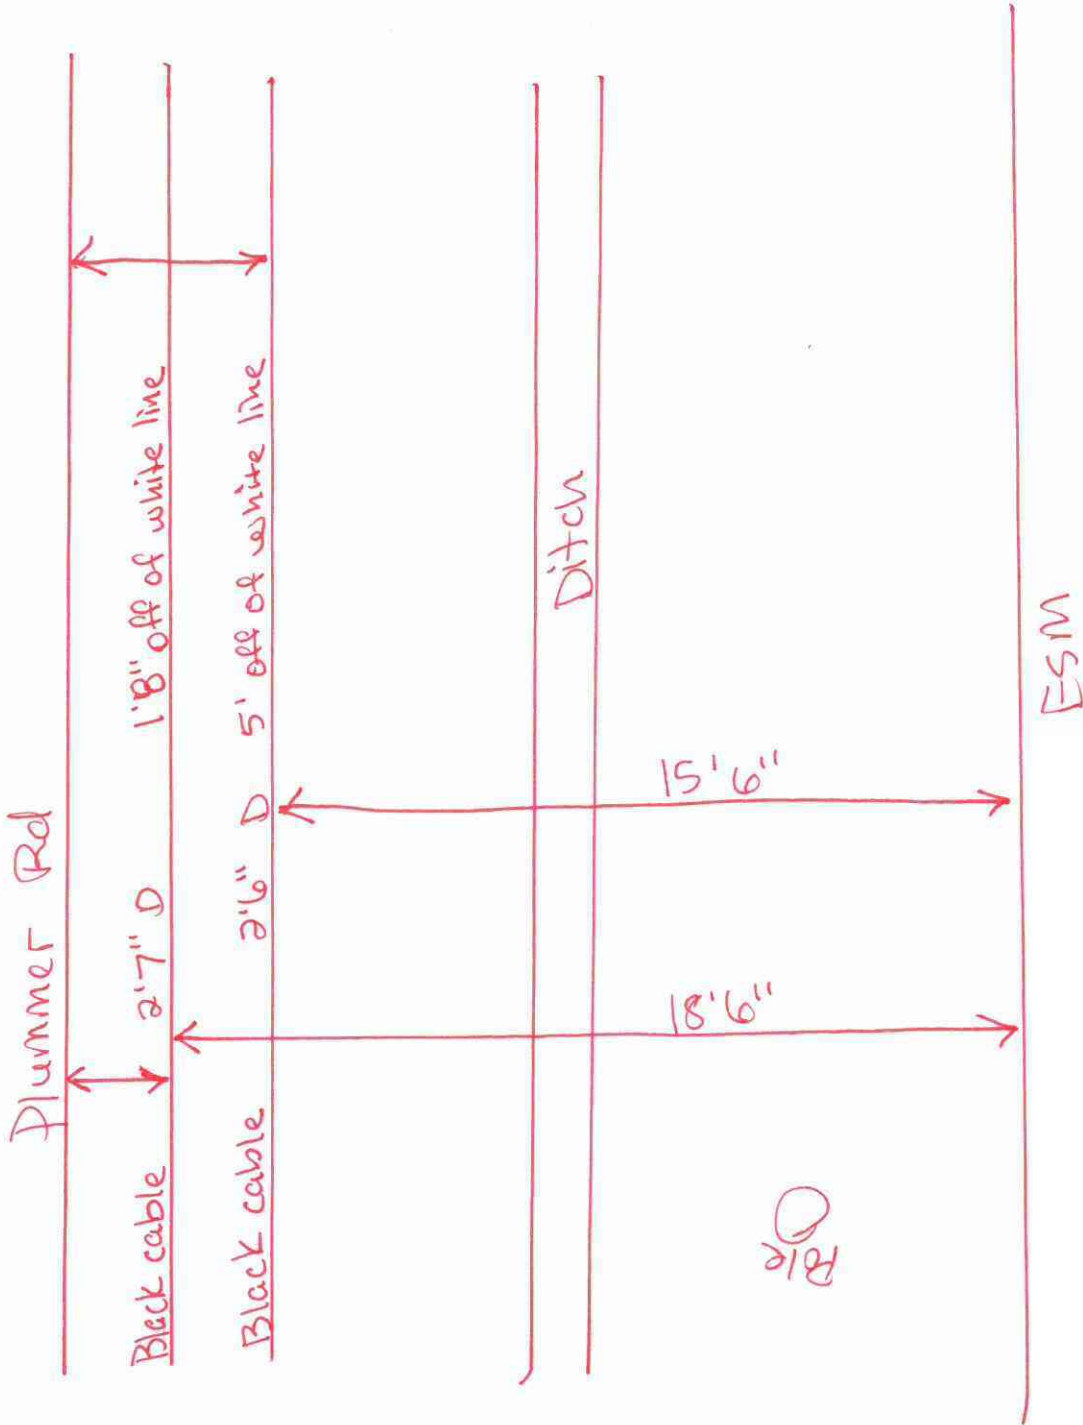


B5012


S
N
E

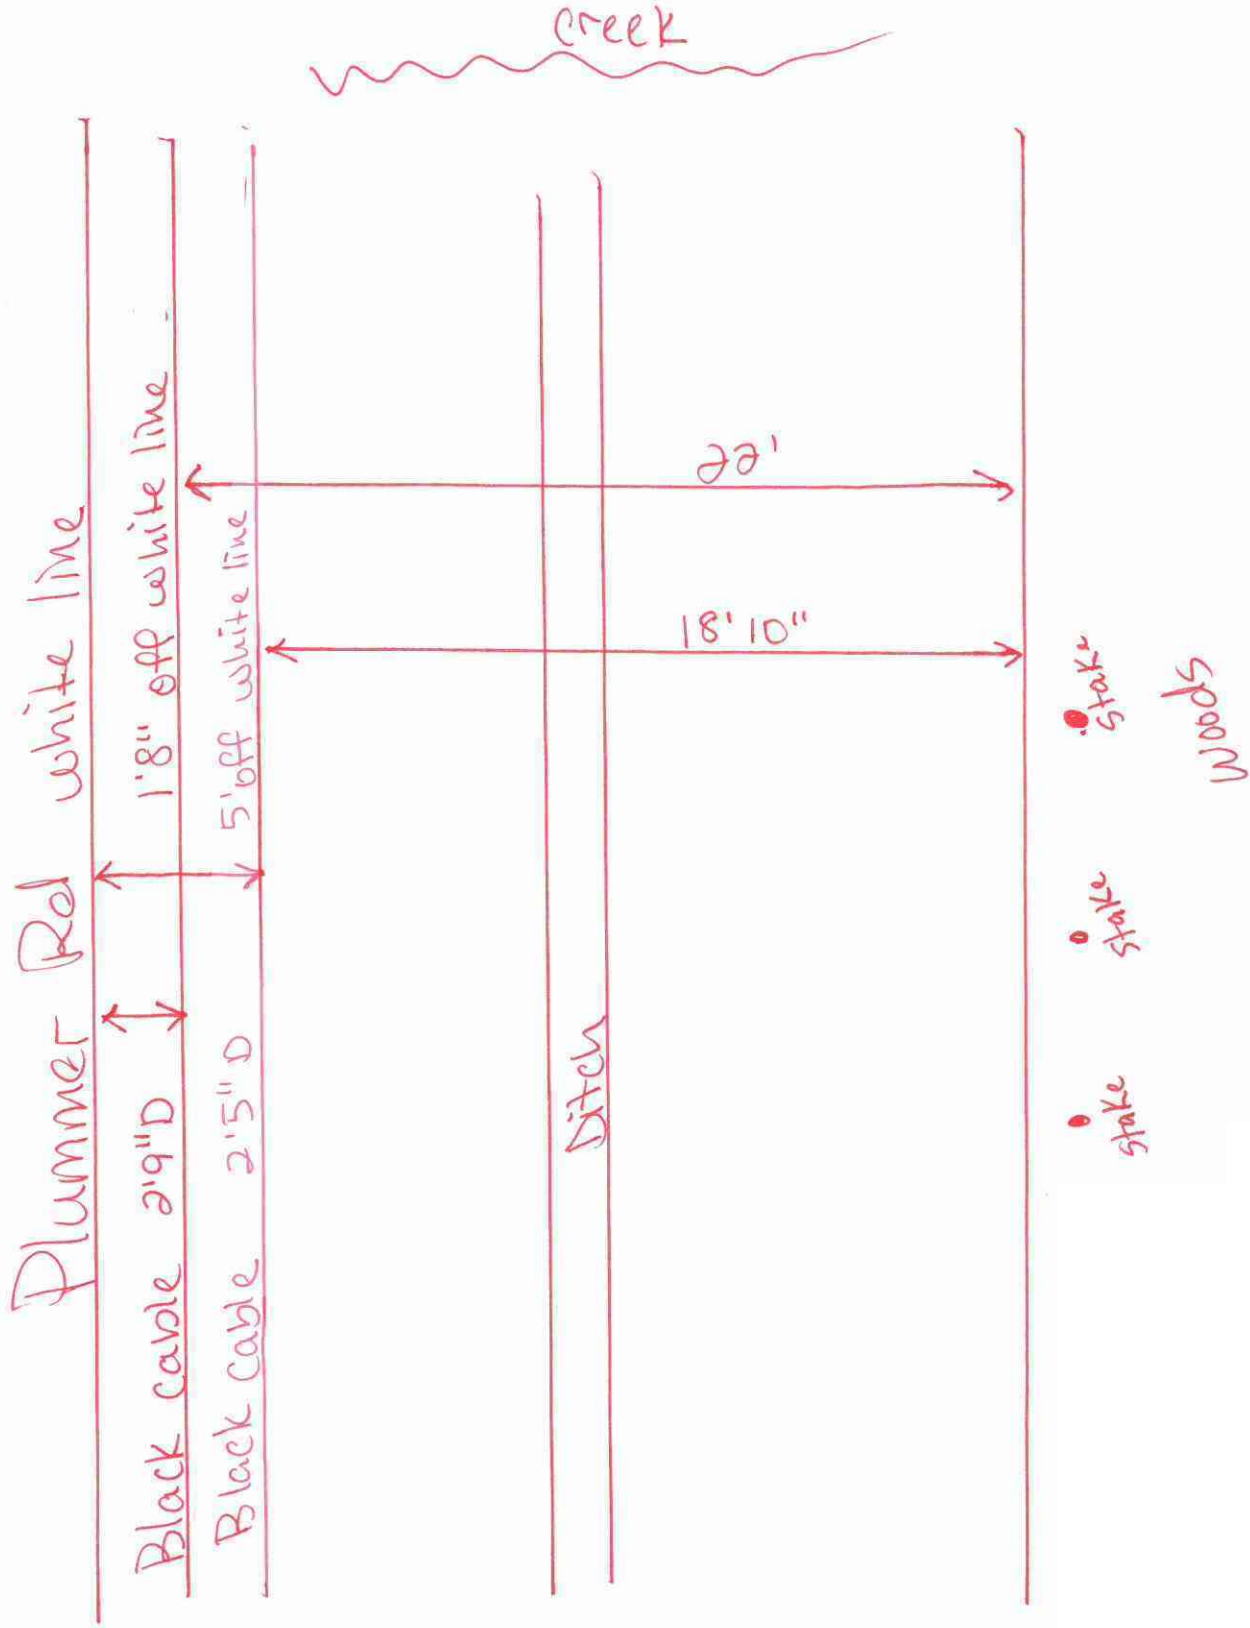

B5012

N
S
E
W

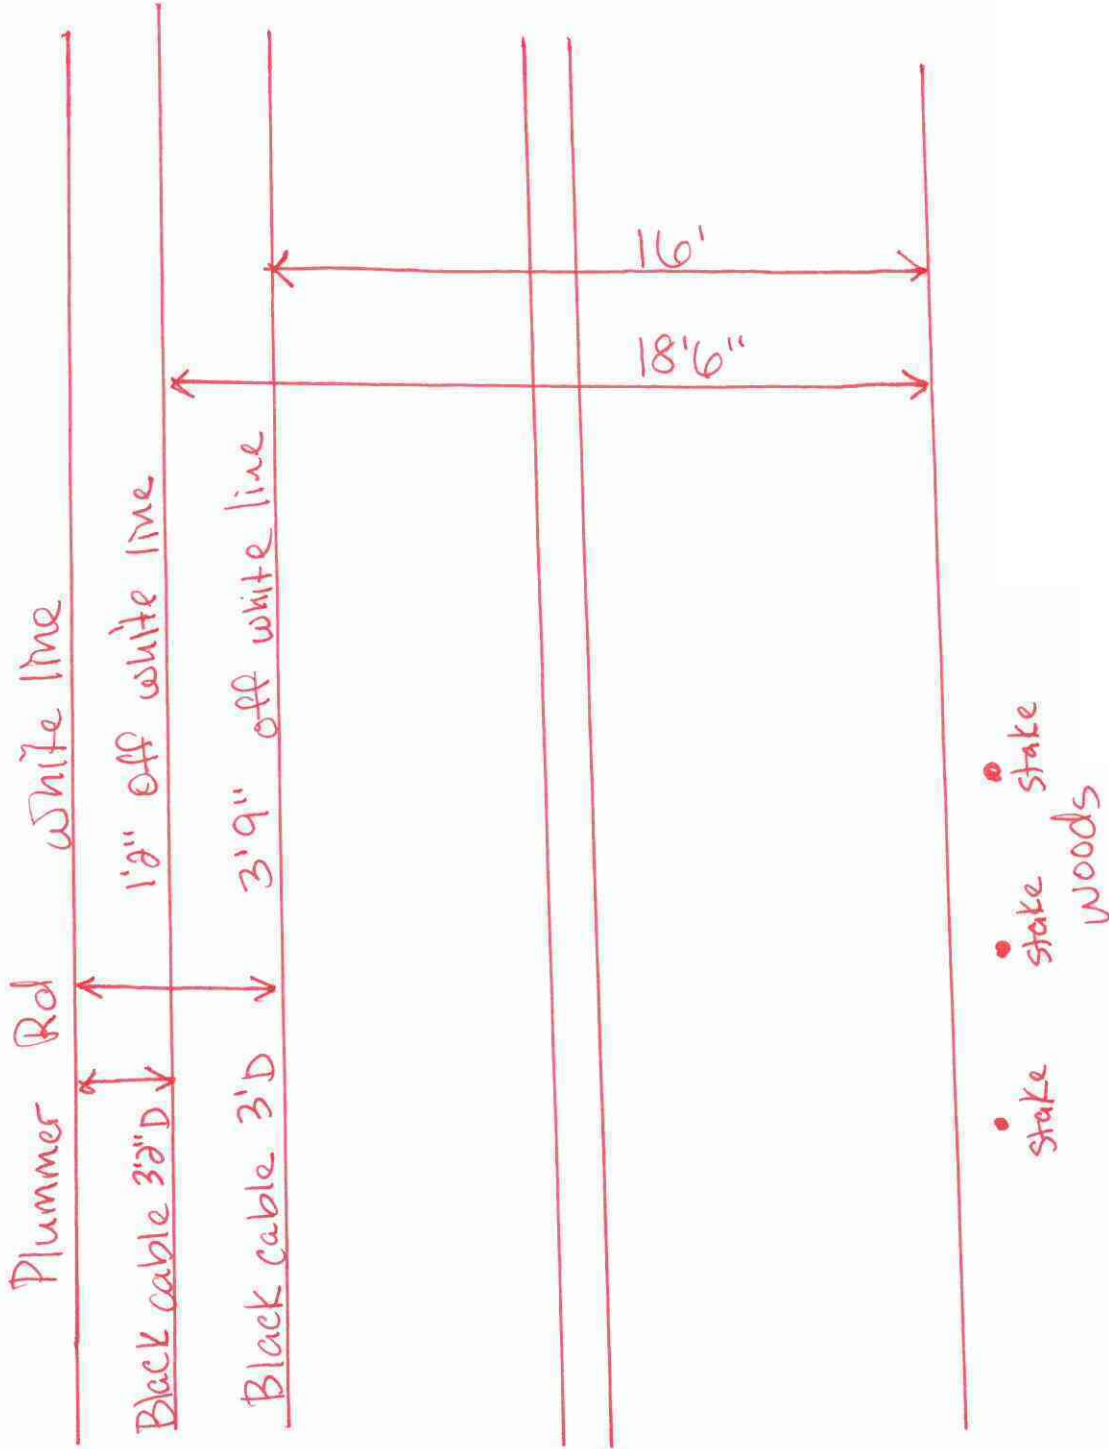

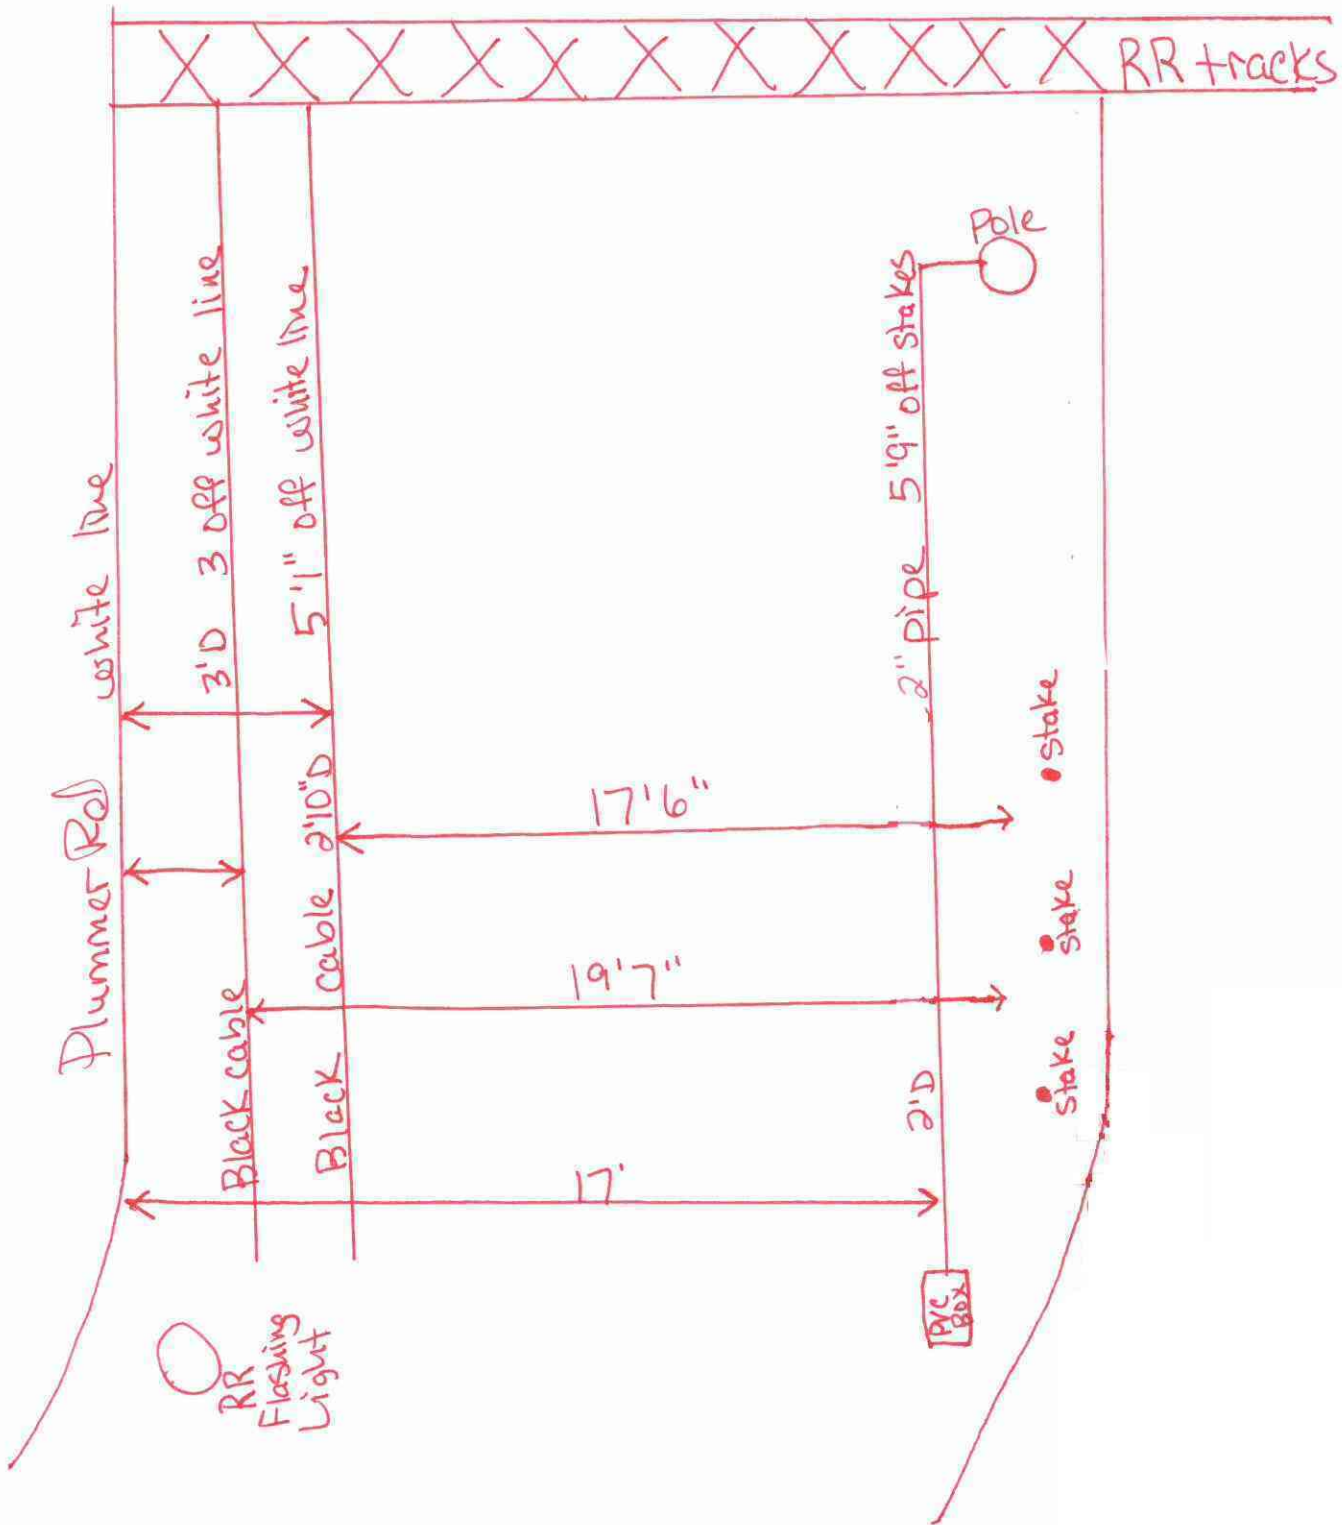

B5012

S
W
N
E

