

- ☒ NO EXCEPTIONS NOTED  
Release for manufacture
- ☐ EXCEPTIONS NOTED  
Release for manufacture  
Revise and resubmit for distribution
- ☐ RETURNED FOR CORRECTION  
Do not proceed  
Revise and resubmit for authorization


BILL OF MATERIAL				
PC. MK.	QTY	DESCRIPTION	MATERIAL	REMARKS
	(TWO)	INLET FLANGE ASSEMBLIES MK'014131-4A'		
401	2	PL 1/4 x 71" x 248 3/4"	A36	PLAIN 3-14
402	4	PL 1/4 x 36 5/8" x 53 1/4"	A36	PLAIN 3-14
403	2	PL 1/2 x 6 3/8" x 321 5/8"	A36	PLAIN 3-18

**SPECIAL NOTES:**

- 1) QTY'S LISTED FOR (1) UNIT, (2) UNITS REQ'D  
2) WORK WITH SHTS. #1, & 25.

Review does not relieve contractor from responsibility for errors or deviations from contract requirements

**UTILITY  
ENGINEERING**

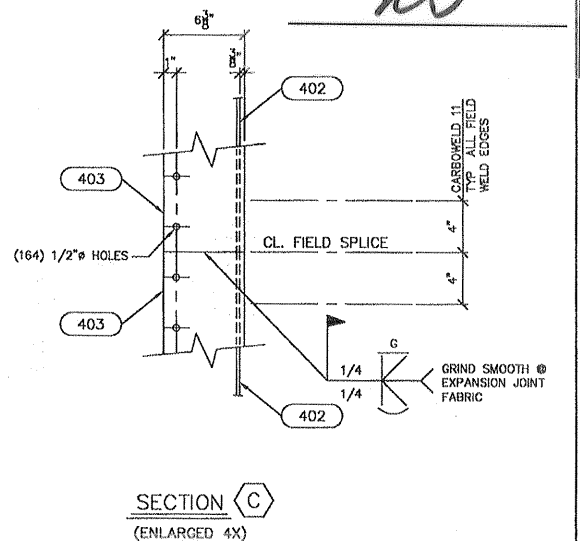

**M010322-201A227 RA  
JEA BRANDY BRANCH**

**2/21/2003**

NOOTER/ERIKSEN INC. VENDOR SUBMITTAL REVIEW				
WORK OF WHICH COMPANY DOES NOT RELIEVE THE VENDOR OF RESPONSIBILITY FOR ACCURACY OF DRAWINGS AND COMMENTS TO OTHER NOOTER/ERIKSEN DRAWINGS AND P.E. REQUIREMENTS				
[X] A1 REVIEWED AND ACCEPTED				
[ ] B1 REVIEWED WITH COMMENTS (WORK MAY PROCEED)				
[ ] C1 REVISE AND RESUBMIT (WORK MAY NOT PROCEED)				
[ ] D1 REVIEWED FOR INFORMATION ONLY				
RELEASE DATE	2/22/03	REVIEWERS INITIALS	[Signature]	
Project	JEA BRANDY	Job No.	Code	Sh1
Rev	FE			
AE Drawing No.	014131	DU	004	A
Chanute Manufacturing Co. A Unit Of Optimus Corp.				
<b>INLET DUCT 'A'</b> <b>INLET ASSEMBLY MK'014131-4A'</b> <b>(COLUMN D1)</b>				
REF. CUST. DWG. :				
DRAWN BY	MM	6/12/02	OLD PLOT WORK:	24
CHECKED BY	OE	8/5/02		
APPROVED BY	DC	8/9/02		
SHEET		4		0
02036		A,B10		

THIS DRAWING AND DESIGN INCLUDING ALL NOTES AND PATENTABLE FEATURES SEPARATELY OR COLLECTIVELY OWNED AND INVENTED HEREIN ARE THE PROPERTY OF THE CHANUTE MANUFACTURING COMPANY, AND ACCEPTANCE OF THIS DRAWING CONSTITUTES AN AGREEMENT THAT IT WILL BE USED FOR NO PURPOSES OTHER THAN TO AND IN THE ASSEMBLY OR OPERATION OF EQUIPMENT FROM CHANUTE MANUFACTURING COMPANY. THIS DRAWING SHALL BE RETURNED TO CHANUTE MANUFACTURING COMPANY IMMEDIATELY UPON COMPLETION OF THE PROJECT FOR WHICH IT IS SPECIALLY FURNISHED. EXCEPT AS EXPRESSLY AUTHORIZED BY WRITING BY CHANUTE MANUFACTURING COMPANY.

WHEN IN DOUBT ASK SAFETY FIRST!