



**SECTION C-D-1502**  
NO SCALE

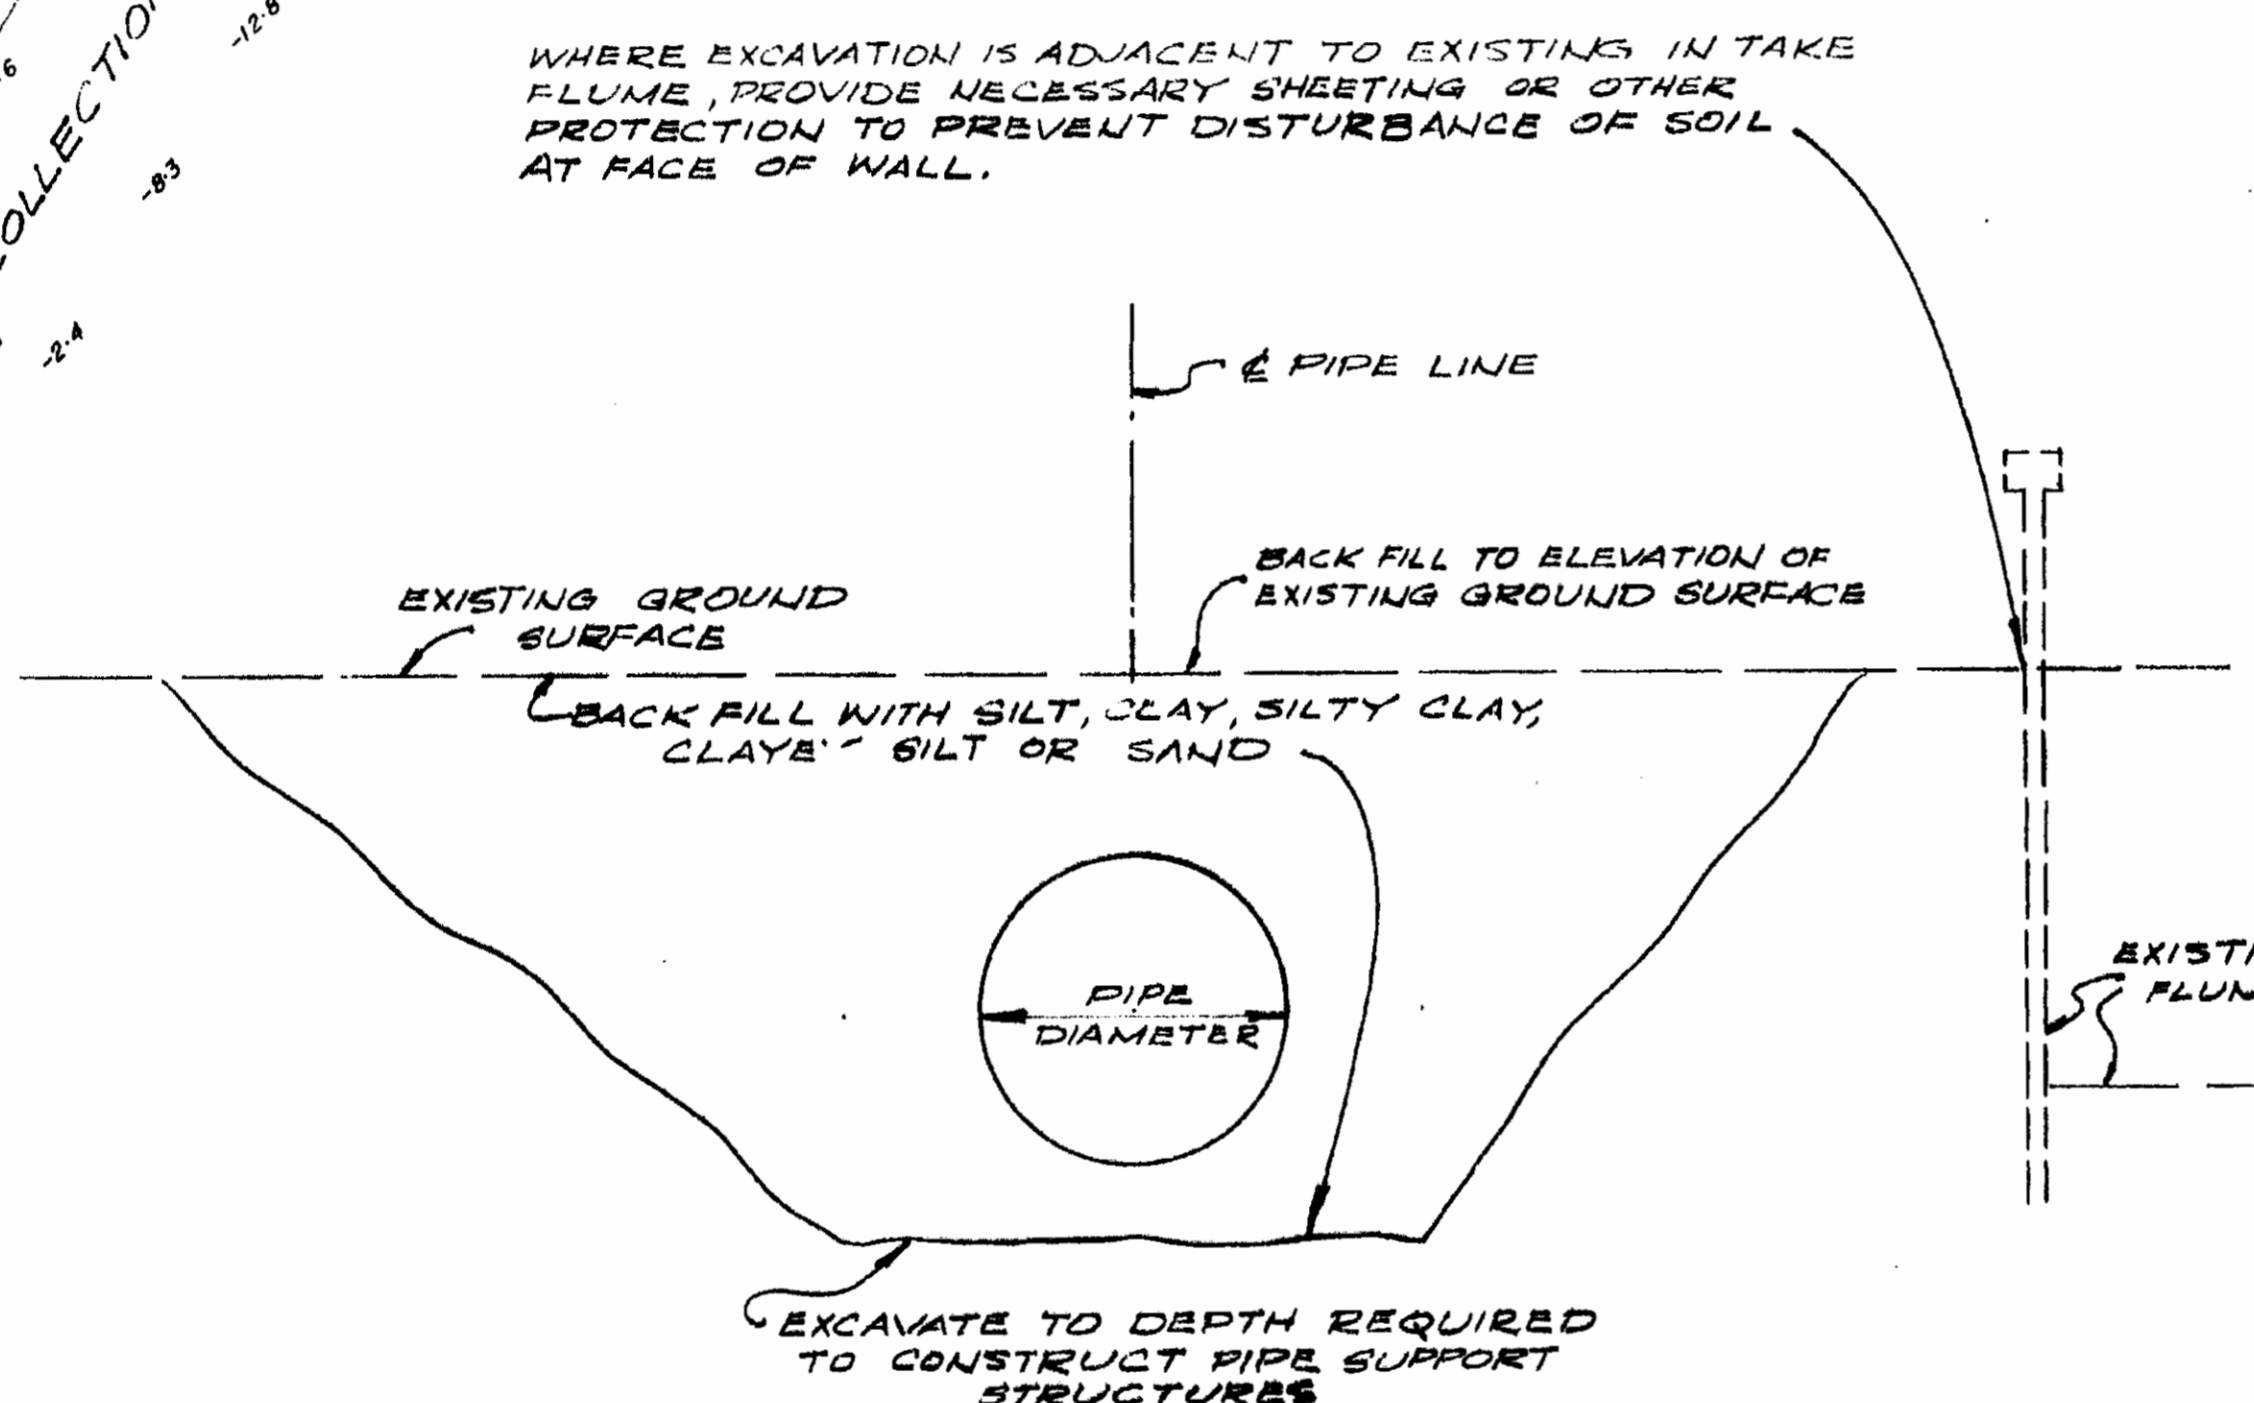


**ALTERNATE "B" TYPICAL SECTION**  
STA. 99+00 TO STA. 105+50

NOTE: FOR PIPE PROFILE GRADE SEE PIPE PLAN AND PROFILE DRAWINGS

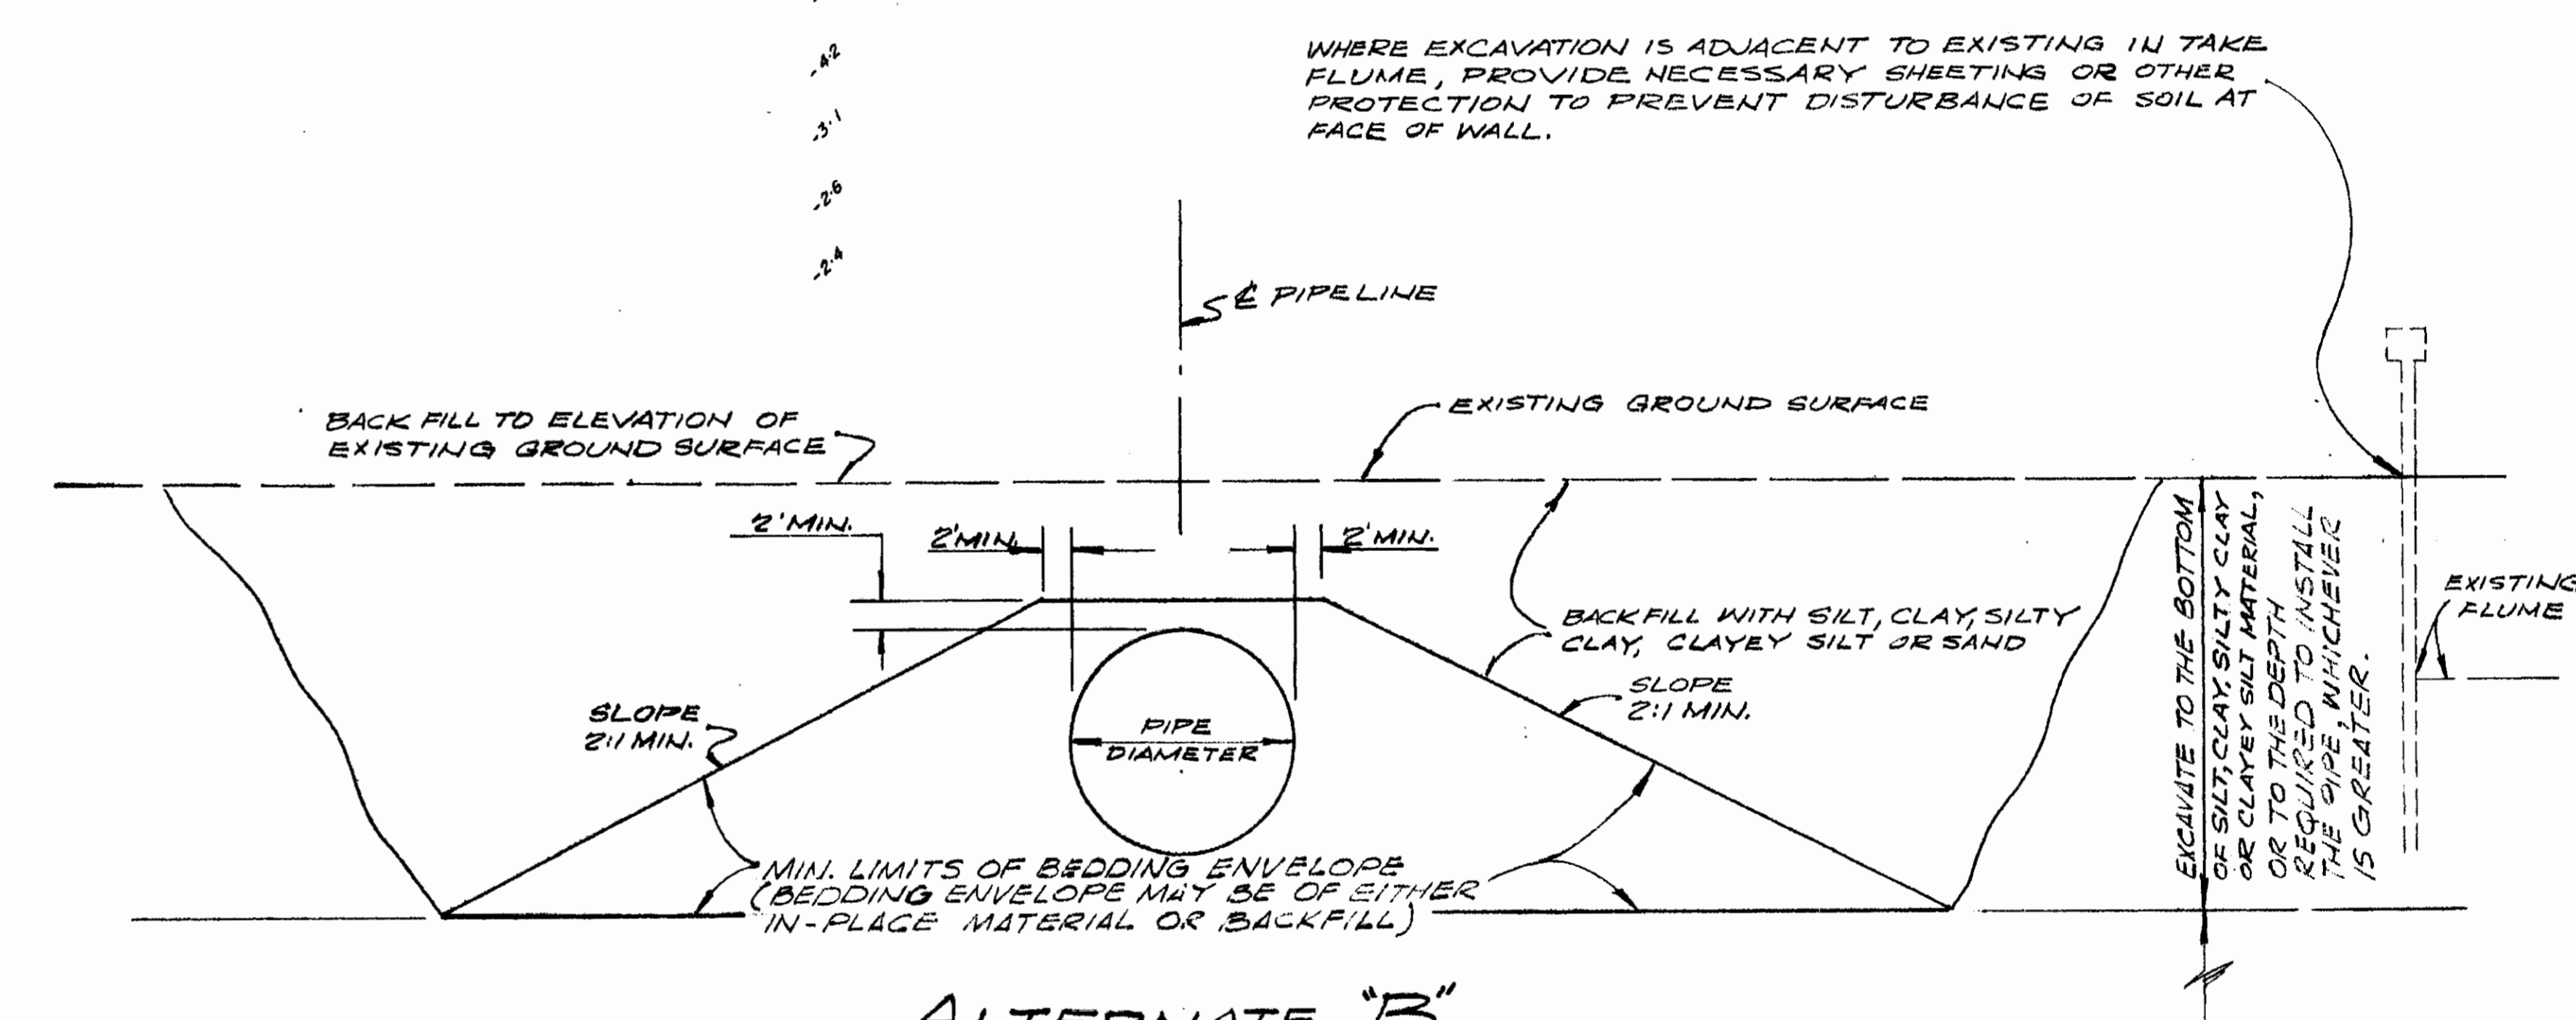


**ALTERNATE "B" TYPICAL SECTION**  
STA. 105+50 TO STA. 117+64.06

NOTE: FOR PIPE PROFILE GRADE SEE PIPE PLAN AND PROFILE DRAWINGS

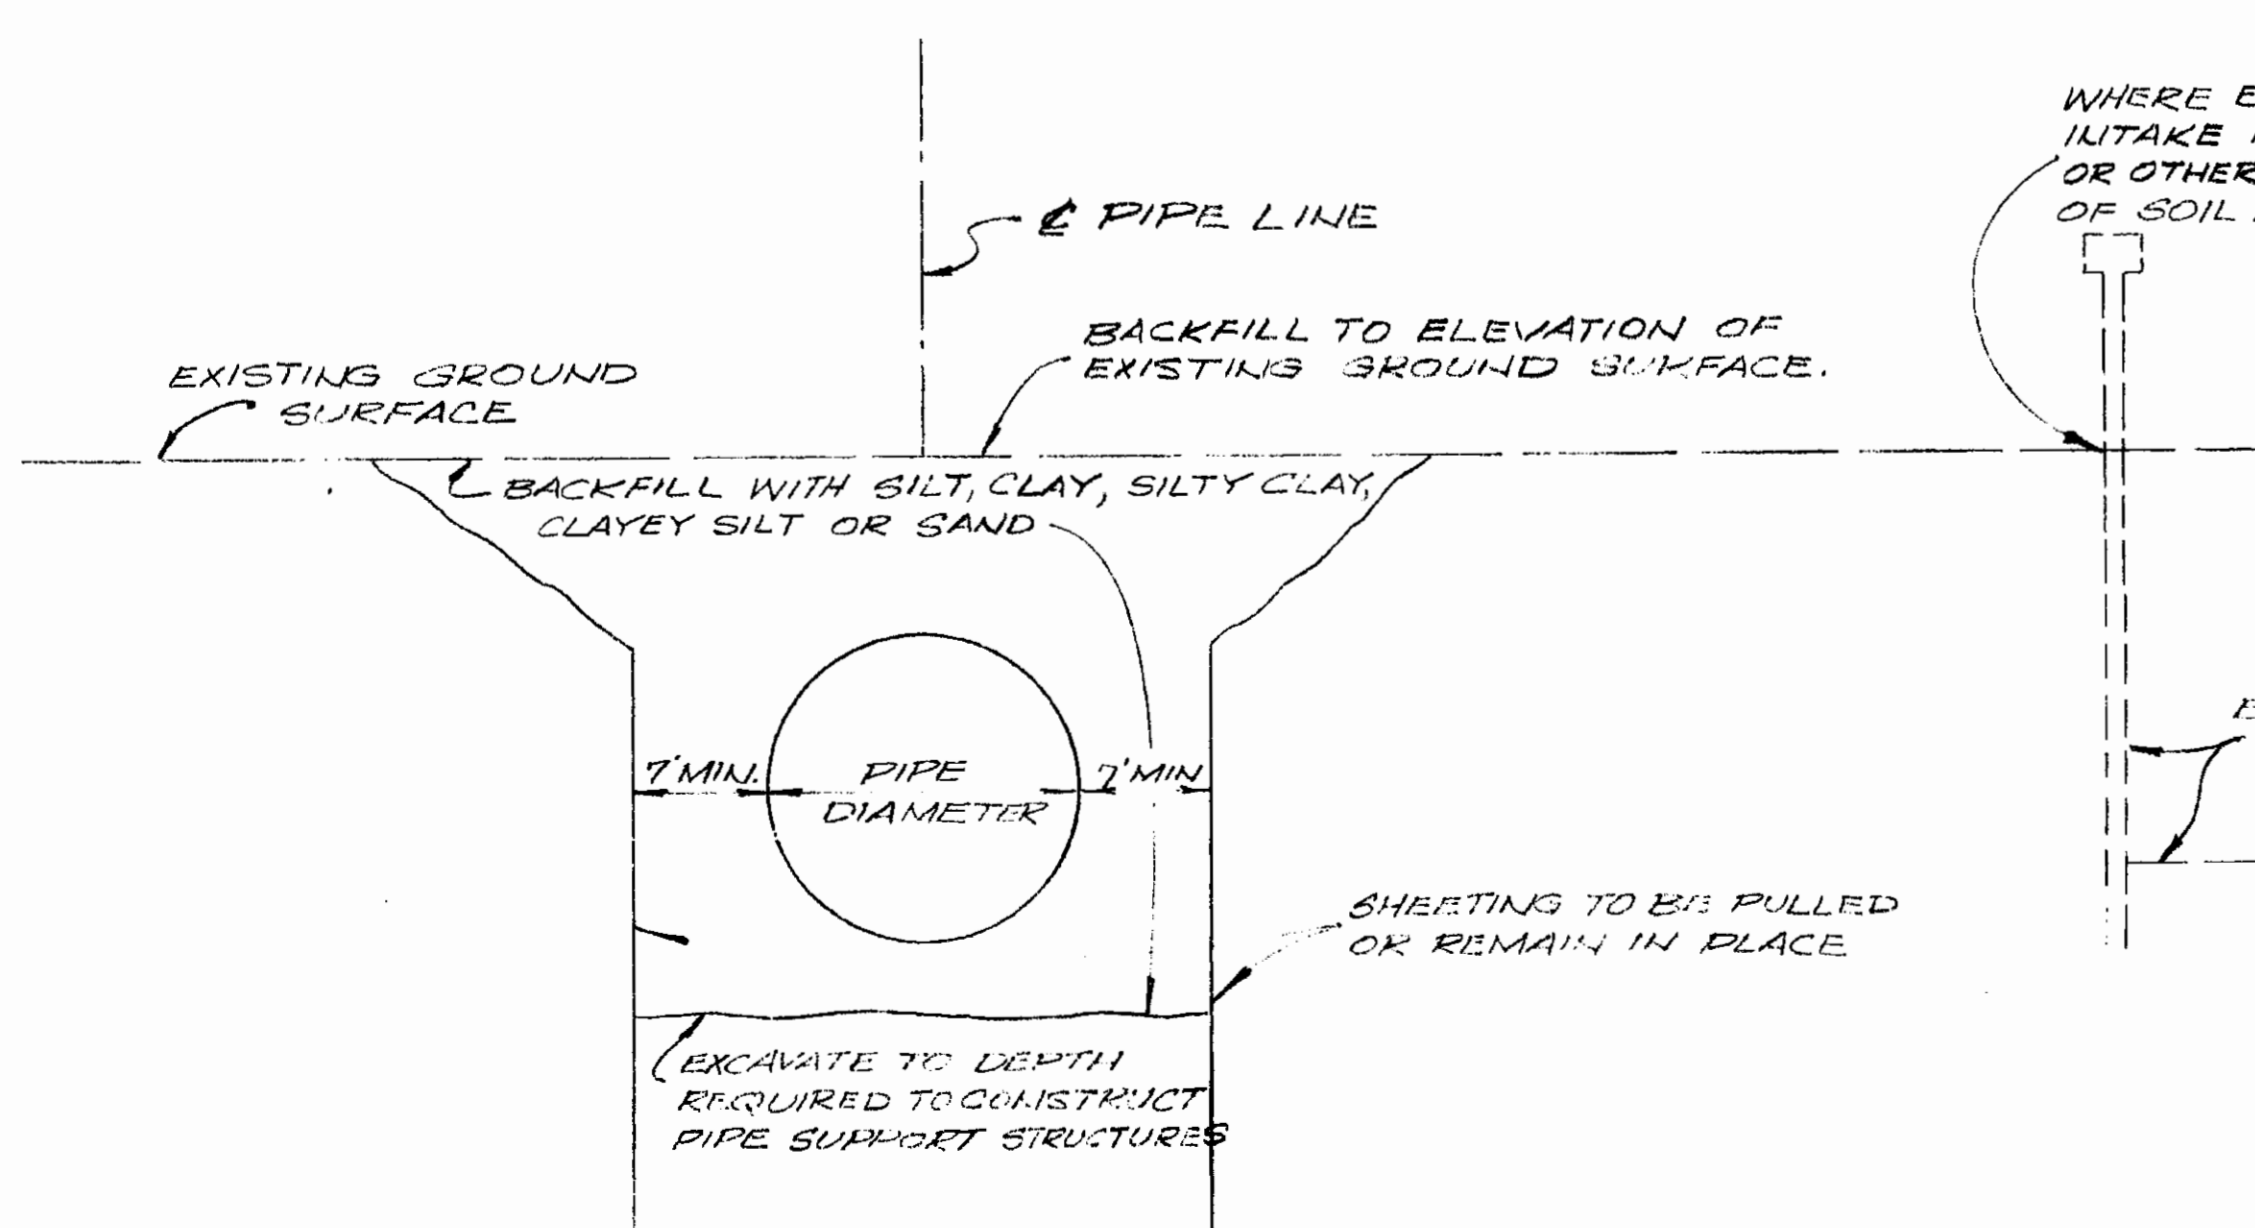

**ALTERNATE "A" TYPICAL SECTION**  
STA. 99+00 TO STA. 105+50

NOTE: FOR PIPE PROFILE GRADE SEE PIPE PLAN AND PROFILE DRAWINGS

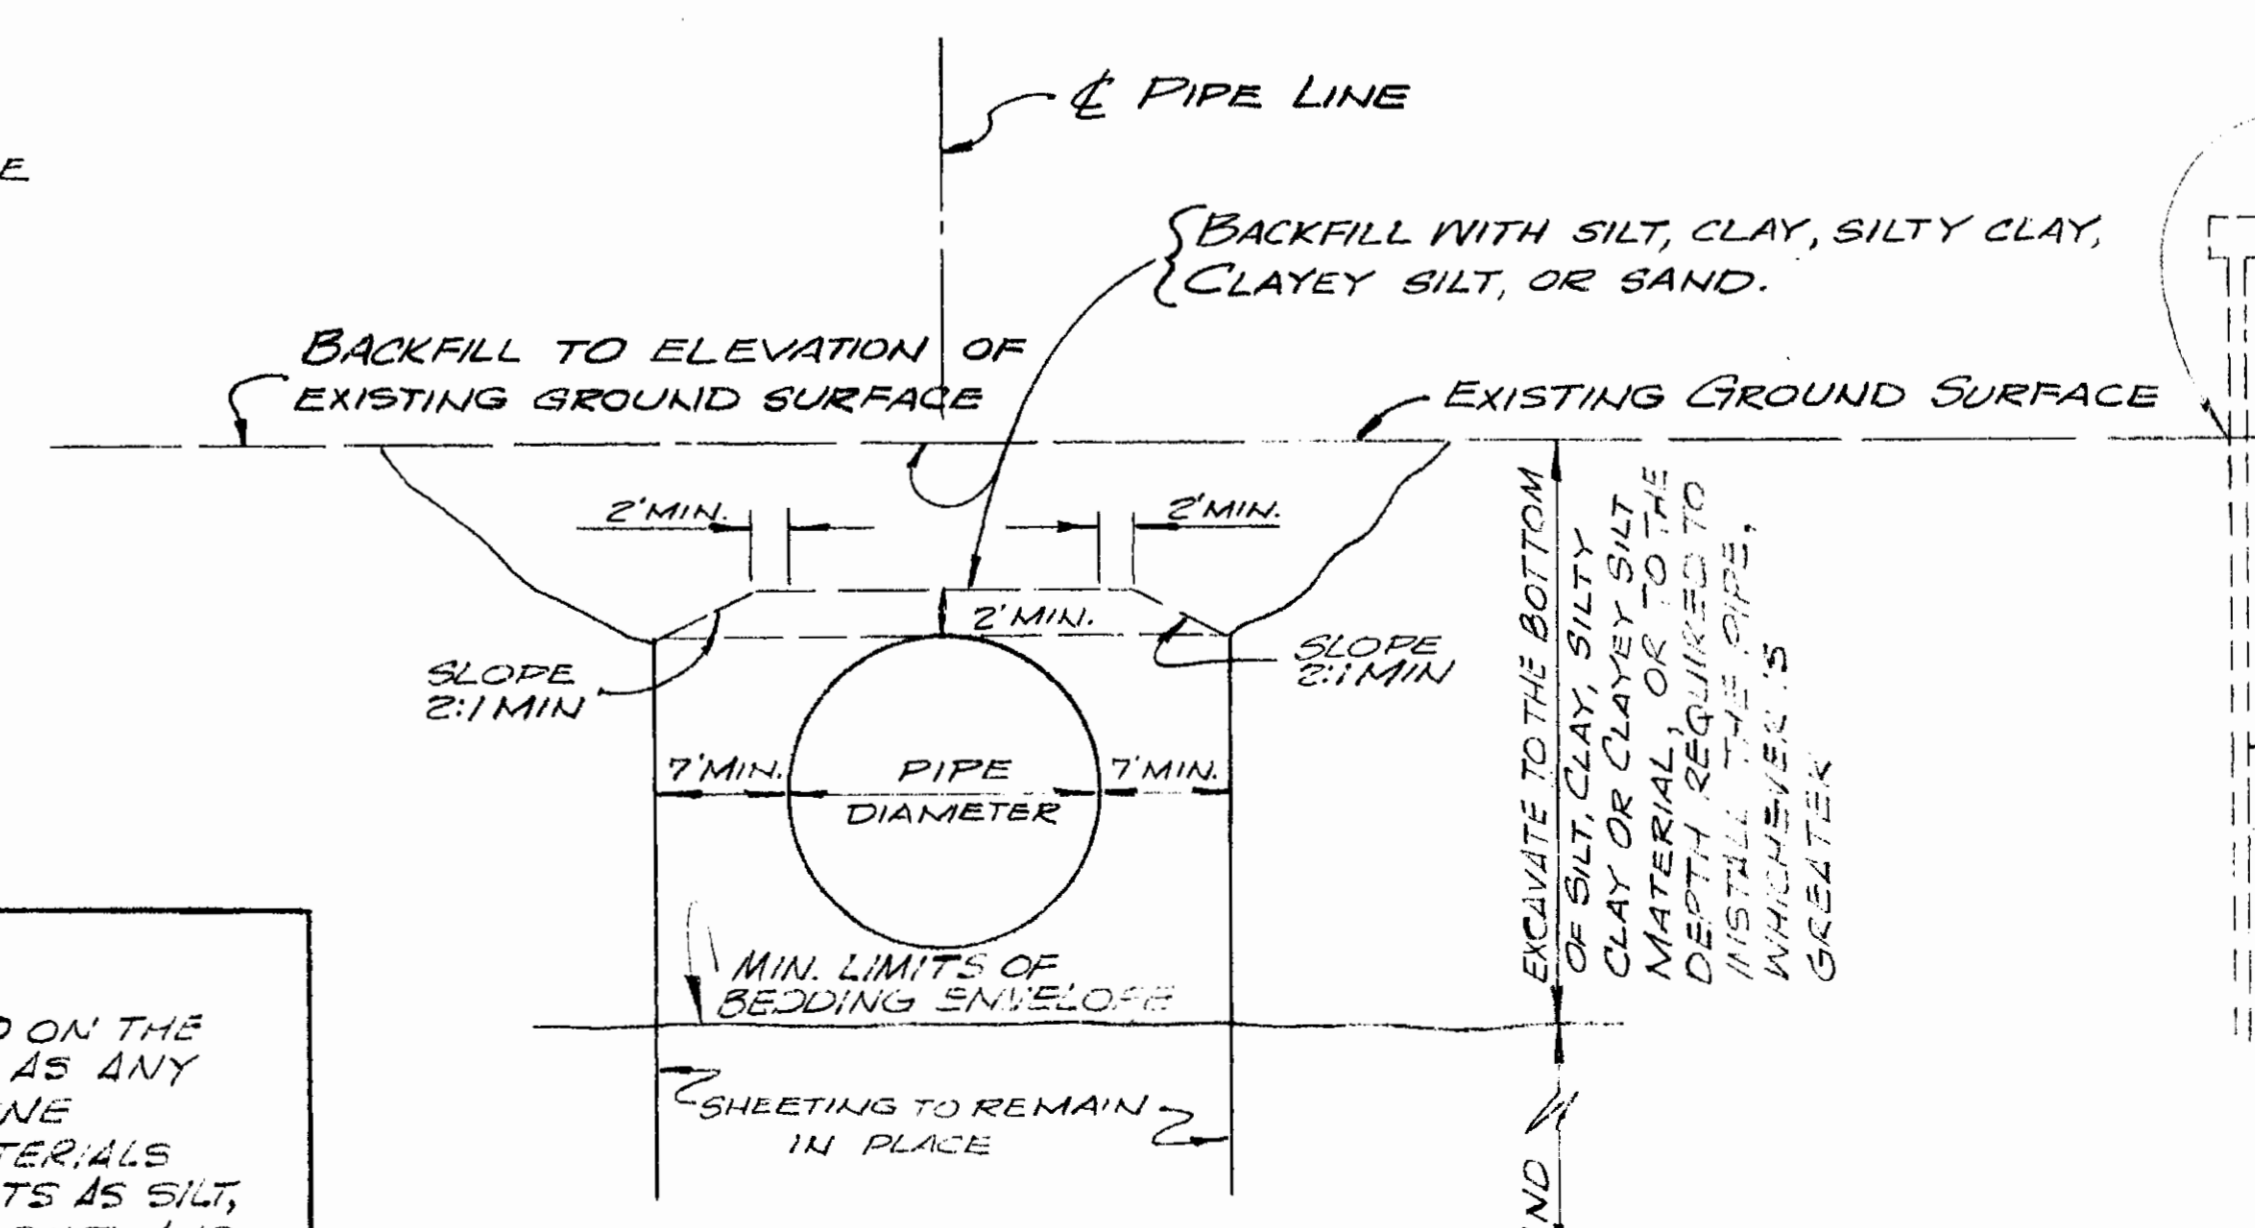

**ALTERNATE "A" TYPICAL SECTION**  
STA. 105+50 TO STA. 117+64.06

NOTE: FOR PROFILE GRADE SEE PIPE PLAN AND PROFILE DRAWINGS

**NOTE:**

1. THE TERM SAND THAT IS INDICATED ON THE TYPICAL SECTIONS IS DEFINED AS ANY SOIL MATERIAL FROM THE PIPELINE EXCAVATION, EXCEPT THOSE MATERIALS IDENTIFIED IN THE SOIL REPORTS AS SILT, CLAY, SILTY CLAY, OR CLAYEY SILT, AND ALSO ANY APPROVED BORROW MATERIAL REQUIRED THAT MEETS THE REQUIREMENTS STATED IN SECTION 02631 OF THE SPECIFICATIONS.
2. PIPE EXCAVATION AND BEDDING SHALL MEET THE REQUIREMENTS INDICATED IN ALTERNATE "A" OR ALTERNATE "B".

009199 SPEC. NO. 76146-000C

**REYNOLDS, SMITH AND HILLS**  
ARCHITECTS-ENGINEERS-PLANNERS, INCORPORATED JACKSONVILLE, FLORIDA

**JACKSONVILLE ELECTRIC AUTHORITY**  
NORTHSHORE GENERATING STATION  
THERMAL DISCHARGE  
SITE PLAN & DETAILS

APPROVED FOR REYNOLDS, SMITH AND HILLS

FOR THE JACKSONVILLE ELECTRIC AUTHORITY

DRAWING NO. 76146 D 1502

DEPARTMENT HEAD: ENGINEERING DEPARTMENT

MANAGING DIRECTOR

DATE: 8-1-77

SCALE VARIES

CHECKED: R. D. C.


TRACED: L. E. S.

DRAWN: W. A. N.

REVISION	DESCRIPTION	DATE	BY	APPROVED
0	UPDATED FOR ADD. # G	2-2-78	H.R.M.	J.R.M.
	UP DATED FOR RECORD SET	11-20-79		

003  
5588

BRUNING 40-105 28670

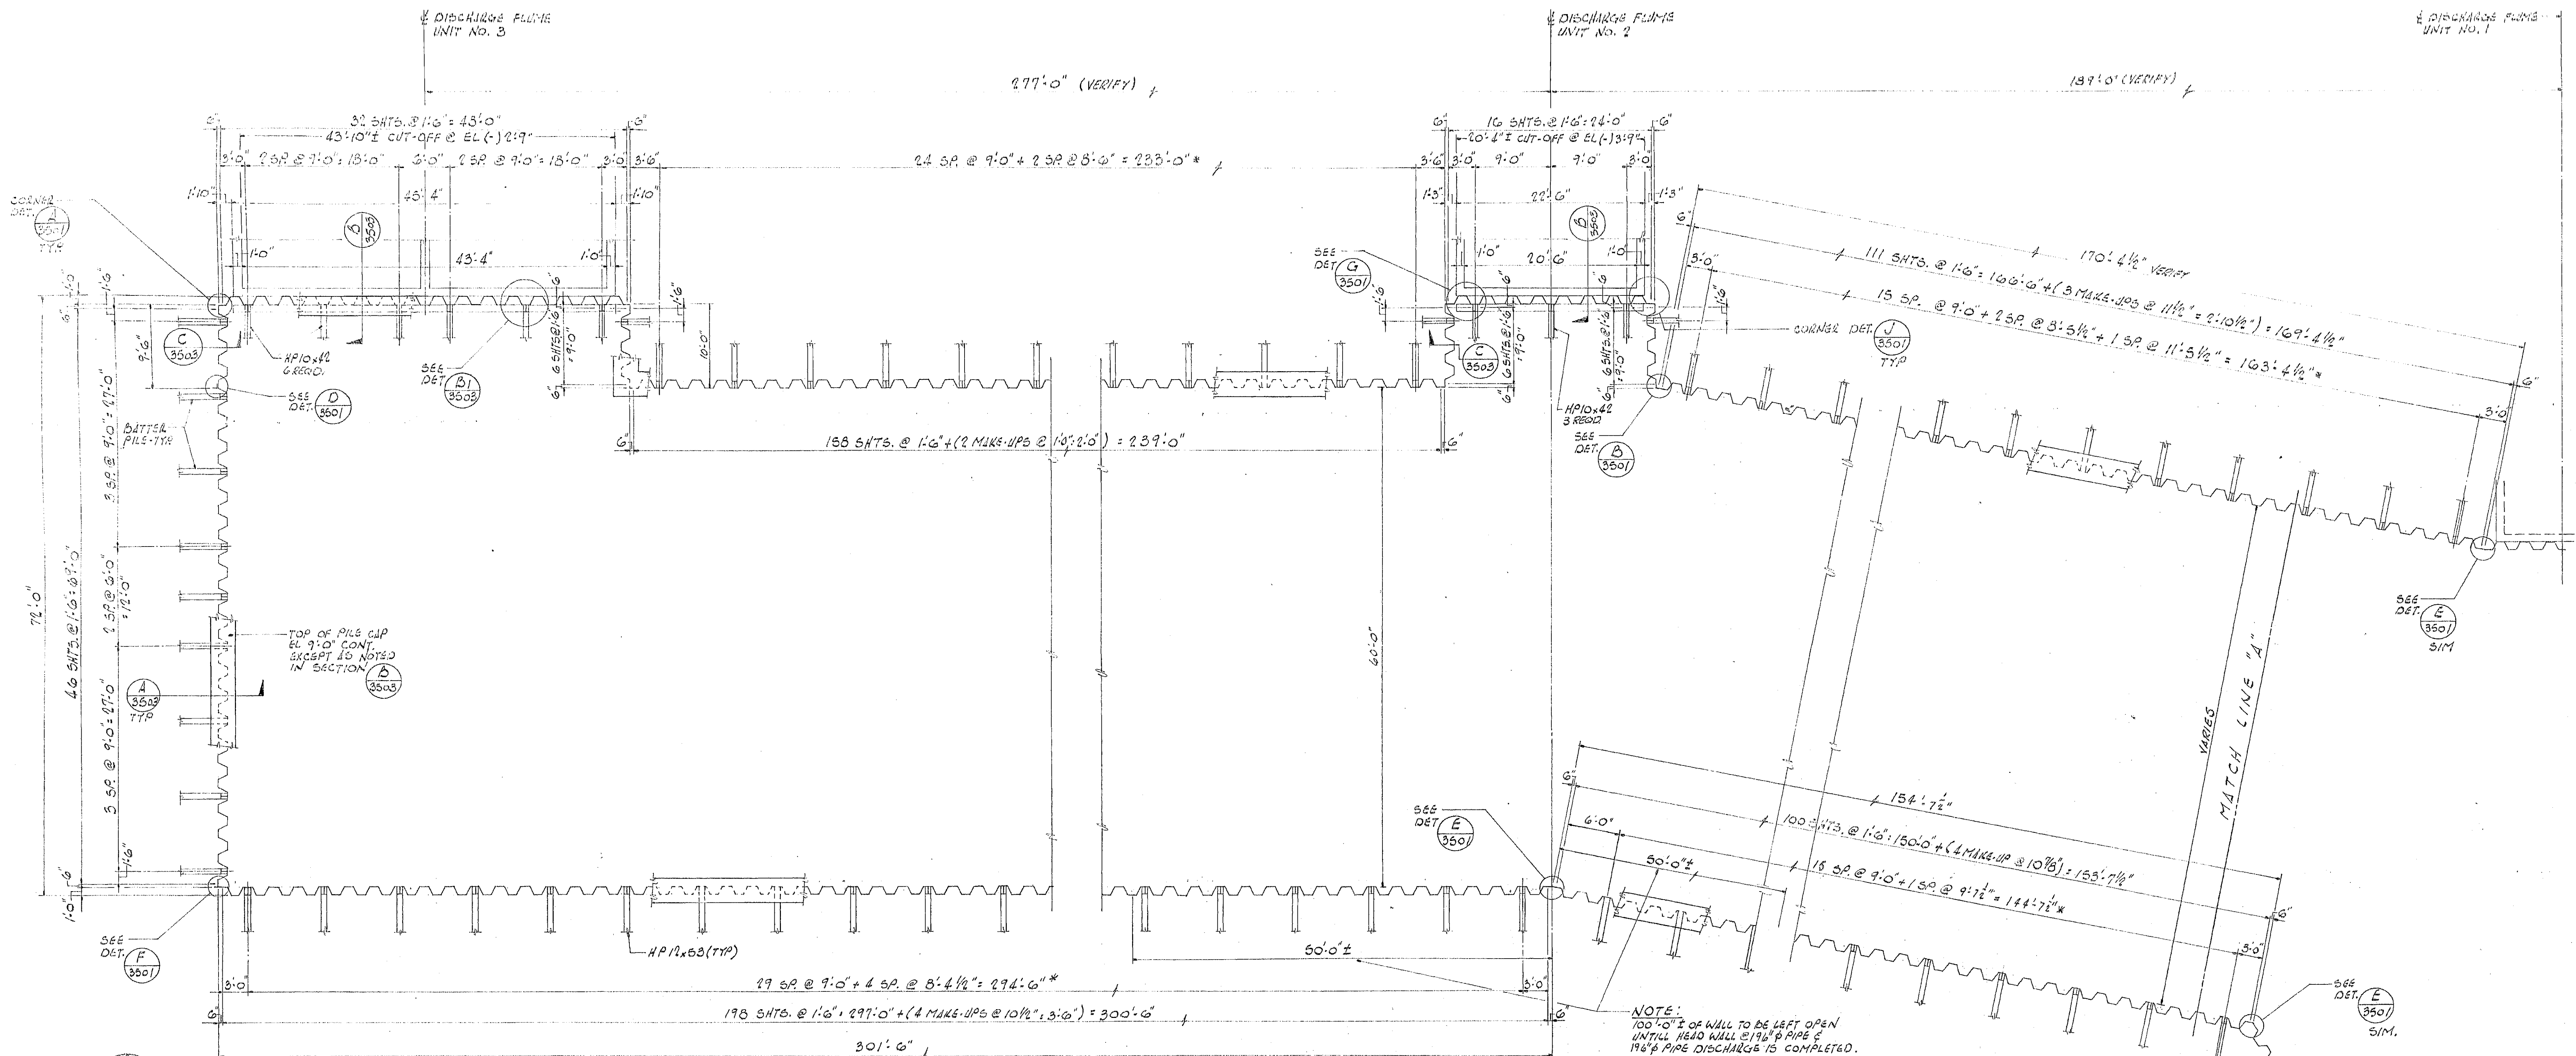


**PLAN - DISCHARGE FLUME - EL. 9'-0"**



- NOTES:**
1. ALL STEEL SHEET PILES ON THIS DRAWING ARE PZ 27. TIP ELEVATION (-) 38'-0".
  2. ALL BATTER PILES AT DISCHARGE FLUME ARE HP 10x42. ALL BATTER PILES AT UNIT 2 & UNIT 3 DISCHARGE FLUMES ARE HP 10x42.

NOTE: 100'-0" OF WALL TO BE LEFT OPEN UNTIL HEAD WALL @ 176" PIPE & 176" PIPE DISCHARGE IS COMPLETED.

NOTE: \* ASTERISK INDICATES BATTER PILE ODD SPACE OCCURS IN CONNECTION WITH THE MAKE-UP SHEET PILE. LOCATION TO BE DETERMINED BY CONTRACTOR. FOR TYPICAL MAKE-UP SHEET PILE SEE DETAIL (C) 3501

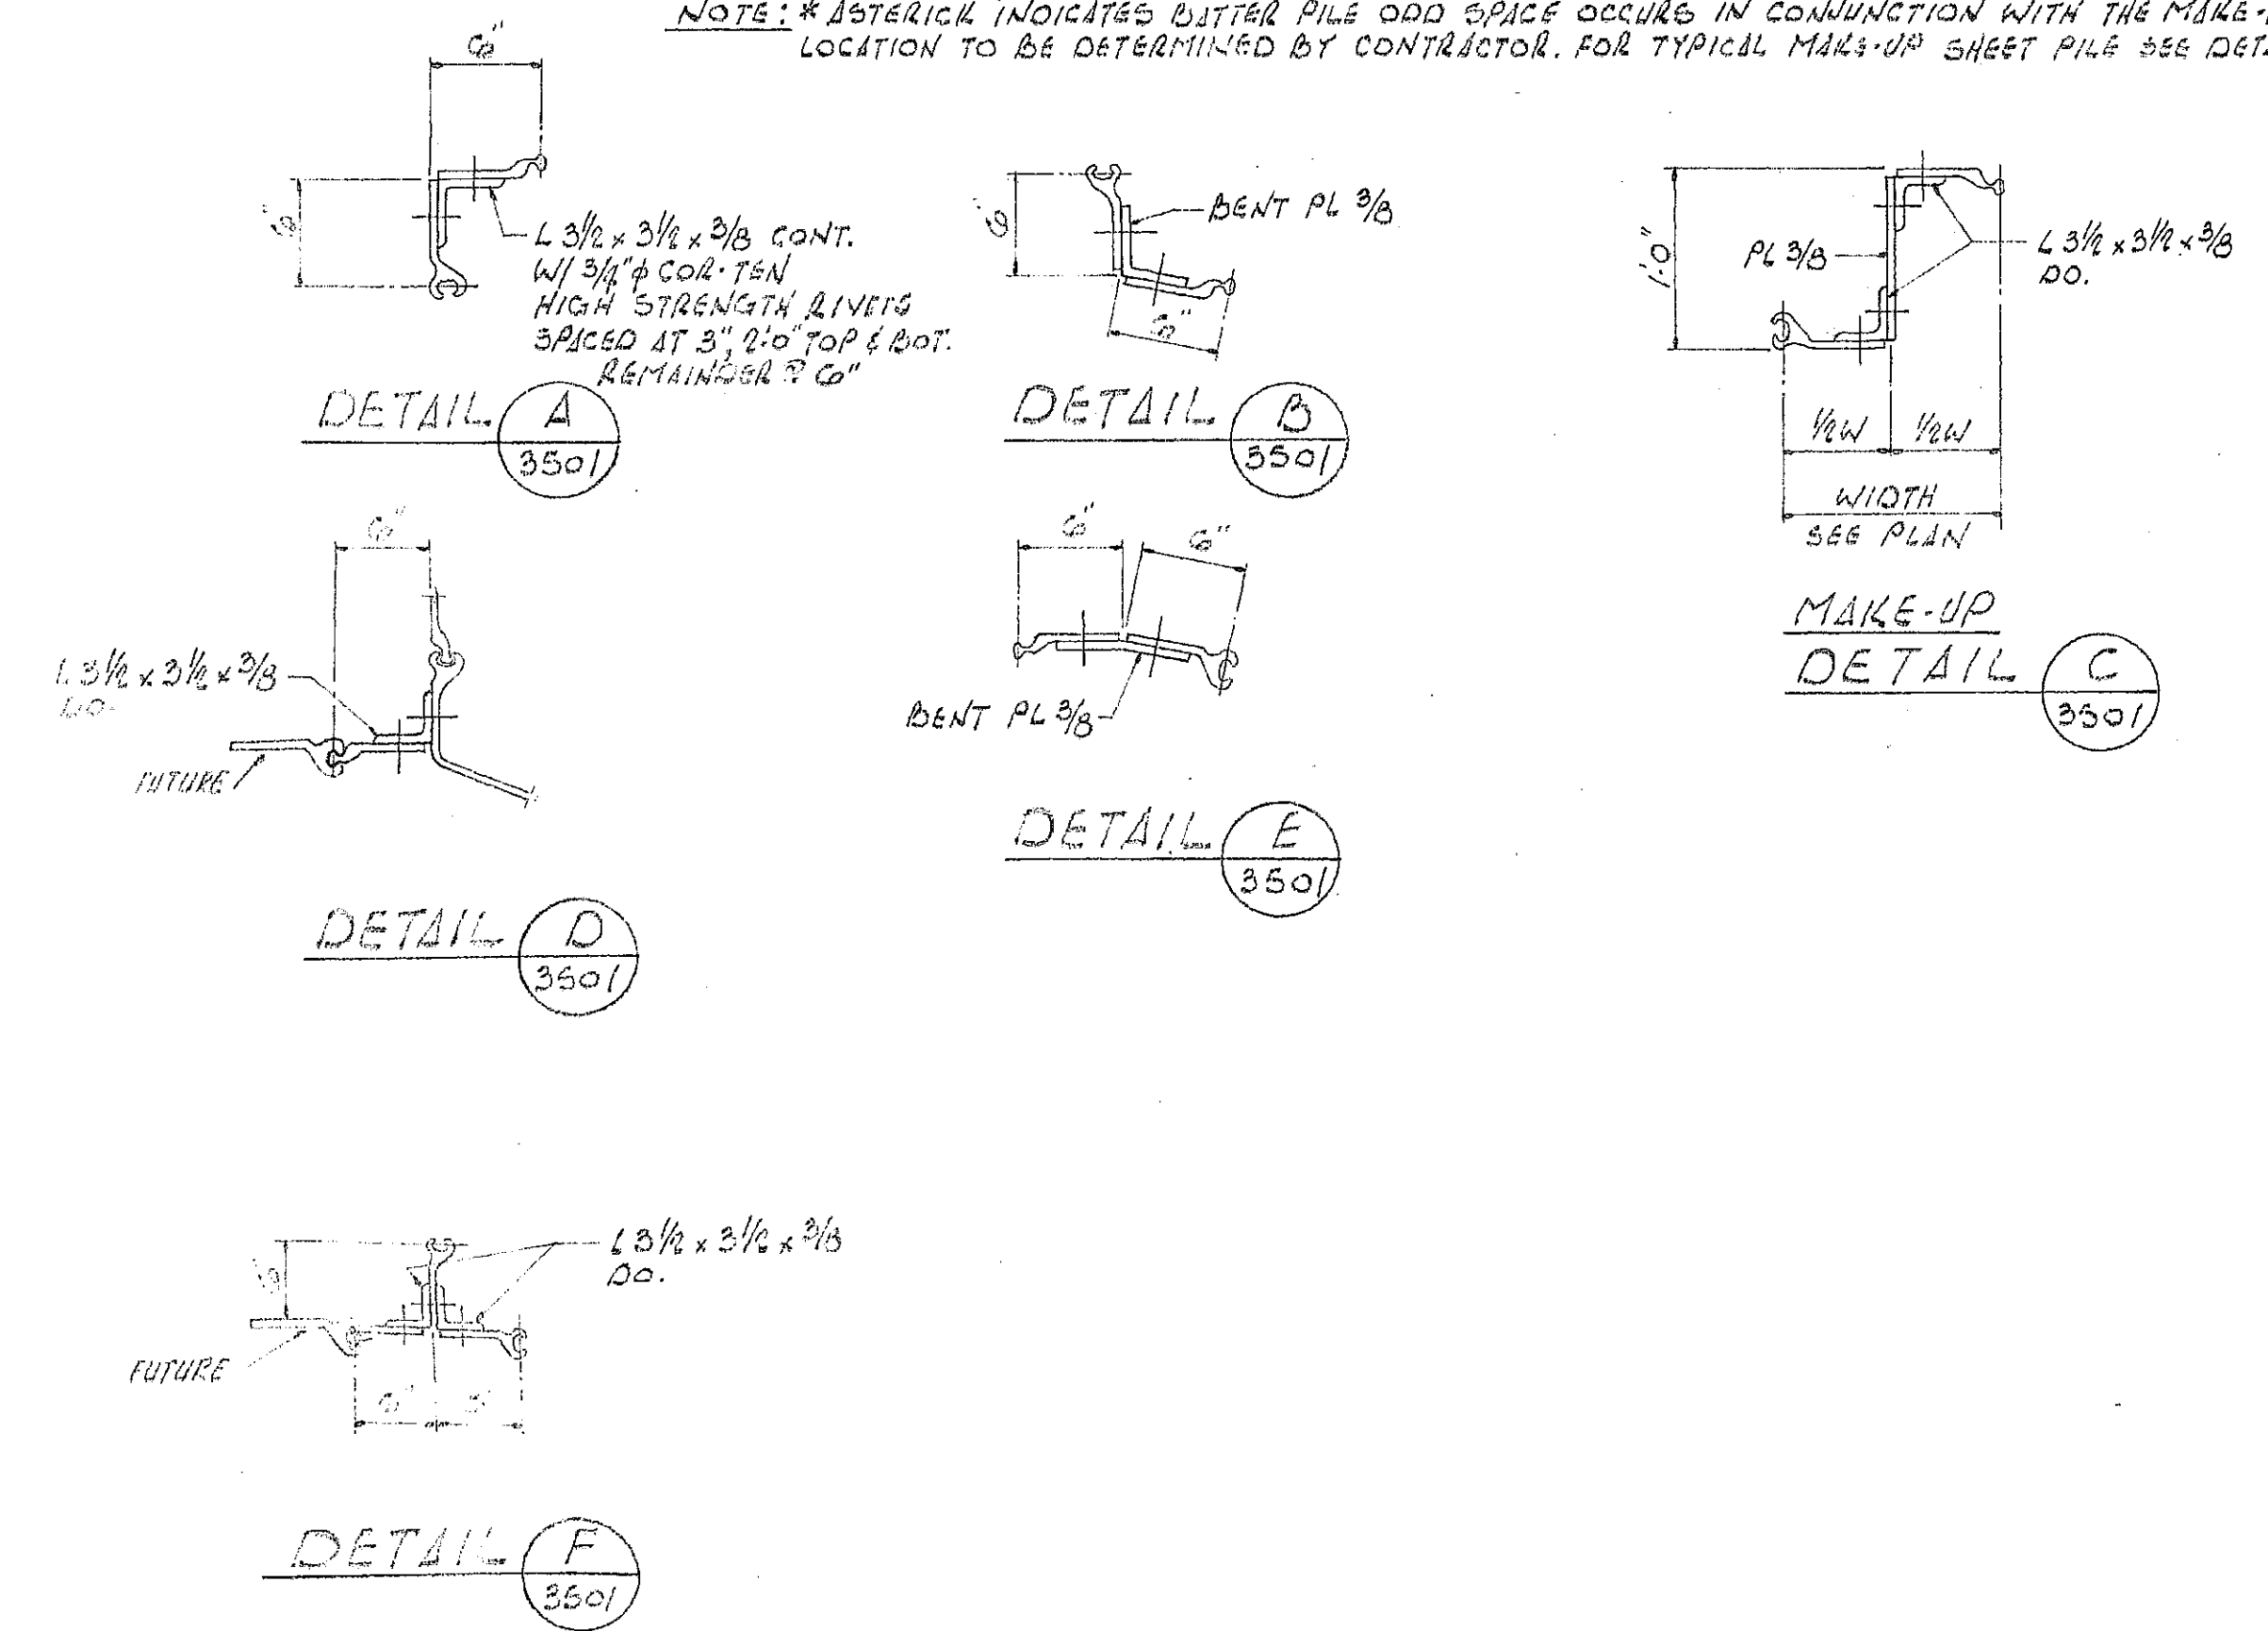

**TYPICAL SHEET PILE JOINT CONNECTIONS**  
 CONNECTIONS NOT SHOWN ARE SIMILAR.  
 WELDED CONNECTIONS MAY BE USED IN LACK OF RIVETS.  
 SAME 1"-1'-0"

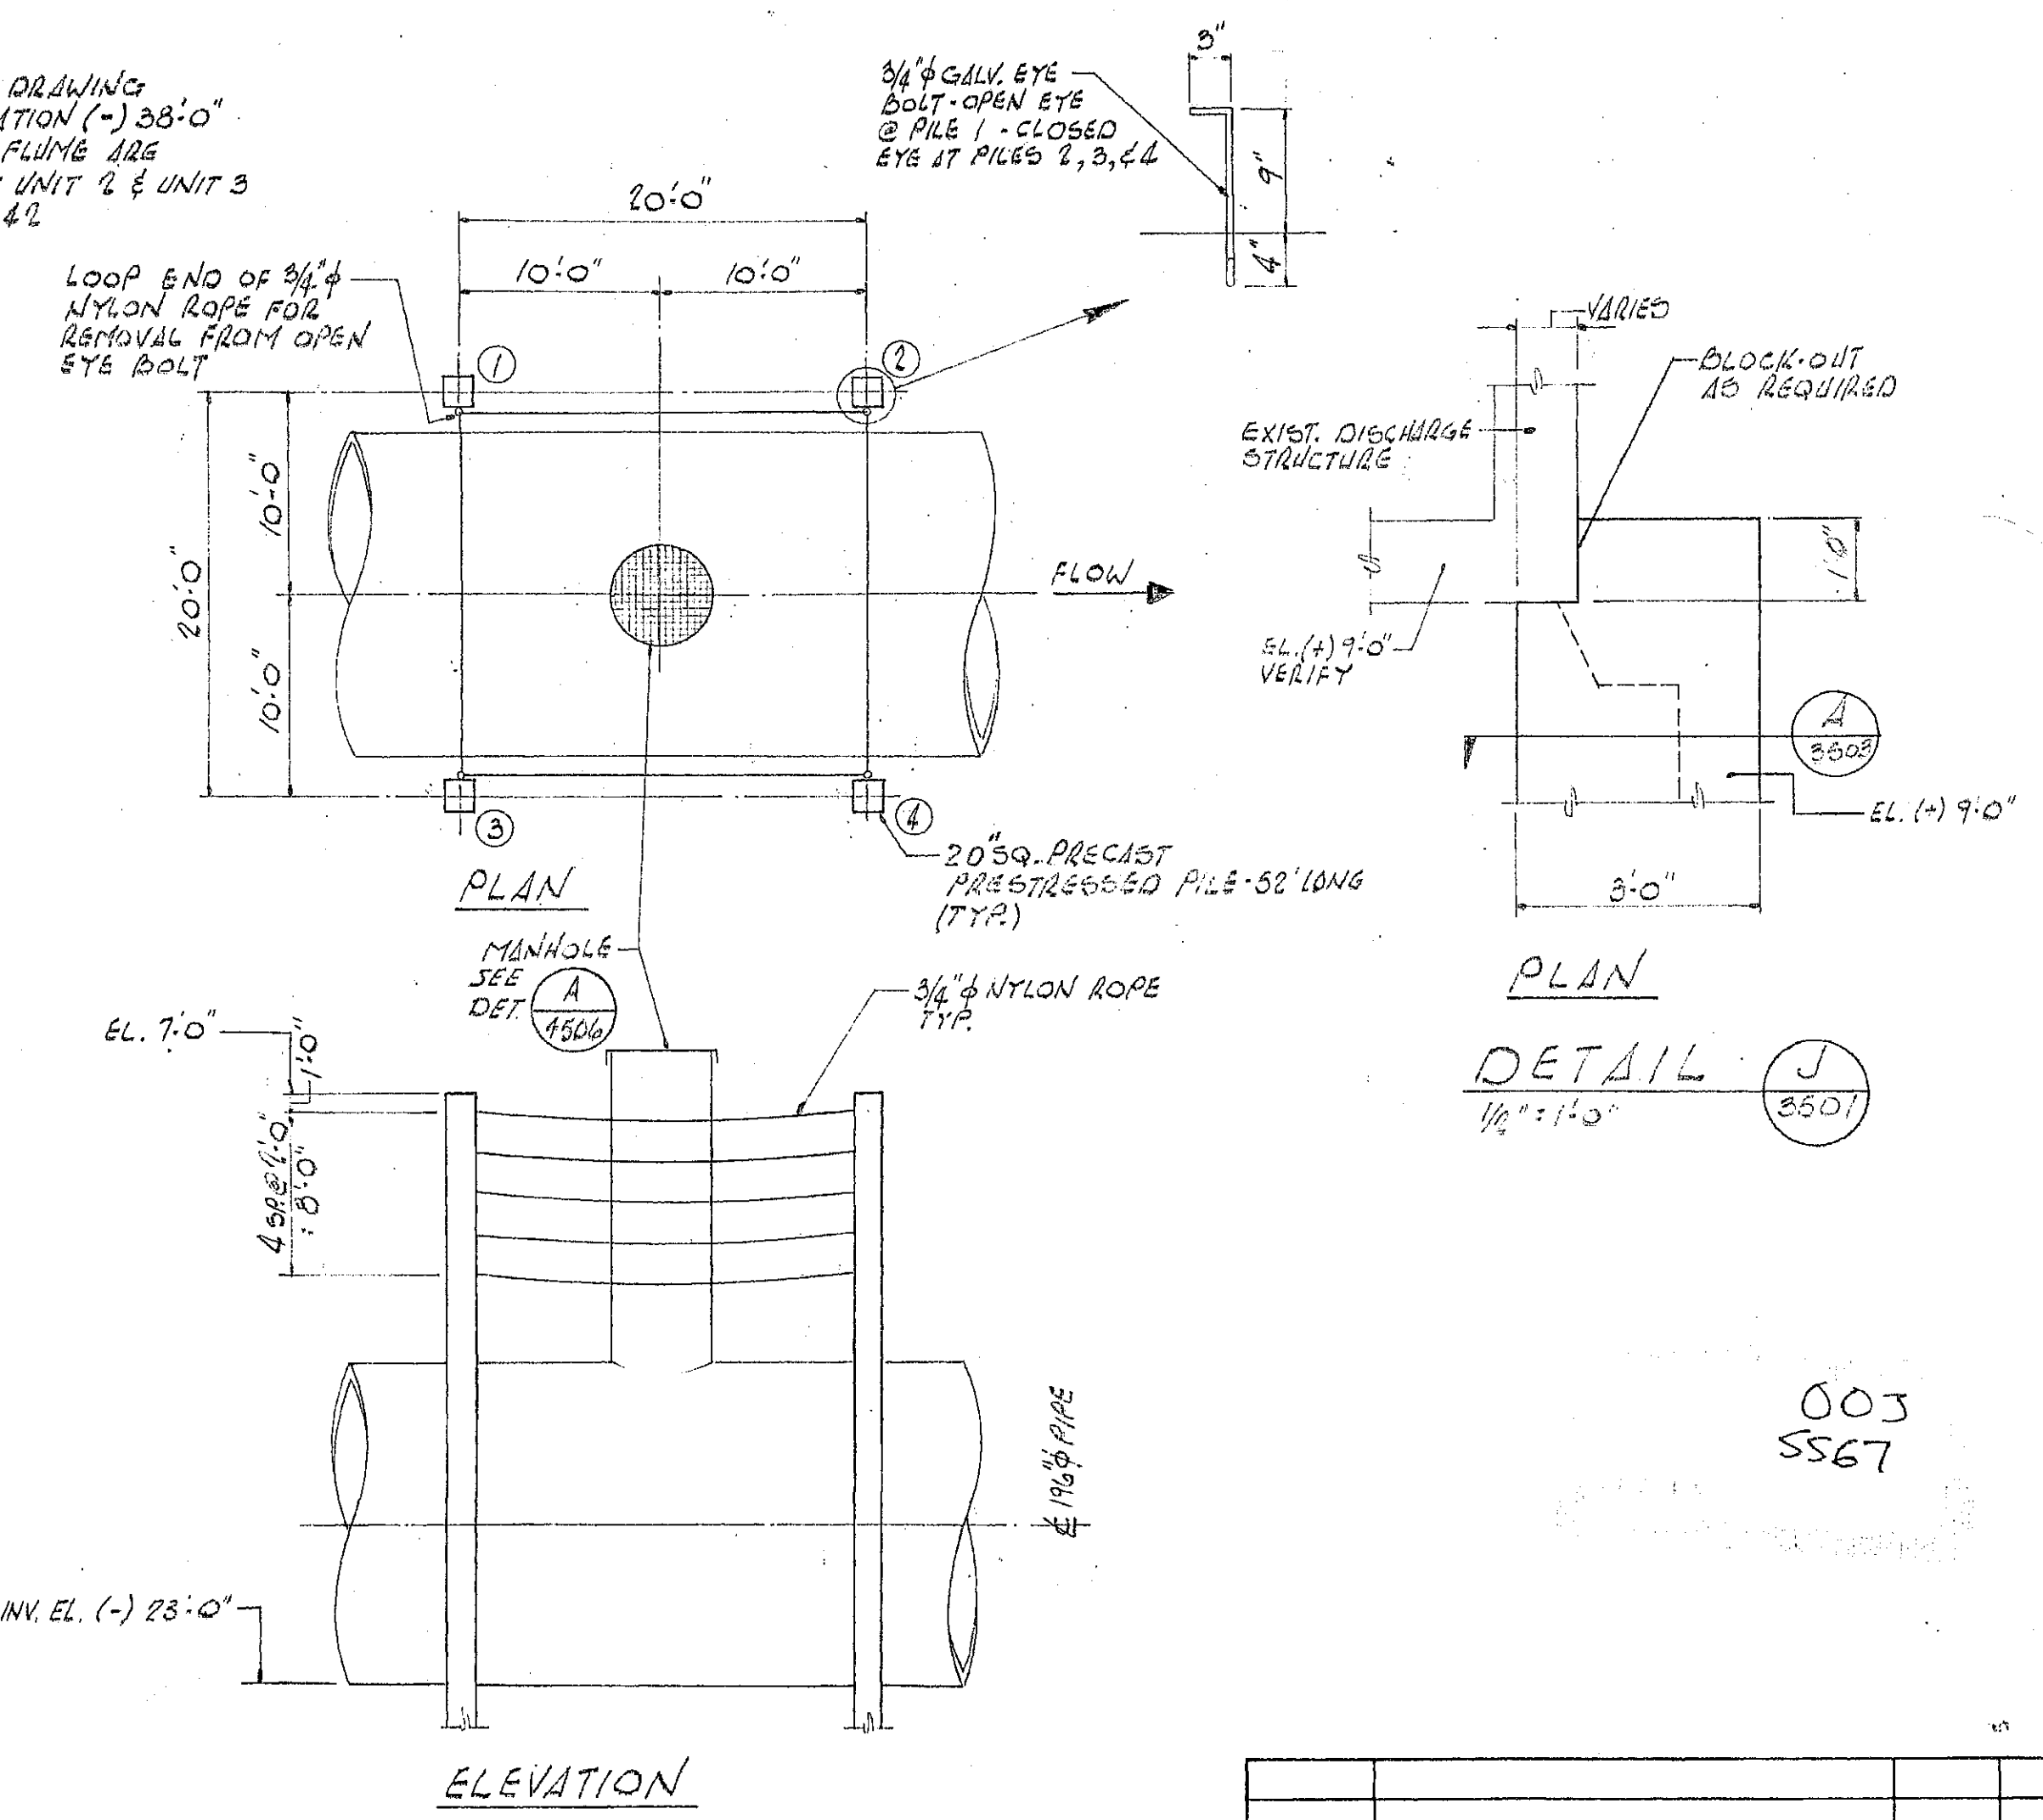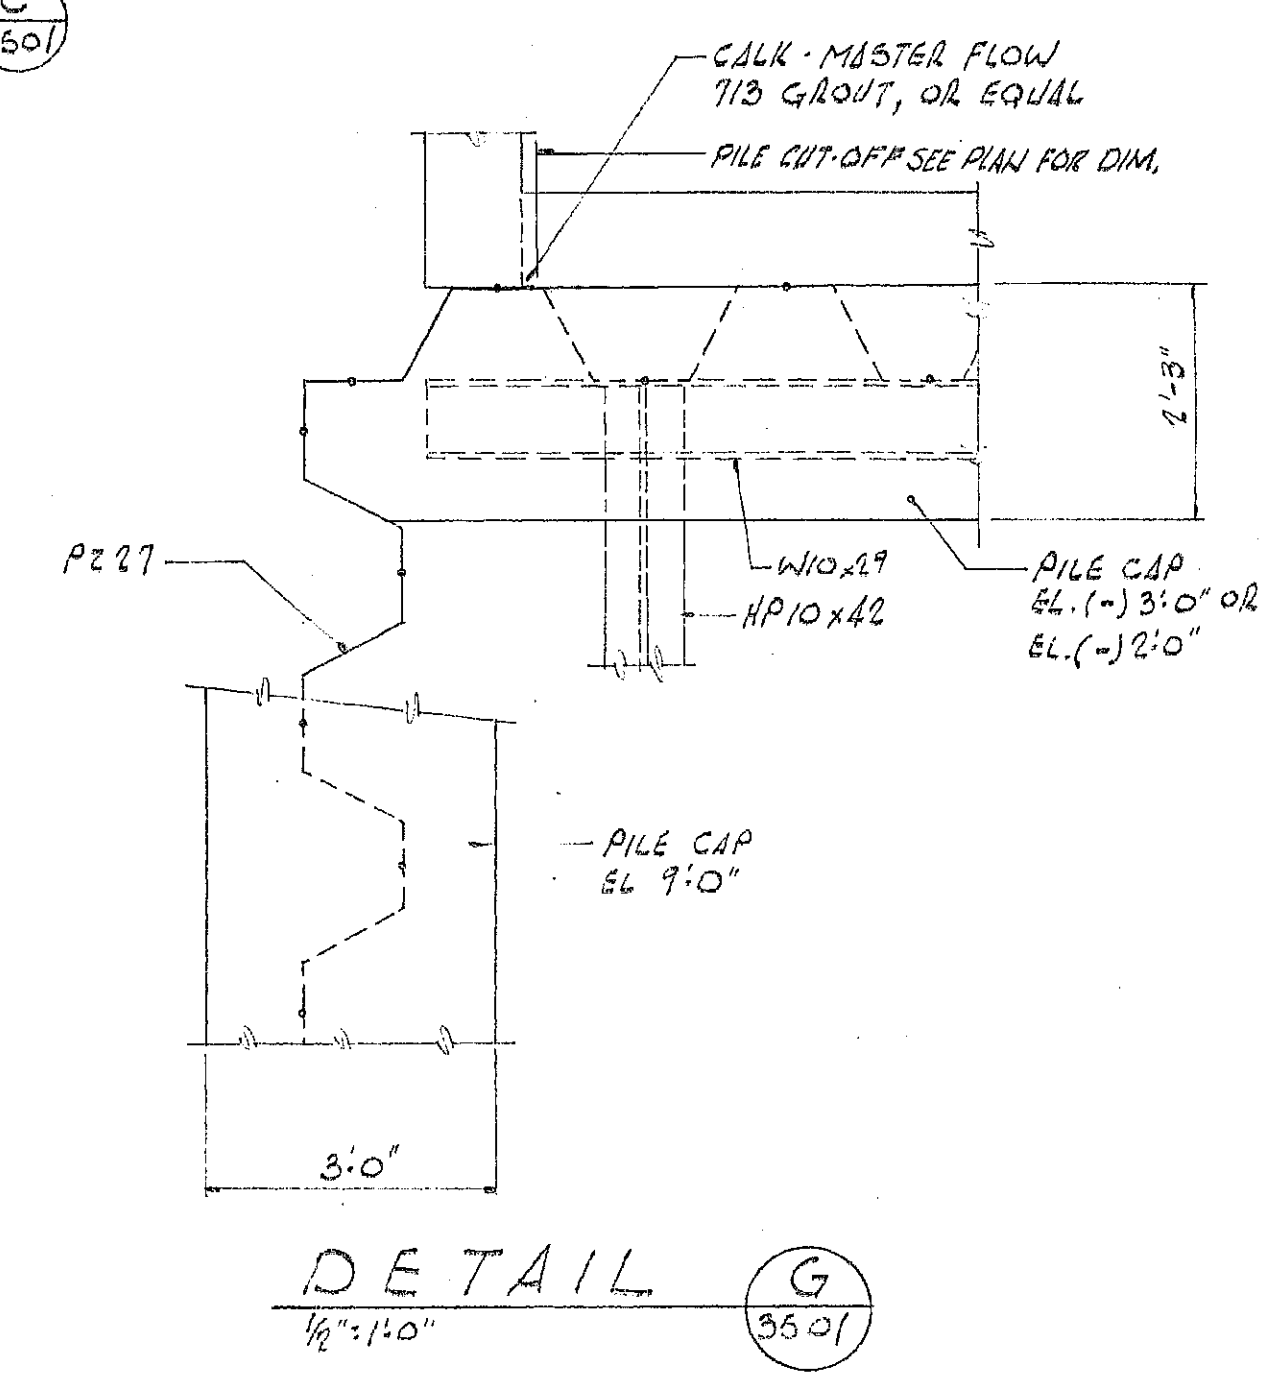

- NOTES:**
1. PROVIDE 1/4" WIDE X 1" DEEP CONTROL JOINTS AROUND SHEET, PILE CAPS AT EL. OF BATTER PILE 18'-0" O.C. MAX.
  2. PROVIDE CONSTRUCTION JOINTS IN CAPS AT CONTROL JOINTS AT 100'-0" O.C. MAX. WITH VERT. 2" DEEP X 12" WIDE X 1'-8" LONG KEY (TYP.).

REVISION	DESCRIPTION	DATE	BY	APPROVED	DEPARTMENT HEAD	MANAGING DIRECTOR	SHEET	OF
0	UPDATED FOR RECORD SET	11-20-75						
1	UPDATED TO INCLUDE LOG # 4	2-6-76	C.R.P.	A.S.G.				

009205  
 SPEC. NO. 76146-000C

**REYNOLDS, SMITH AND HILLS**  
 ARCHITECTS-ENGINEERS-PLANNERS, INCORPORATED JACKSONVILLE, FLORIDA

**JACKSONVILLE ELECTRIC AUTHORITY**  
 JACKSONVILLE, FLORIDA  
 NORTHSIDE GENERATING STATION  
 THERMAL DISCHARGE  
 PLAN - DISCHARGE BASIN - SH. 1

DATE: JUNE, 1977

APPROVED FOR REYNOLDS, SMITH AND HILLS

FOR THE JACKSONVILLE ELECTRIC AUTHORITY  
 DEPARTMENT HEAD: ENGINEERING DEPARTMENT  
 MANAGING DIRECTOR

DRAWING NO. 76146 D 3501

NOTE:  
REMOVE TOP SLAB TO BE  
PLACED BUTTER PILE.  
REPLACE TO ORIGINAL  
CONDITION AFTER COMPLETION  
OF DRIVING.







DISCHARGE FLUME - UNIT No 1

**DESIGN CRITERIA**

- (ALL DESIGN PER "CITY OF JACKSONVILLE BUILDING CODE" UNLESS OTHERWISE NOTED)
- LIVE LOADS  
FLOOR THROUGH WALKWAYS ..... 50#/S.F.  
MAXIMUM SOIL COVER OVER PIPE - 3 FT. .... 3 CL./FT.  
MAXIMUM SOIL COVER OVER 12" & PIPE - 10 FT. .... 10 S.F./FT.
  - ALLOWABLE UNIT STRESSES  
CONCRETE (DESIGN PER CURRENT EDITION A.I.C.) ..... 4000 PSI  
PRESTRESSED CONCRETE PILES ..... 4000 PSI  
PRESTRESSED CONCRETE TEES ..... 4000 PSI  
ALL OTHER (UNLESS OTHERWISE NOTED) ..... 4000 PSI  
STRUCTURAL STEEL (DESIGN PER CURRENT EDITION A.I.C.)  
ALL STEEL ASTM 1 & 2 UNLESS OTHERWISE NOTED.  
STEEL H PILES: USS MARINEER STEEL A.S.T.M. A1310  
STEEL SHEET PILES: USS MARINEER STEEL A.S.T.M. A1310  
PILE BEARINGS (DESIGN MINIMUM)  
H PILES (UNLESS OTHERWISE NOTED) ..... 50 TONS/PILE  
H PILES UNDER SEAL SLABS ..... 70 TONS/PILE  
CONCRETE PILES SUPPORTING PIPE ..... 100 TONS/PILE

**GENERAL STRUCTURAL NOTES**

- UNLESS OTHERWISE SHOWN ON DRAWINGS, MINIMUM COVER FOR REINFORCING SHALL BE AS FOLLOWS:  
CAP BEAMS ..... 2"  
WALLS (EXPOSED TO WEATHER OR IN CONTACT WITH GROUND) ..... 3"  
BEAMS (OVER MAIN REINFORCING) ..... 4"
- ALL REINFORCING SHALL BE HELD SECURELY IN POSITION WITH STANDARD ACCESSORIES DURING PLACING OF THE CONCRETE.
- SPICES IN REINFORCING, WHERE PERMITTED, SHALL BE AS FOLLOWS:  
TEMPERATURE REINFORCING ..... 12"  
ALL OTHER ..... 40 BAR DIA.
- REINFORCING IN BEAMS RUNNING IN EAST & WEST DIRECTION SHALL BE PLACED IN THE OUTER LAYER AT INTERSECTION WITH NORTH & SOUTH BEAMS.
- SPICES IN TOP REINFORCING SHALL BE MADE AT MID SPAN.
- SPICES IN BOTTOM REINFORCING SHALL BE MADE OVER SUPPORTS.
- ALL HIGH STRENGTH BOLTS TO BE 3/4" DIA. A.S.T.M. A307, UNLESS OTHERWISE NOTED.
- MINIMUM SIZE OF ALL FILLET WELDS SHALL CONFORM TO SECTION 1.17.5 A.I.C. SPECIFICATIONS EVEN THOUGH SHOWN OTHERWISE ON DRAWINGS.
- CONTRACTOR SHALL VERIFY ALL EXISTING DIMENSIONS AND CONDITIONS OF EXISTING STRUCTURE AND SITE THAT ARE AFFECTED BY NEW WORK BEFORE PROCEEDING WITH FABRICATION & CONSTRUCTION.
- ALL STRUCTURAL OPENINGS AROUND ARE AFFECTED BY MECHANICAL AND ELECTRICAL EQUIPMENT SHALL BE VERIFIED WITH EQUIPMENT PURCHASED BEFORE PROCEEDING WITH STRUCTURAL WORK AFFECTED.
- SEE ELECTRICAL AND MECHANICAL DRAWINGS FOR OPENINGS, ELEVETS, ETC. NOT SHOWN ON STRUCTURAL DRAWINGS.
- ALL ANGLES, BARS, ANCHORS, ANCHOR BOLTS, ETC. EMBEDDED IN CONCRETE SHALL BE HOT-DIPPED GALVANIZED AFTER FABRICATION.
- IF COFFERDAM IS ENLARGED, AN ADDITIONAL HP12x53 BEARING PILE SHALL BE PROVIDED FOR EACH ADDITIONAL 32 SQUARE FEET OF SEAL SLAB AREA. MAXIMUM SPACING OF PILES SHALL NOT EXCEED 6'-0" AND GENERAL ARRANGEMENT SHALL CONFORM TO THAT SHOWN ON THE DRAWINGS. CONTRACTOR SHALL SUBMIT REVISED LAYOUT TO THE ENGINEER FOR APPROVAL BEFORE STARTING CONSTRUCTION. THIS WORK SHALL BE DONE AT NO ADDITIONAL COST TO THE OWNER. THIS NOTE APPLYS TO DISCHARGE HEADWALL ONLY.
- THE 16 FT. WIDE BRIDGE ADJACENT TO THE EXISTING INTAKE FLUME WAS DESIGNED FOR H2O LOADING.

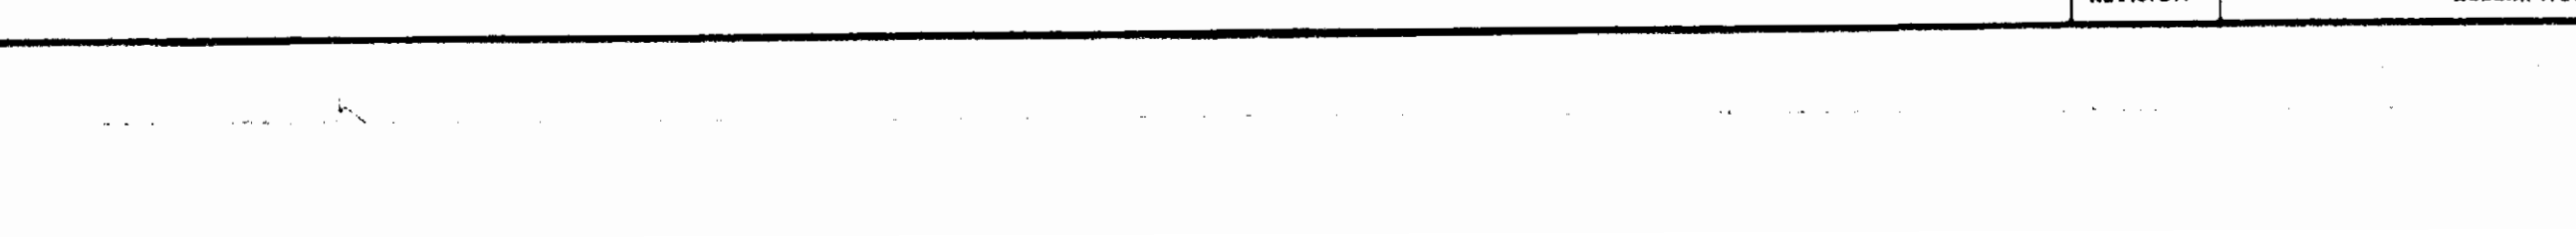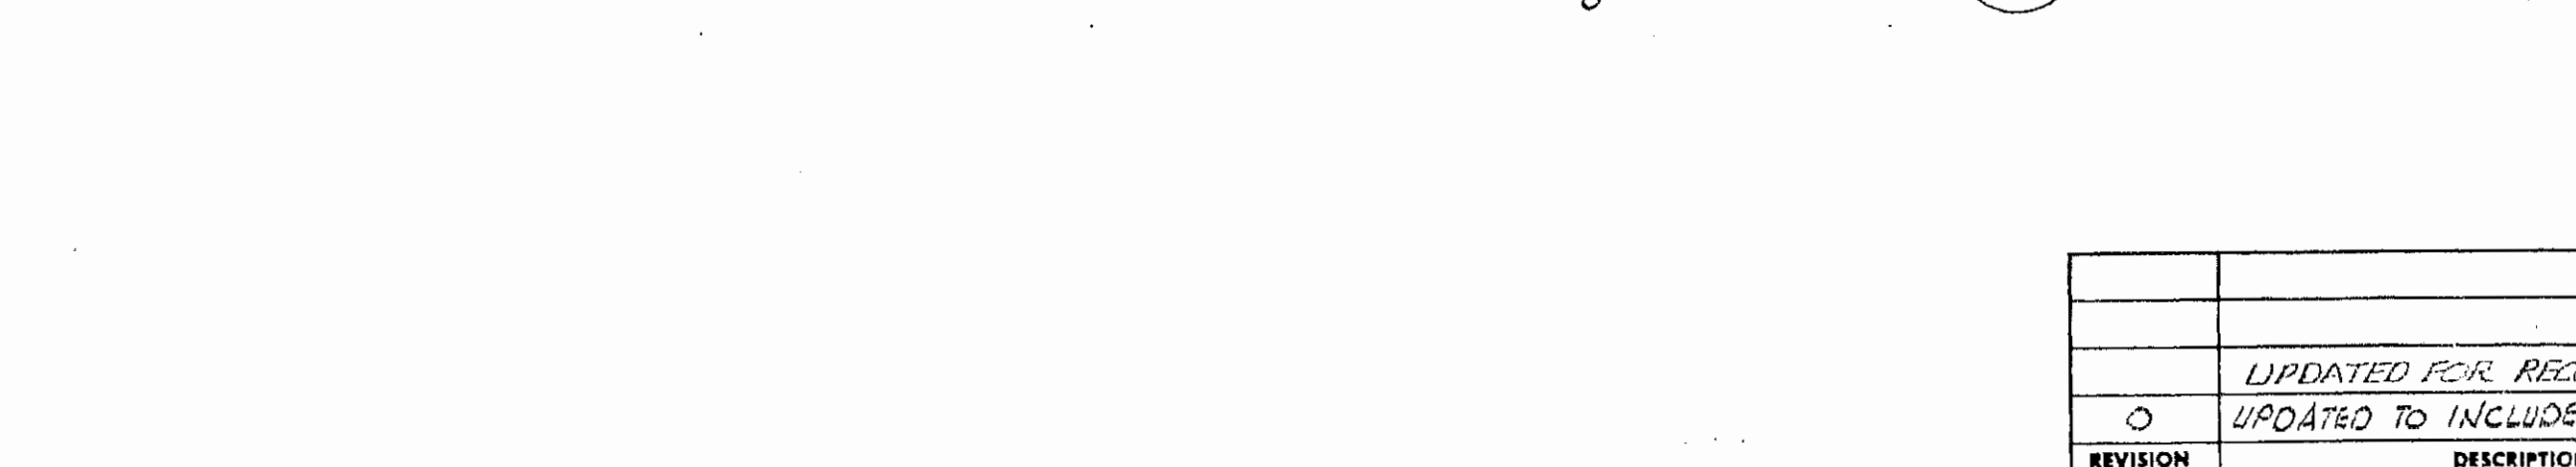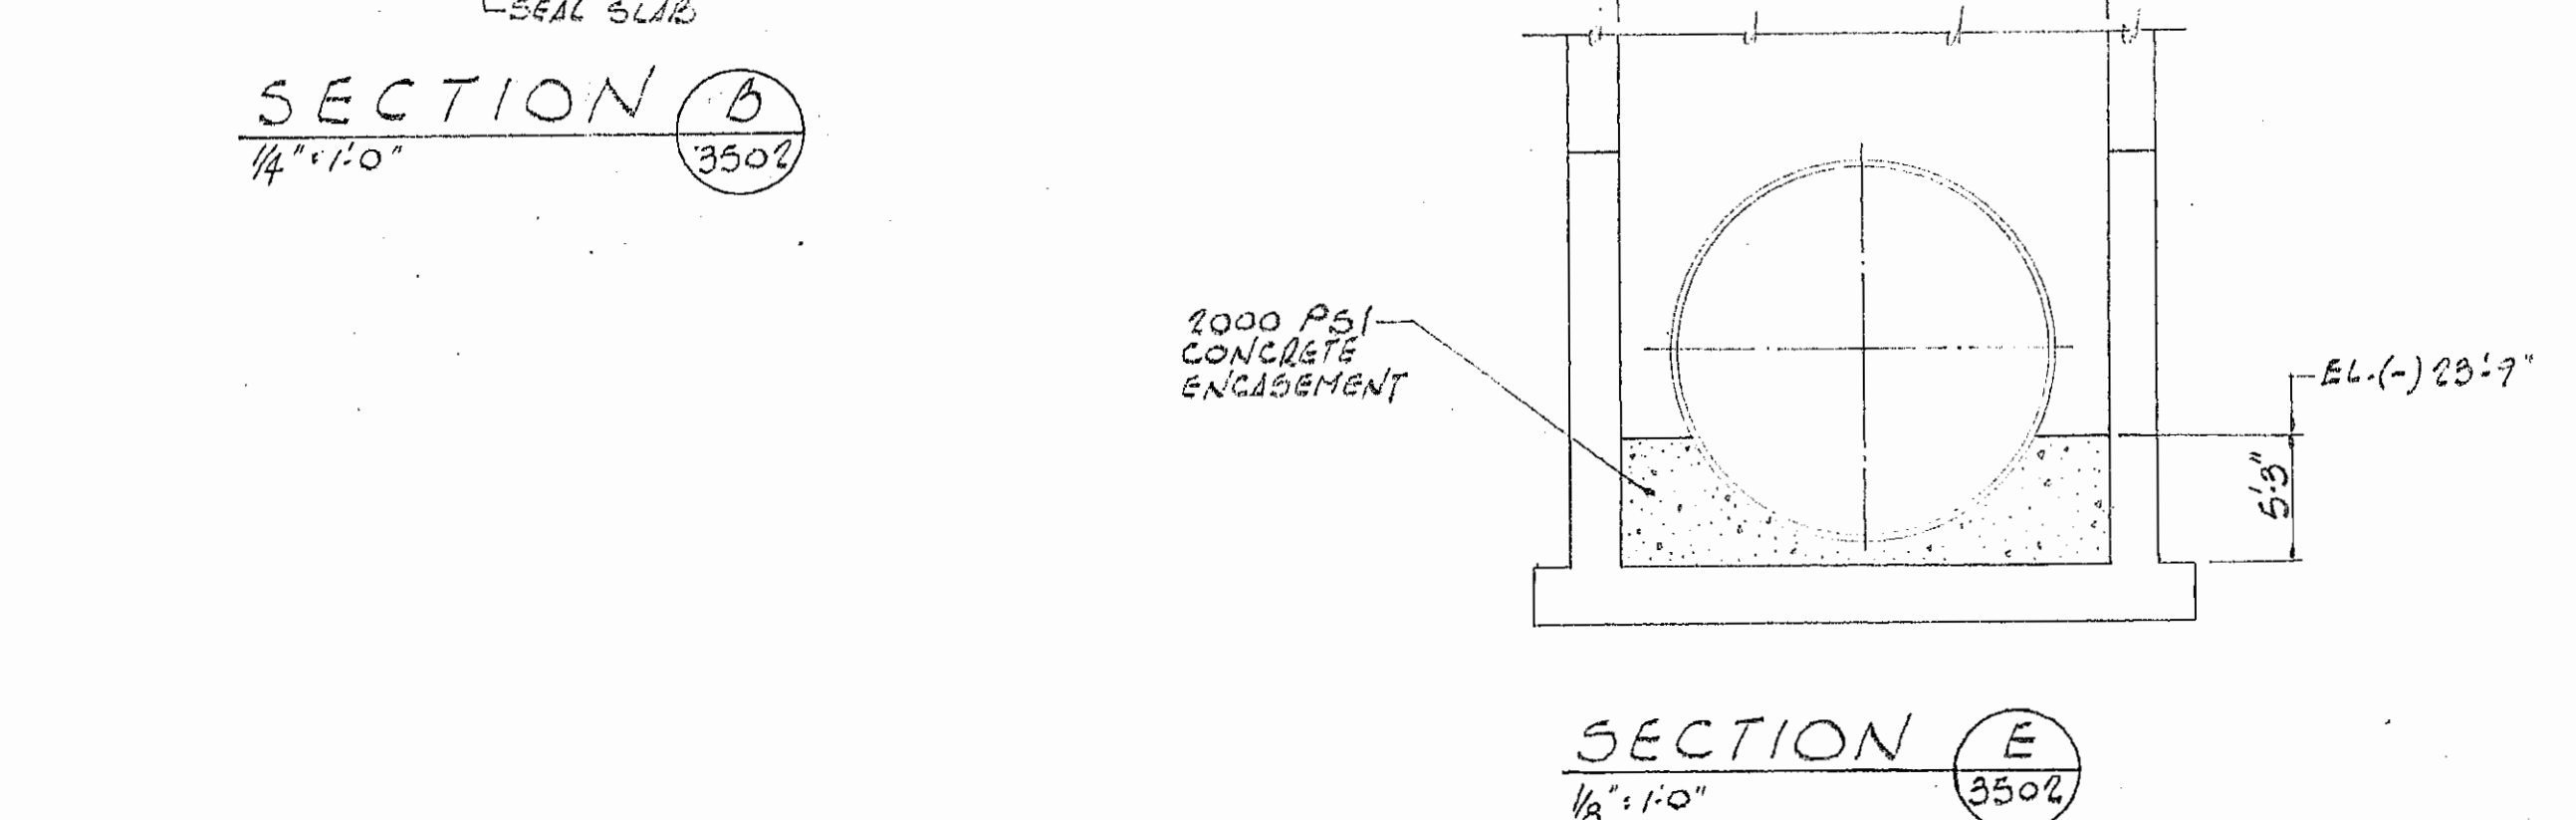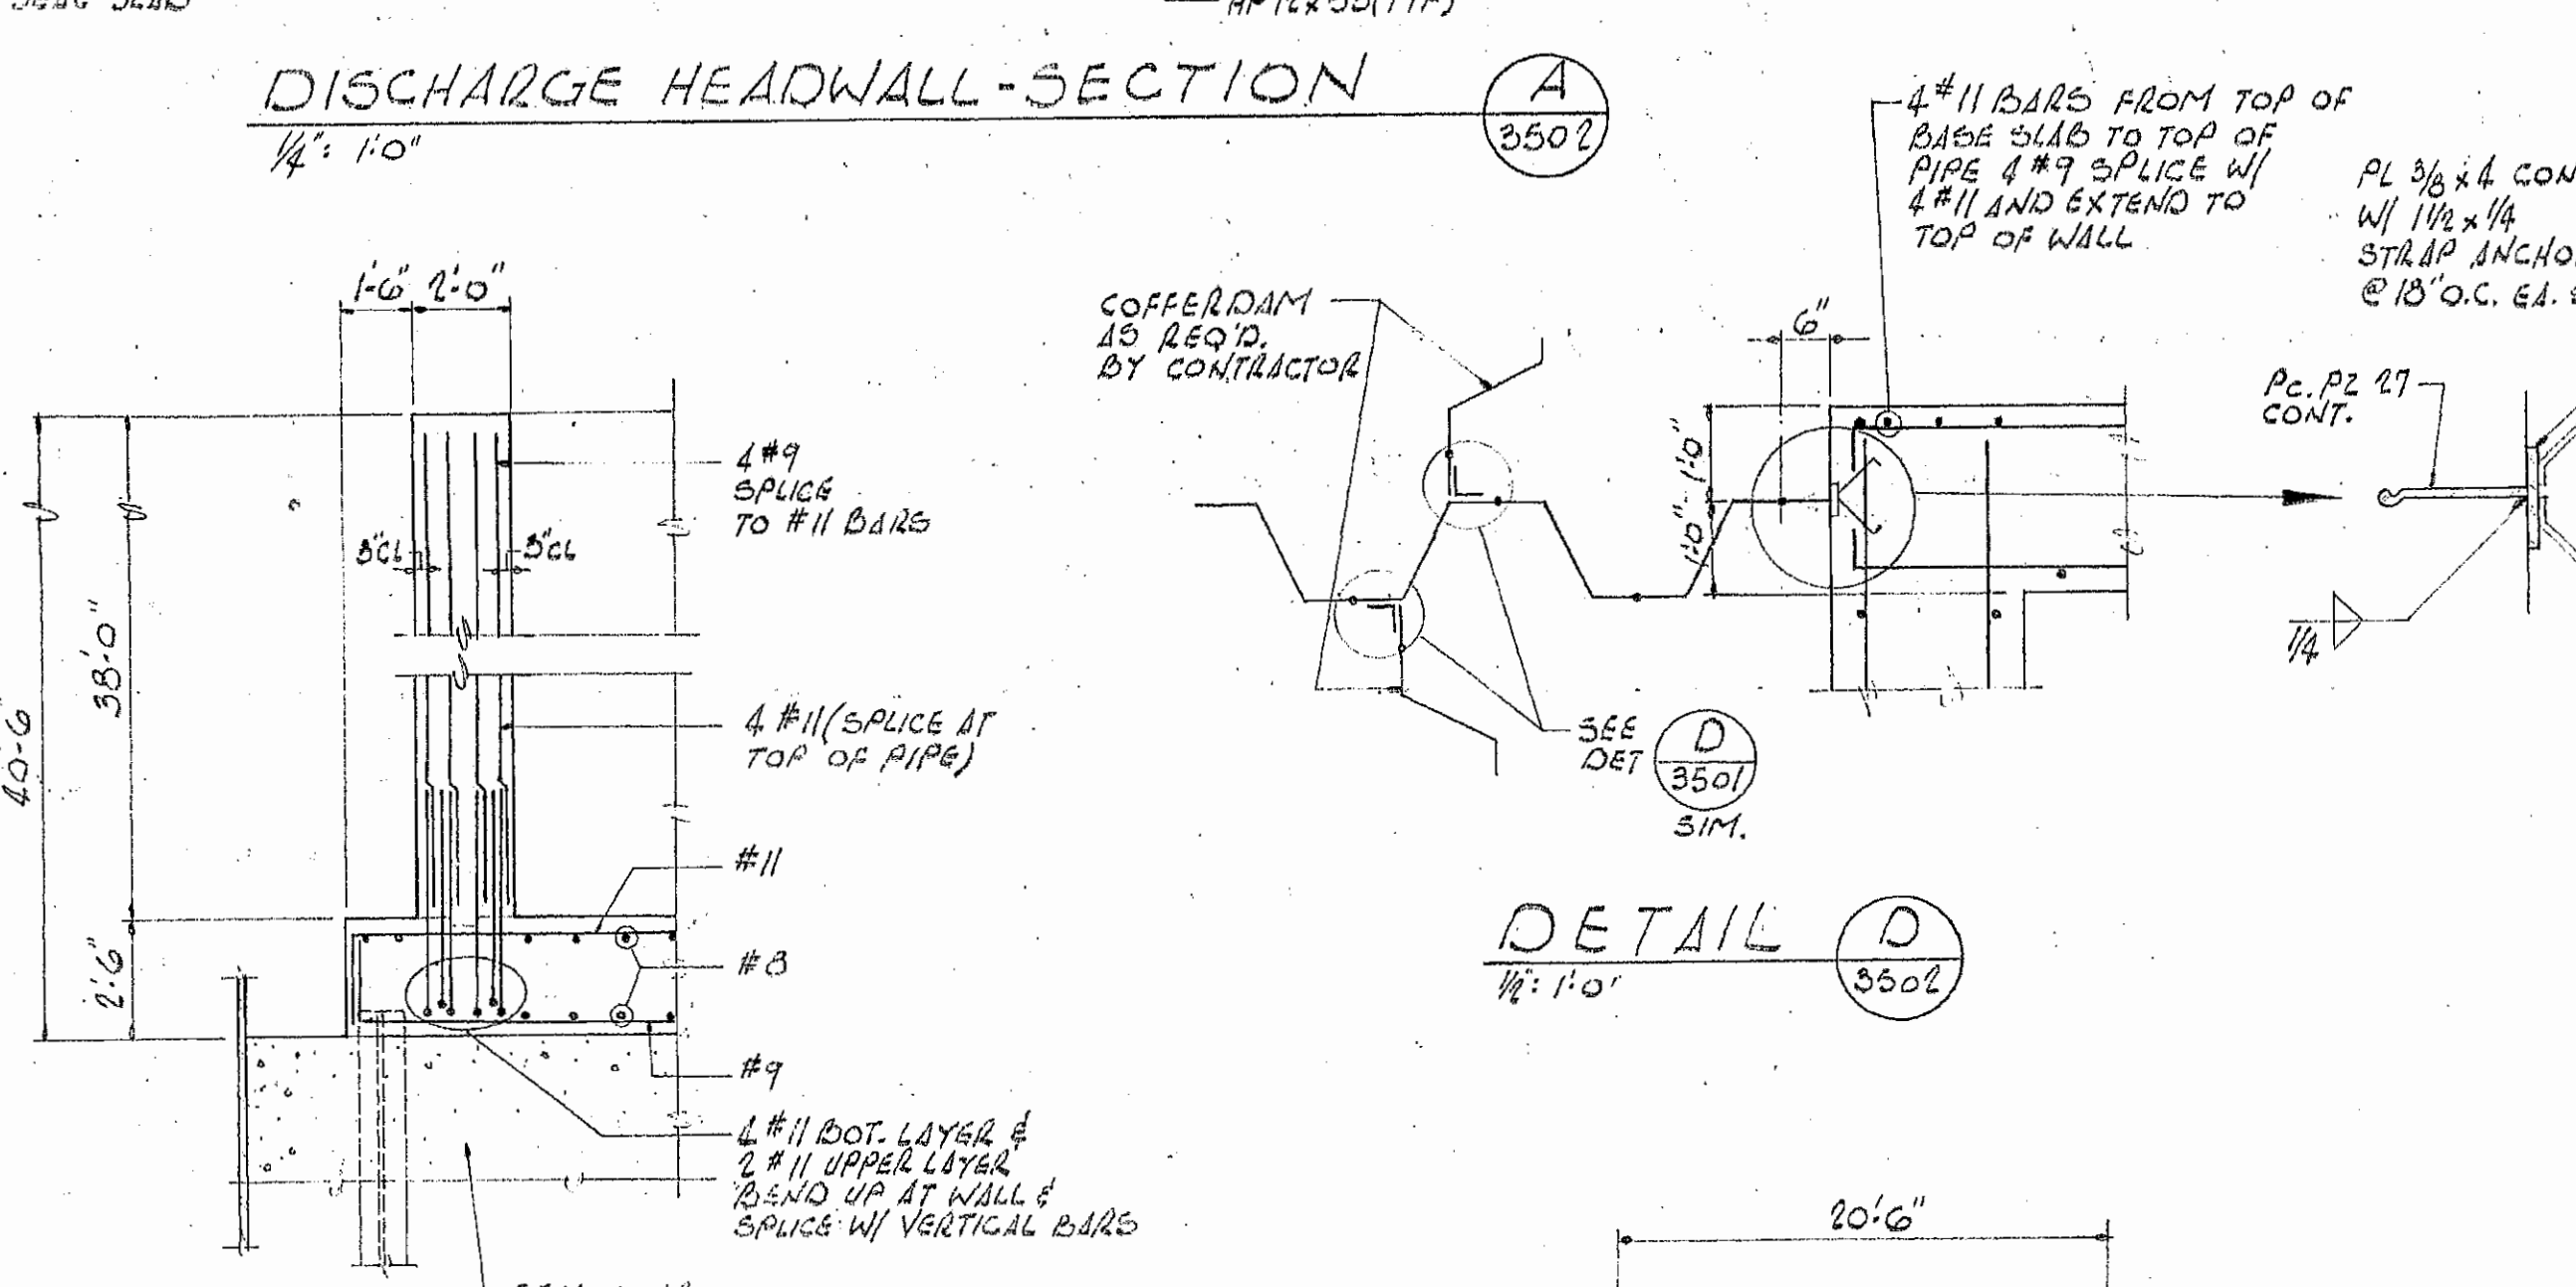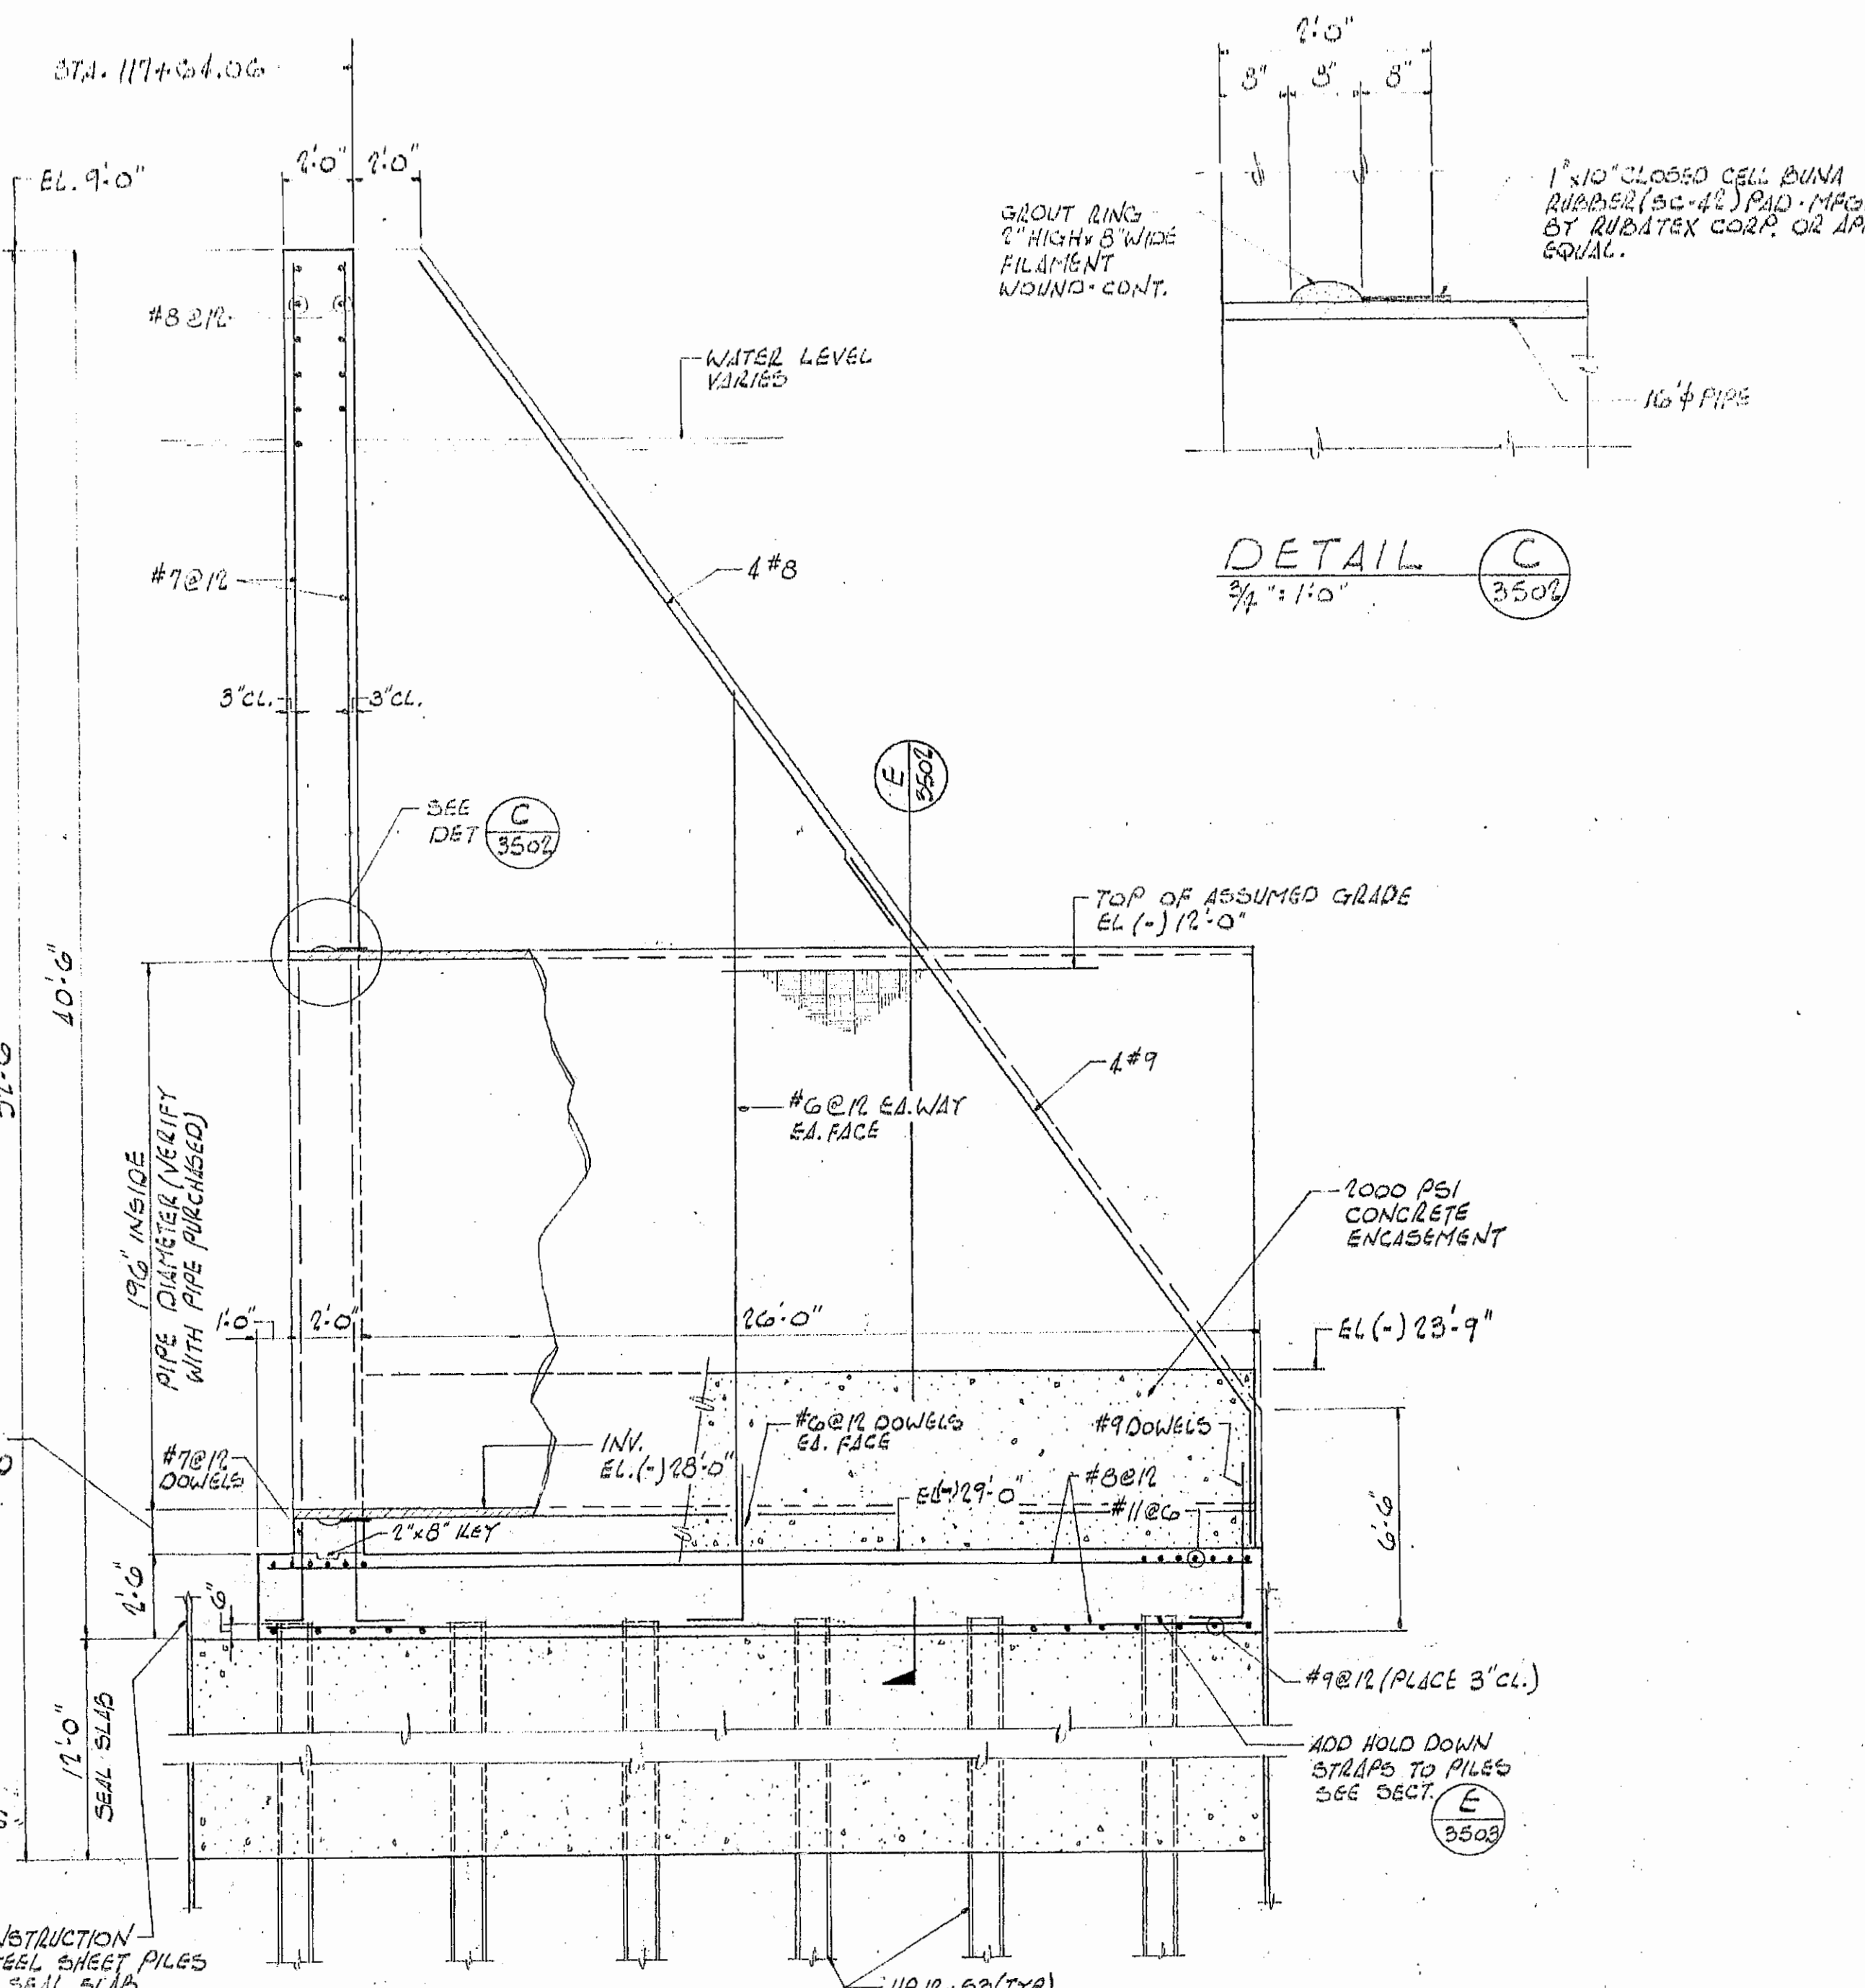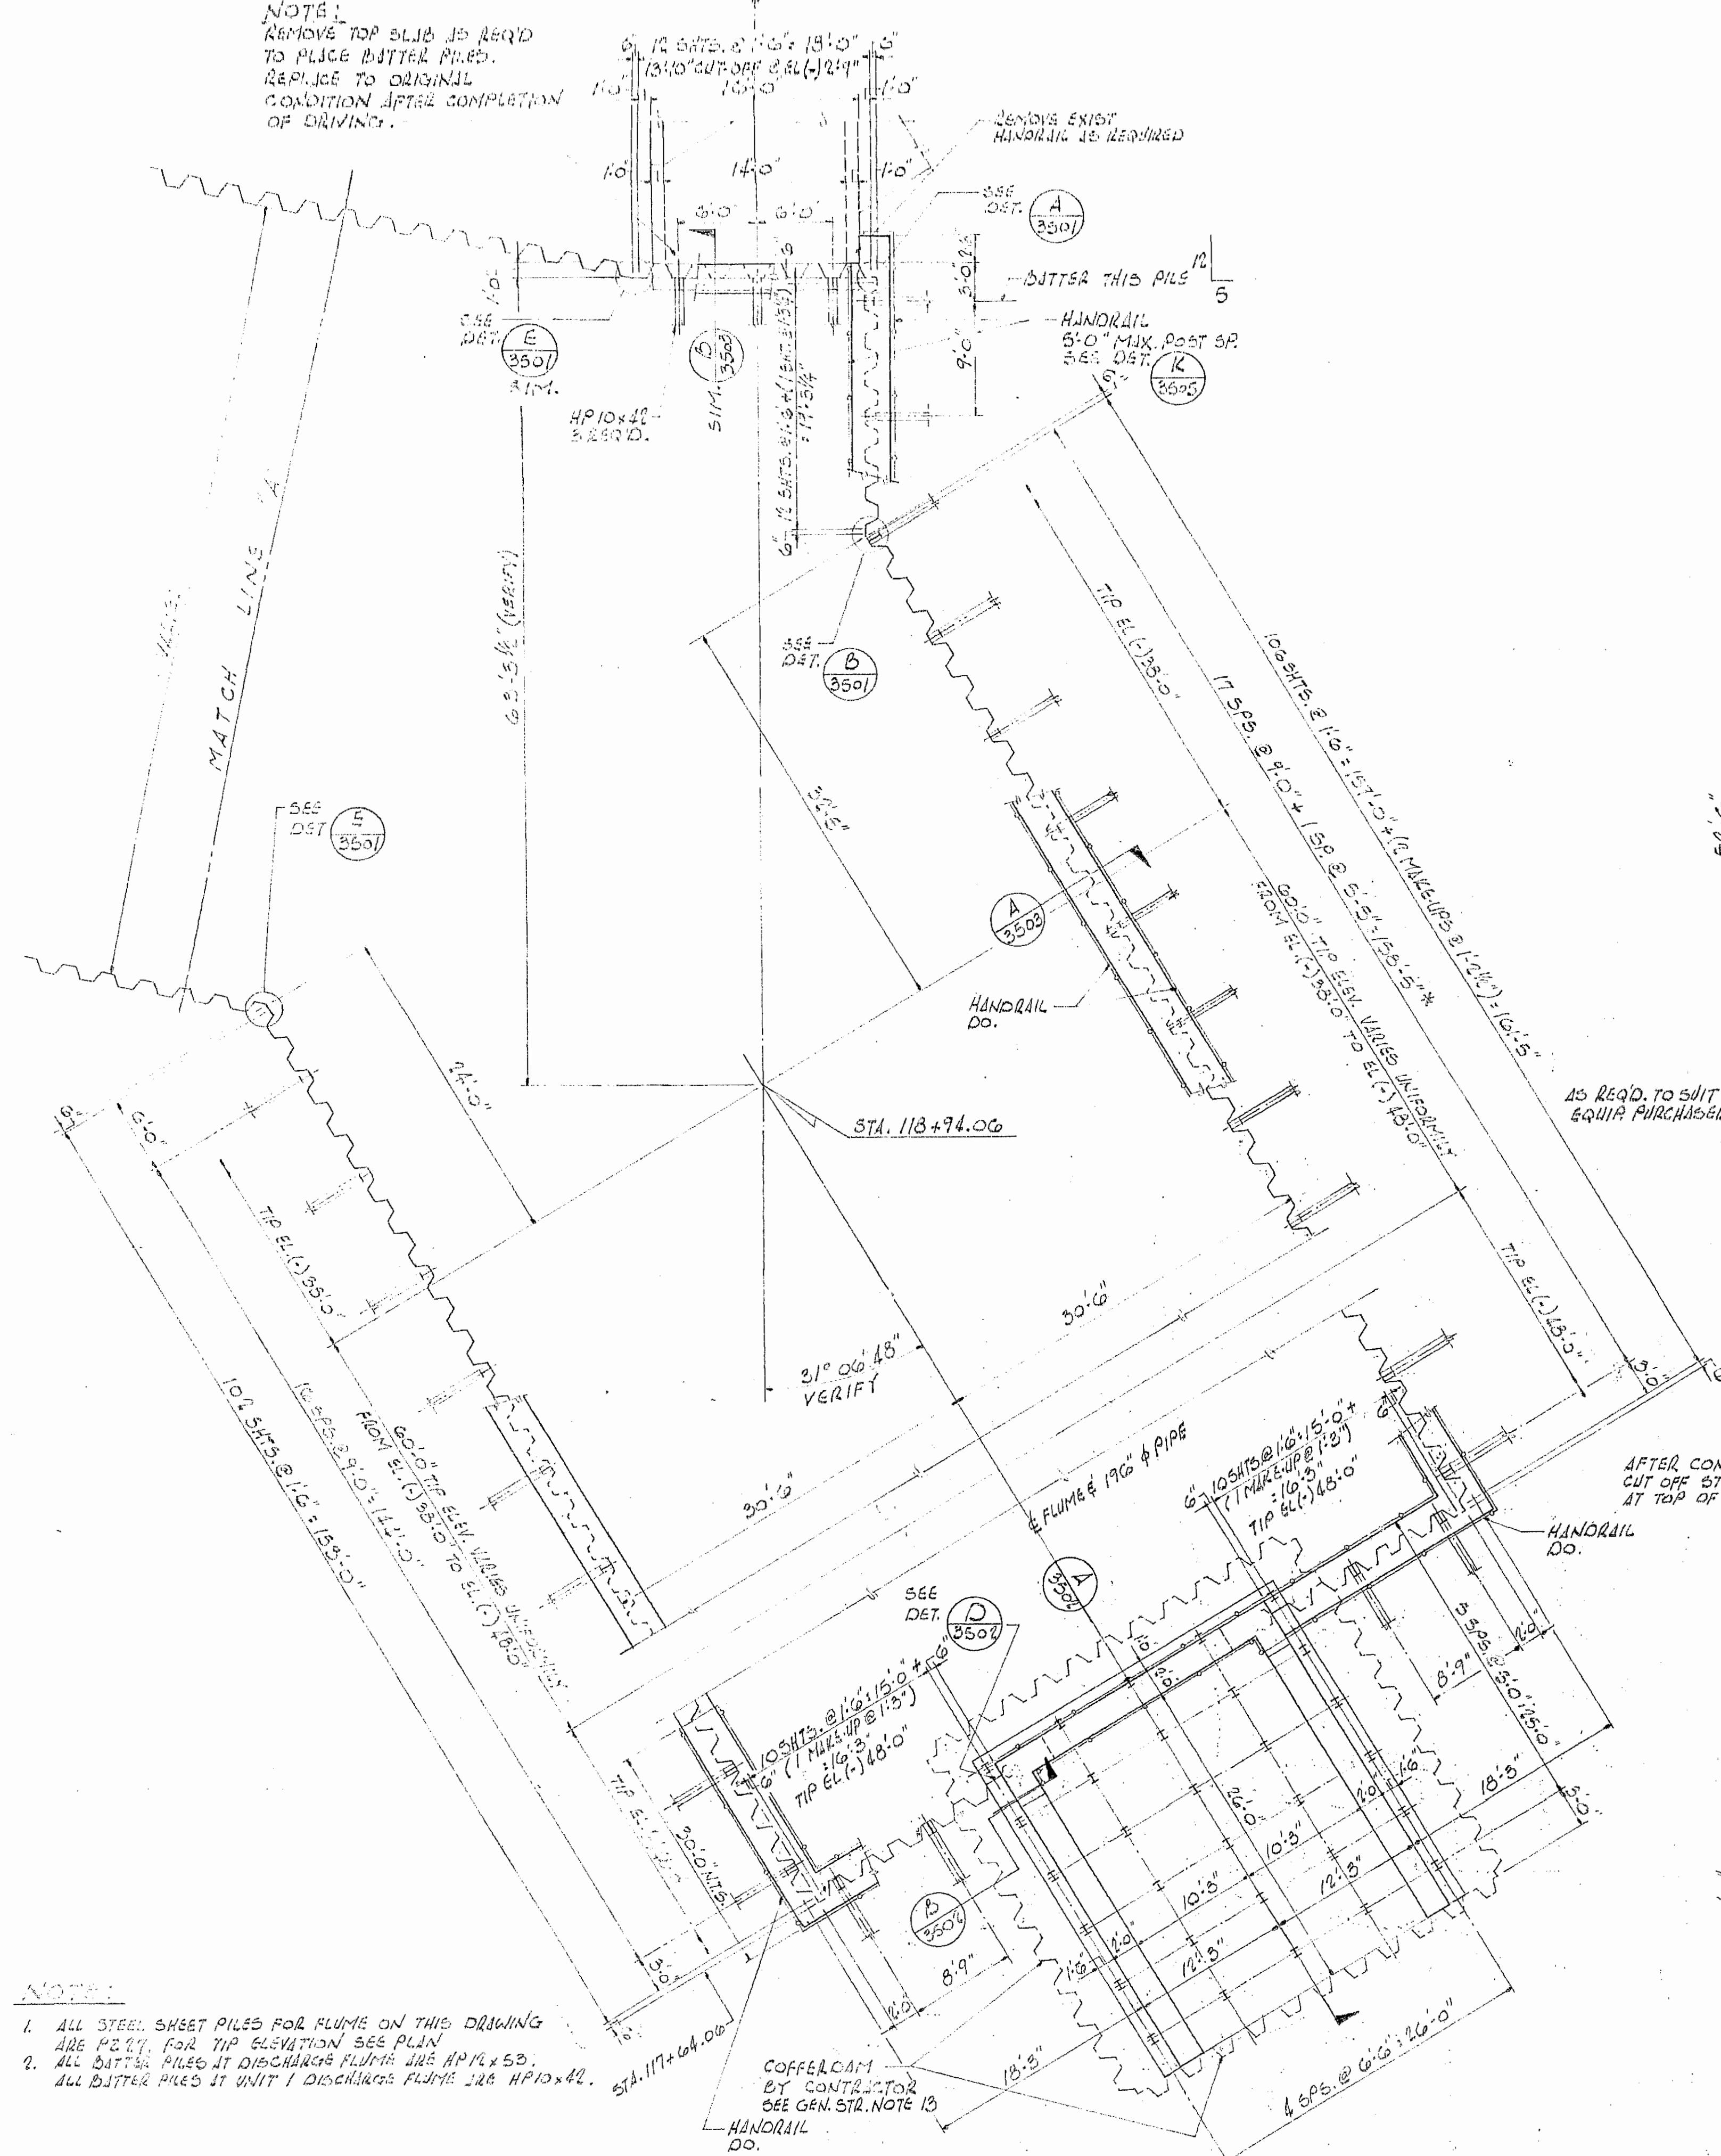

003  
5568

009206

REYNOLDS, SMITH AND HILLS  
ARCHITECTS-ENGINEERS-PLANNERS, INCORPORATED JACKSONVILLE, FLORIDA

JACKSONVILLE ELECTRIC AUTHORITY  
NORTHSIDE GENERATING STATION  
THERMAL DISCHARGE

PLAN - DISCHARGE BASIN - SH. 2


APPROVED FOR REYNOLDS, SMITH AND HILLS

FOR THE JACKSONVILLE ELECTRIC AUTHORITY

DEPARTMENT HEAD: ENGINEERING DEPARTMENT

DRAWING NO. 76146 D 3502

REVISION	DESCRIPTION	DATE	BY	APPROVED
0	UPDATED FOR RECORD SET	11-20-77		
1	UPDATED TO INCLUDE ADD #3, #4, #5, #99, #100	2-6-78	CEP	AGP

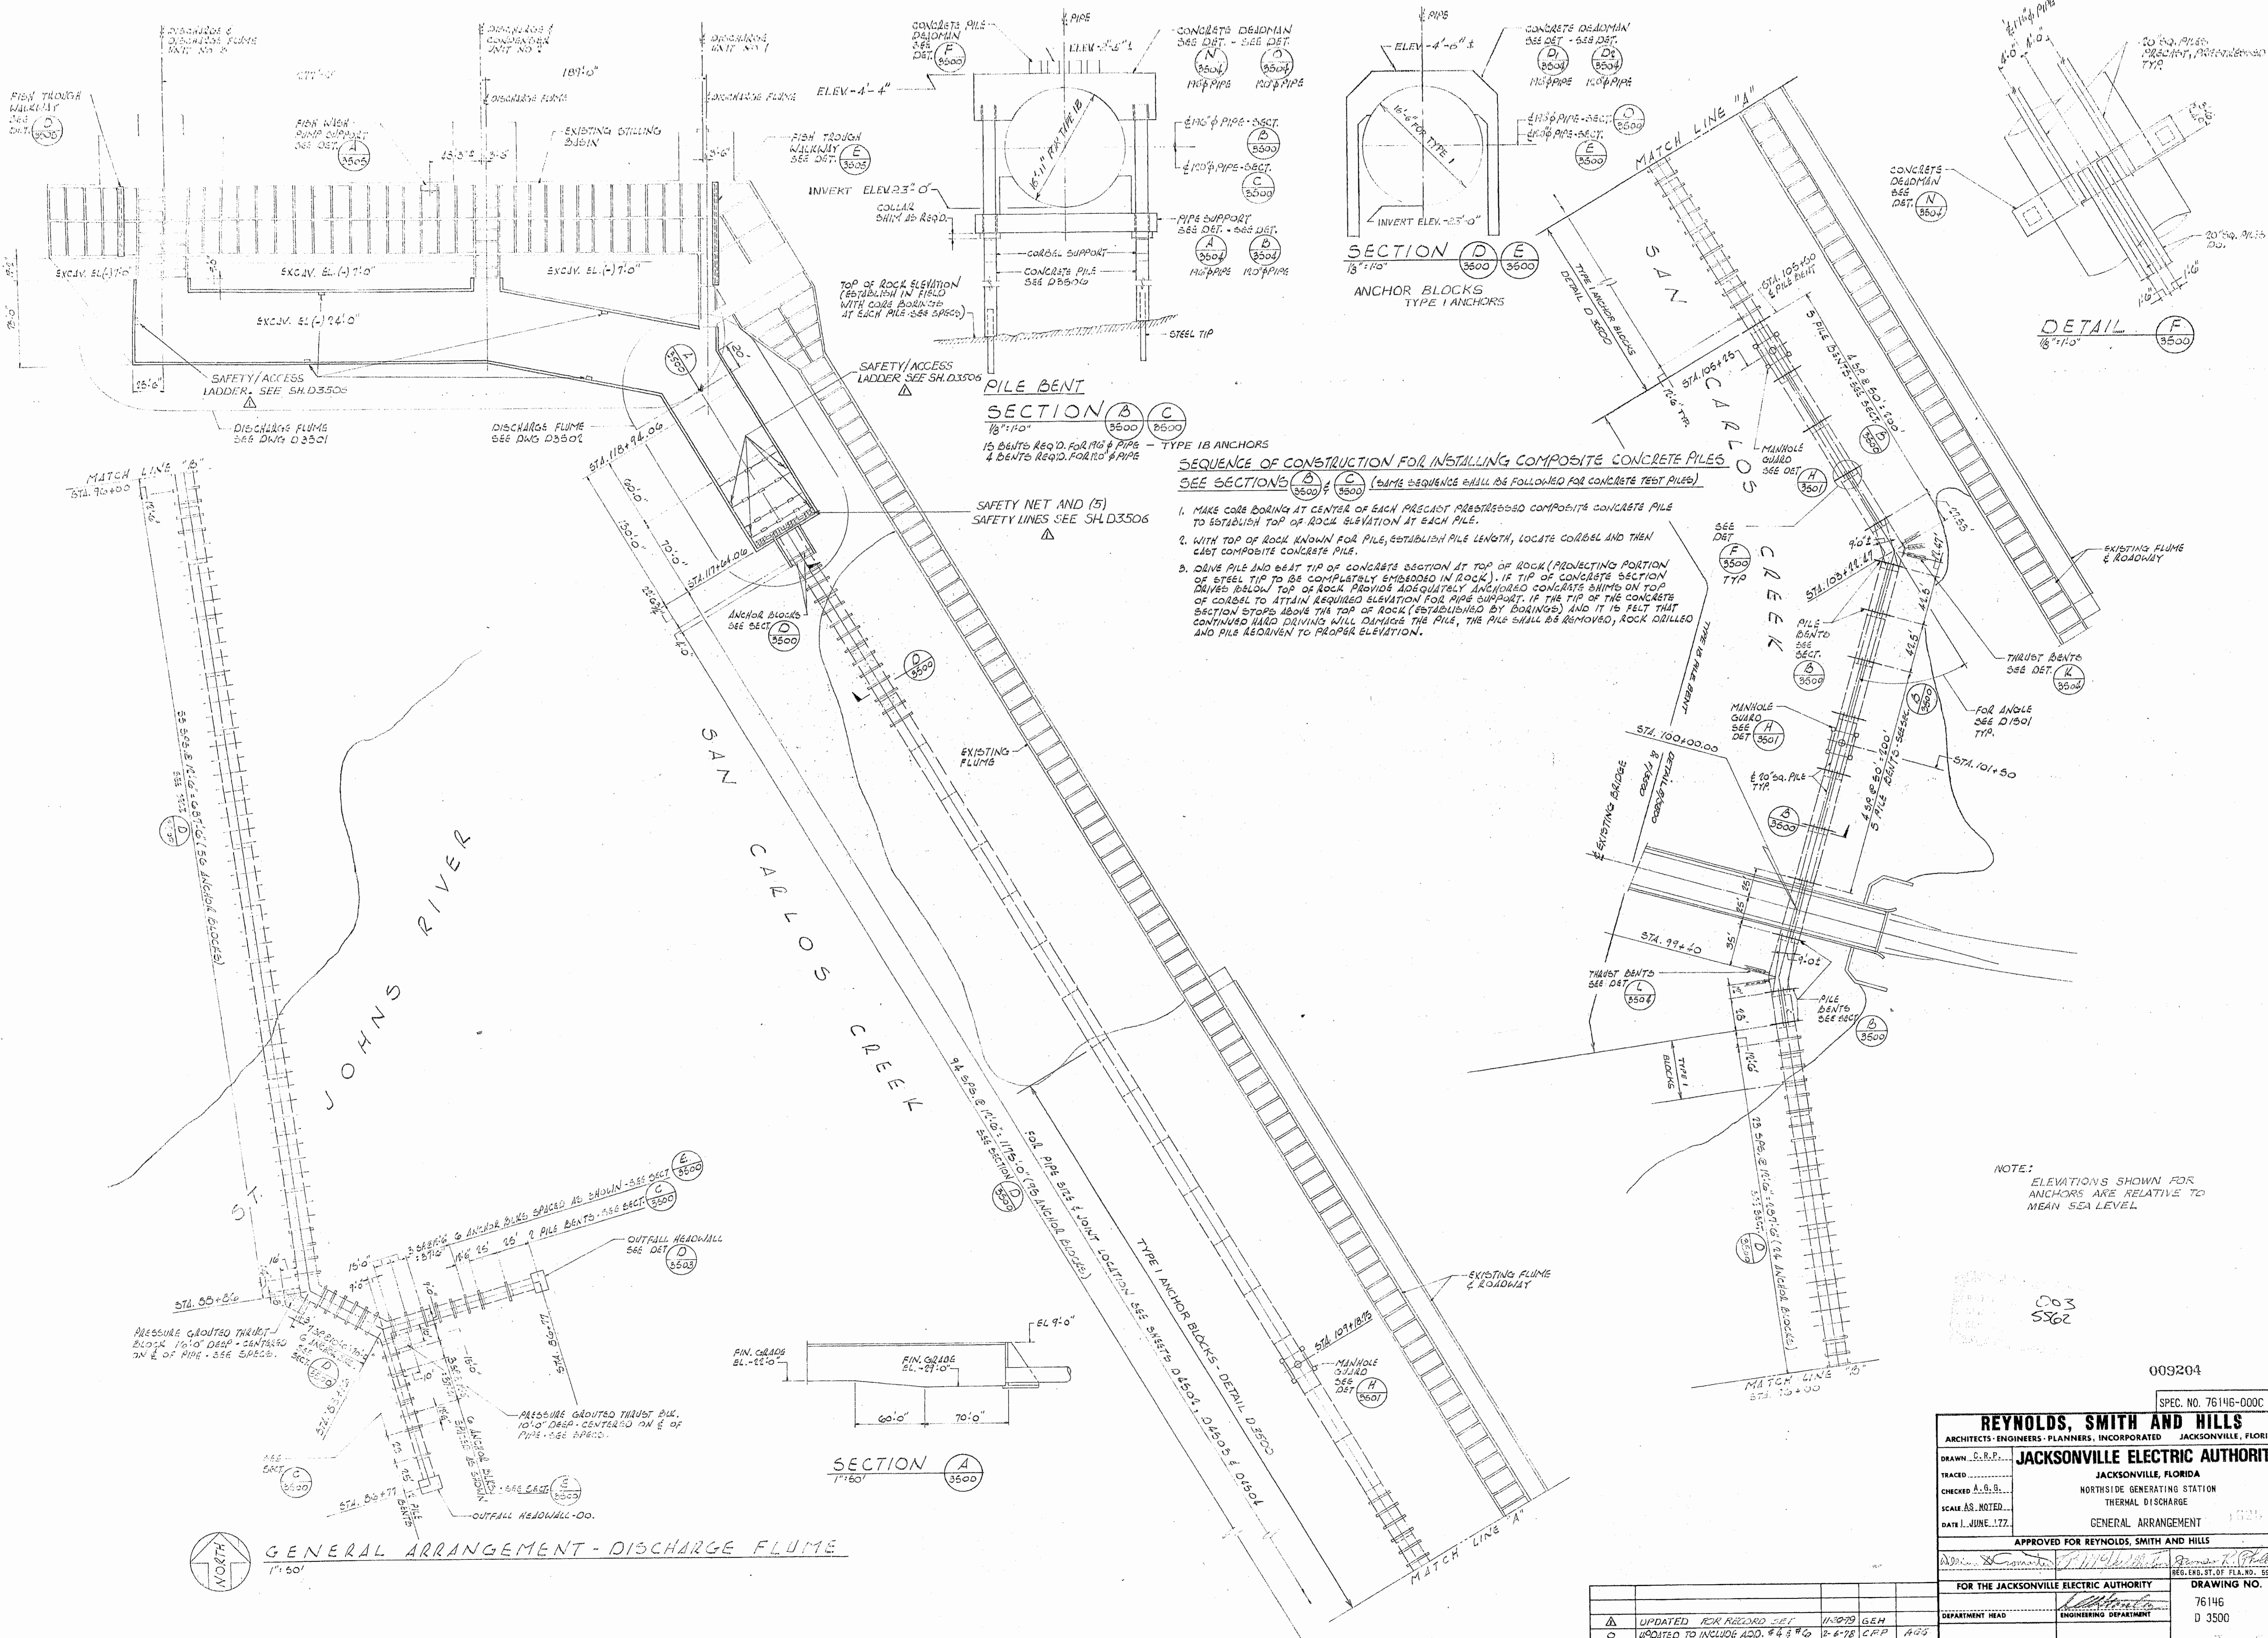

GENERAL ARRANGEMENT - DISCHARGE FLUME  
1" = 50'

PILE BENT  
SECTION B C  
1/8" = 10"  
15 BENTS REQ'D FOR 16" PIPE - TYPE 1B ANCHORS  
4 BENTS REQ'D FOR 10" PIPE

SEQUENCE OF CONSTRUCTION FOR INSTALLING COMPOSITE CONCRETE PILES  
SEE SECTIONS (A) (C) (E) (SAME SEQUENCE SHALL BE FOLLOWED FOR CONCRETE TEST PILES)

1. MAKE CORE BORING AT CENTER OF EACH PRECAST PRESTRESSED COMPOSITE CONCRETE PILE TO ESTABLISH TOP OF ROCK ELEVATION AT EACH PILE.
2. WITH TOP OF ROCK KNOWN FOR PILE, ESTABLISH PILE LENGTH, LOCATE CORBEL AND THEN CAST COMPOSITE CONCRETE PILE.
3. DRIVE PILE AND BEAT TIP OF CONCRETE SECTION AT TOP OF ROCK (PROJECTING PORTION OF STEEL TIP TO BE COMPLETELY EMBEDDED IN ROCK). IF TIP OF CONCRETE SECTION DRIVES BELOW TOP OF ROCK PROVIDE ADEQUATELY ANCHORED CONCRETE SHIMS ON TOP OF CORBEL TO ATTAIN REQUIRED ELEVATION FOR PIPE SUPPORT. IF THE TIP OF THE CONCRETE SECTION STOPS ABOVE THE TOP OF ROCK (ESTABLISHED BY BORING) AND IT IS FELT THAT CONTINUED HARD DRIVING WILL DAMAGE THE PILE, THE PILE SHALL BE REMOVED, ROCK DRILLED AND PILE REDRIVEN TO PROPER ELEVATION.

NOTE:  
ELEVATIONS SHOWN FOR ANCHORS ARE RELATIVE TO MEAN SEA LEVEL

003  
5562

009204

SPEC. NO. 76146-00C

**REYNOLDS, SMITH AND HILLS**  
ARCHITECTS-ENGINEERS-PLANNERS, INCORPORATED JACKSONVILLE, FLORIDA

**JACKSONVILLE ELECTRIC AUTHORITY**  
JACKSONVILLE, FLORIDA  
NORTHSIDE GENERATING STATION  
THERMAL DISCHARGE  
GENERAL ARRANGEMENT

DATE: JUNE, 1977

APPROVED FOR REYNOLDS, SMITH AND HILLS

FOR THE JACKSONVILLE ELECTRIC AUTHORITY

DEPARTMENT HEAD: ENGINEERING DEPARTMENT

MANAGING DIRECTOR

DRAWING NO. 76146 D 3500

REVISION: UPDATED FOR RECORD SET 11-30-79 GEH  
UPDATED TO INCLUDE ADD. # 4 & # 5 2-6-78 CRP AGS

DATE BY APPROVED DEPARTMENT HEAD MANAGING DIRECTOR SHEET 2 OF 2