

CONSTRUCTION DRAWINGS FOR ARGYLE FOREST BOULEVARD - PHASE 2 WATER AND SEWER ADJUSTMENT PLANS JACKSONVILLE, FLORIDA DUVAL COUNTY

JEA WORK ORDER NO.: 04321015

AS-BUILT

INDEX OF WATER AND SEWER PLANS	
SHEET NO.	SHEET DESCRIPTION
1	KEY SHEET
2	GENERAL NOTES
3	LEGEND AND ABBREVIATIONS
4	VACUUM TEST HOLE TABLE
5 - 25	WATER AND SEWER ADJUSTMENT PLANS
26 - 29	SEWER DETAILS
30 - 34	WATER DETAILS

BEGIN WATER & SEWER
ADJUSTMENT
EQUATION
STA. 303+00.00 BK=
STA. 00+00.00 AH

ENGINEER OF RECORD (WATER & SEWER):
FRANK E. GRAY JR., P.E. No. 43053
THE R-A-M PROFESSIONAL GROUP, INC.


SUBMITTED BY:
 THE R-A-M PROFESSIONAL GROUP, INC.
8298 BAYBERRY ROAD, SUITE 1 - JACKSONVILLE FLORIDA 32256 - (904) 731-5440
CIVIL AND ELECTRICAL ENGINEERING - LANDSCAPE ARCHITECTURE
CERT. OF AUTH. No: 00006489 - CERT. OF AUTH. No: LC26000197

APPROVAL RECOMMENDED BY:

CIVIL SERVICES INCORPORATED
2394 S. ST. JOHNS BLUFF ROAD, JACKSONVILLE, FLORIDA 32246

APPROVED BY:

JEA

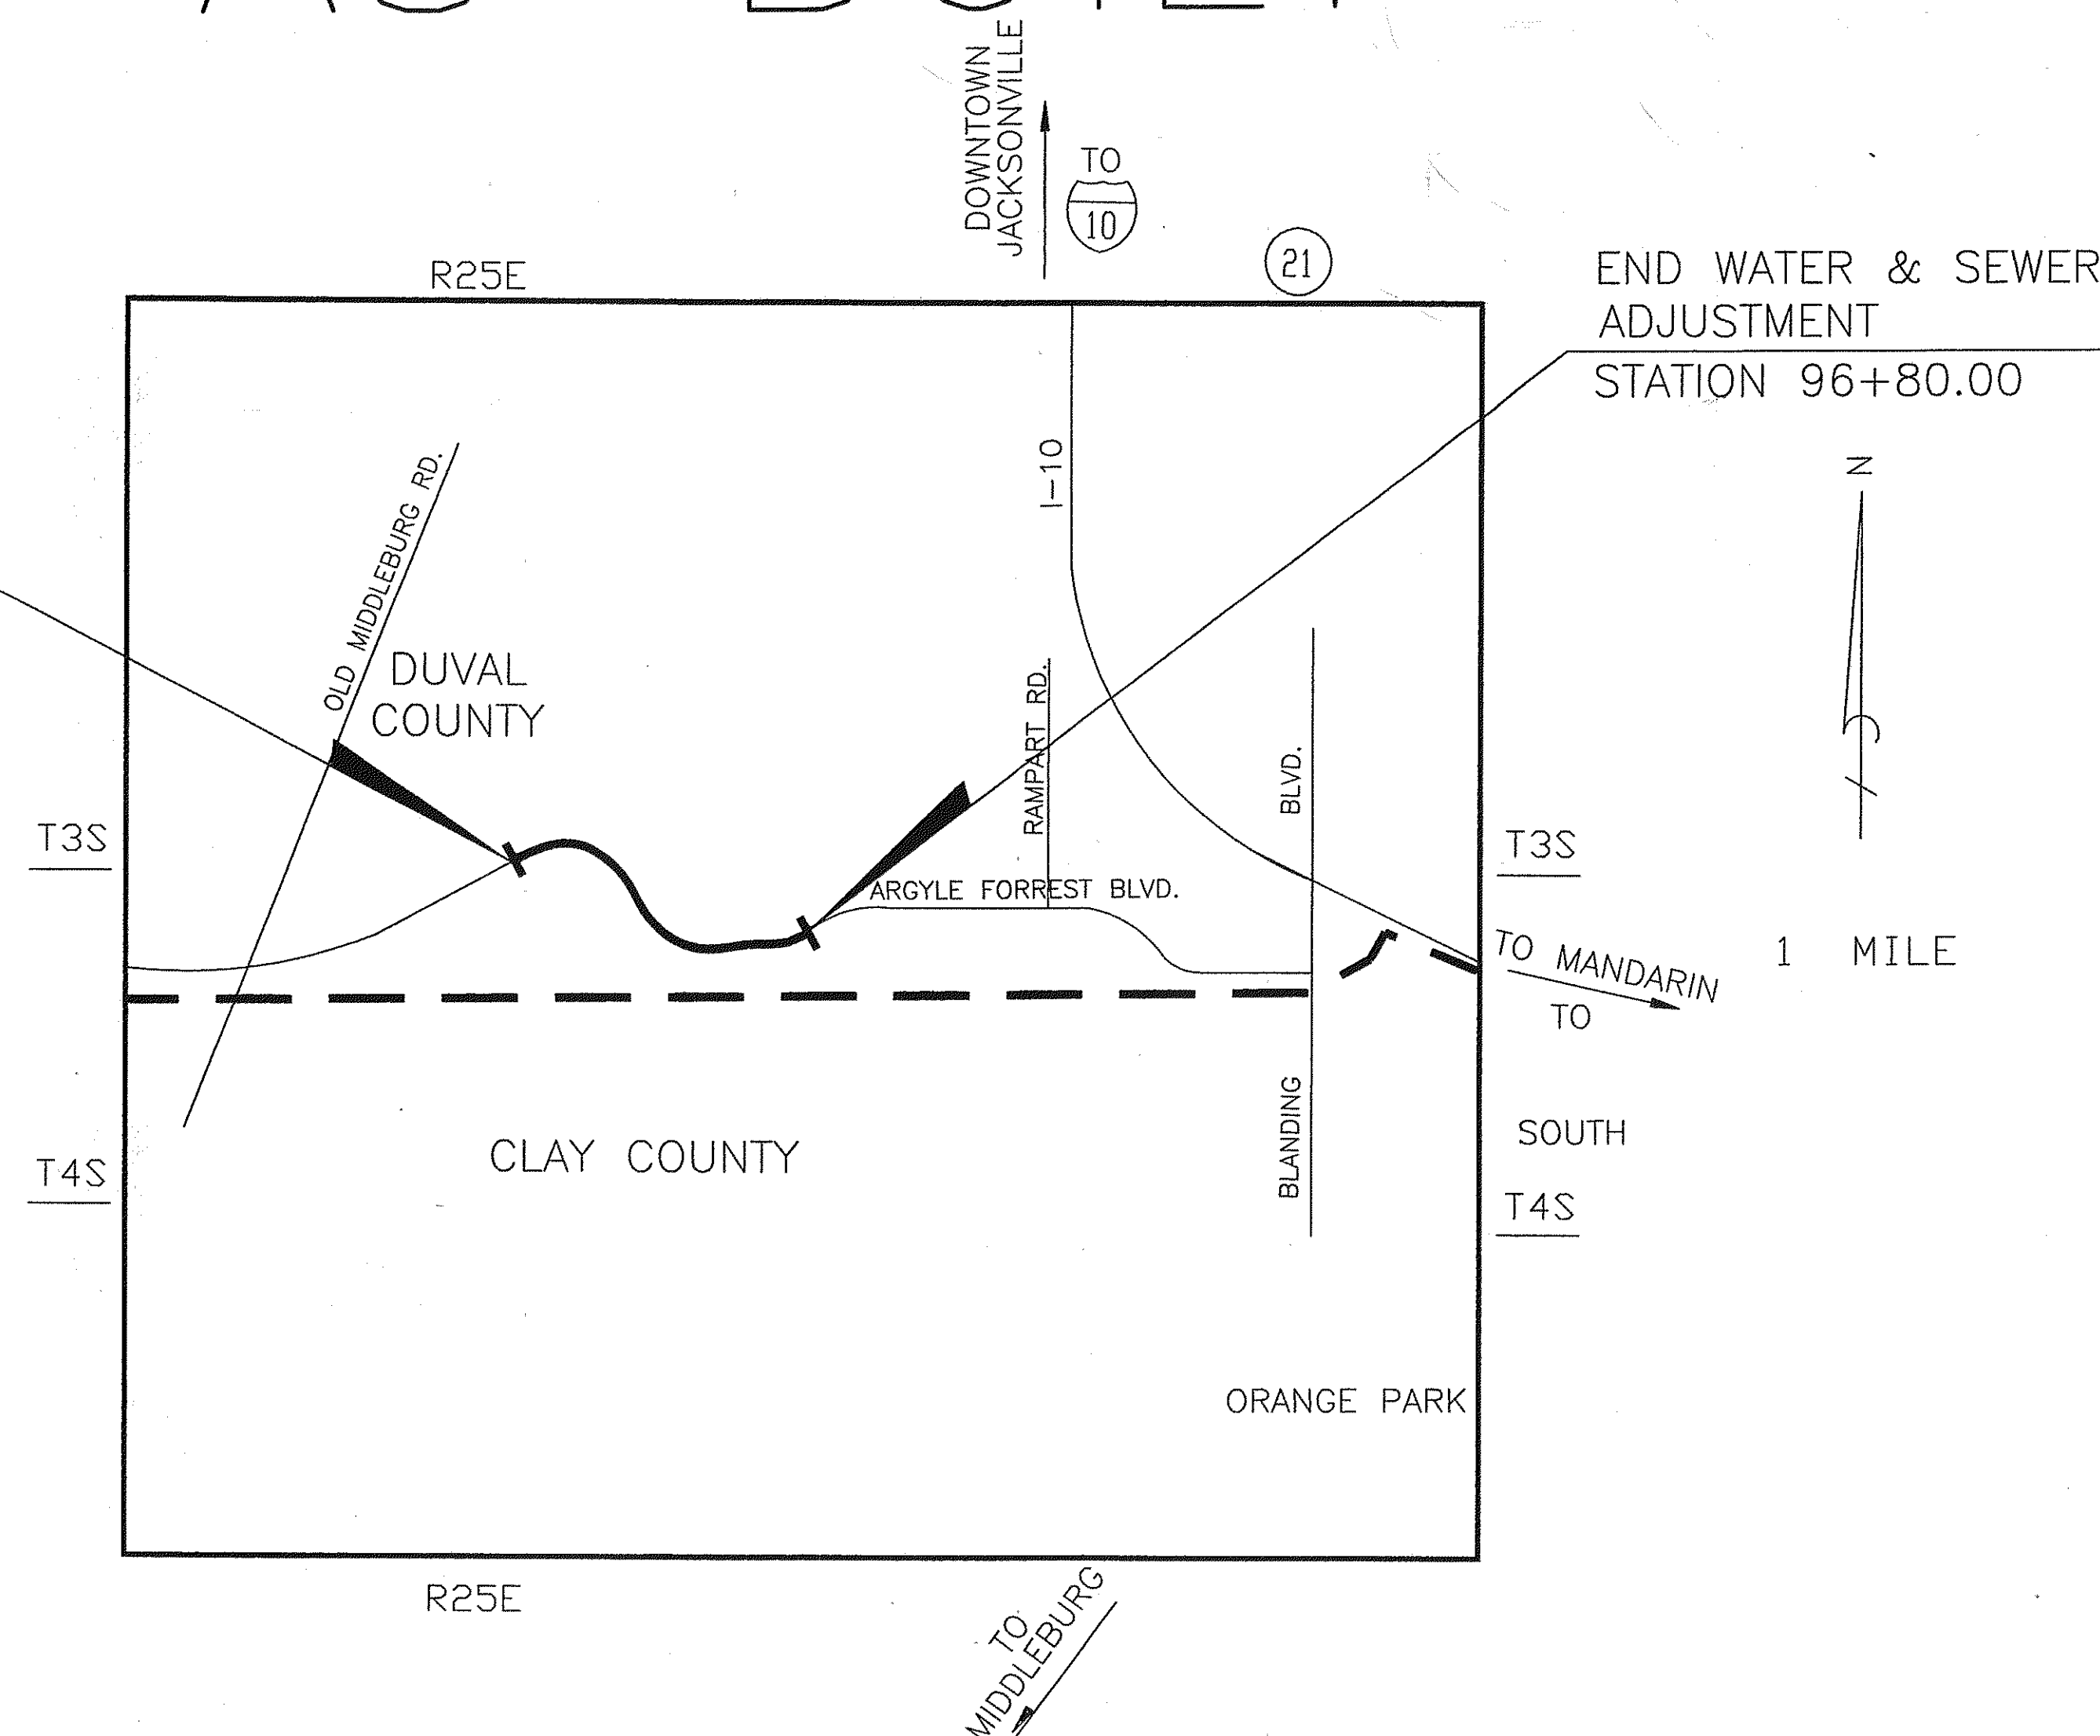


NOTE: THE SCALE OF THESE PLANS ARE PLOTTED
BASED ON HALF SIZE SCALE.

JEA
BUILDING COMMUNITY

BEGIN PROJECT
STA. 298+08.87 * SURVEY
PC STA. 298+08.87 * CONST.
RT. ROADWAY 20' RT.

AS-BUILT
FIRE HYDRANT
THIS AS-BUILT DRAWING REPRESENTS THE
ACTUAL RECORDED FIELD INFORMATION SHOWN
ON FIRE HYDRANT IMPROVEMENTS.
BY: *[Signature]* DATE: 8-15-07
WITH: J.B. CORWELL CONT. INC.


16"X6" TAP, SLEEVE-STA. 11+85.87
(87.68'-LT.) EL. 66.67
8" G.V.-STA. 11+85.76(86.17'-LT.)
TOP NUT EL. 67.40
FIRE HYD.-STA. 11+85.82(86.92'-LT.)

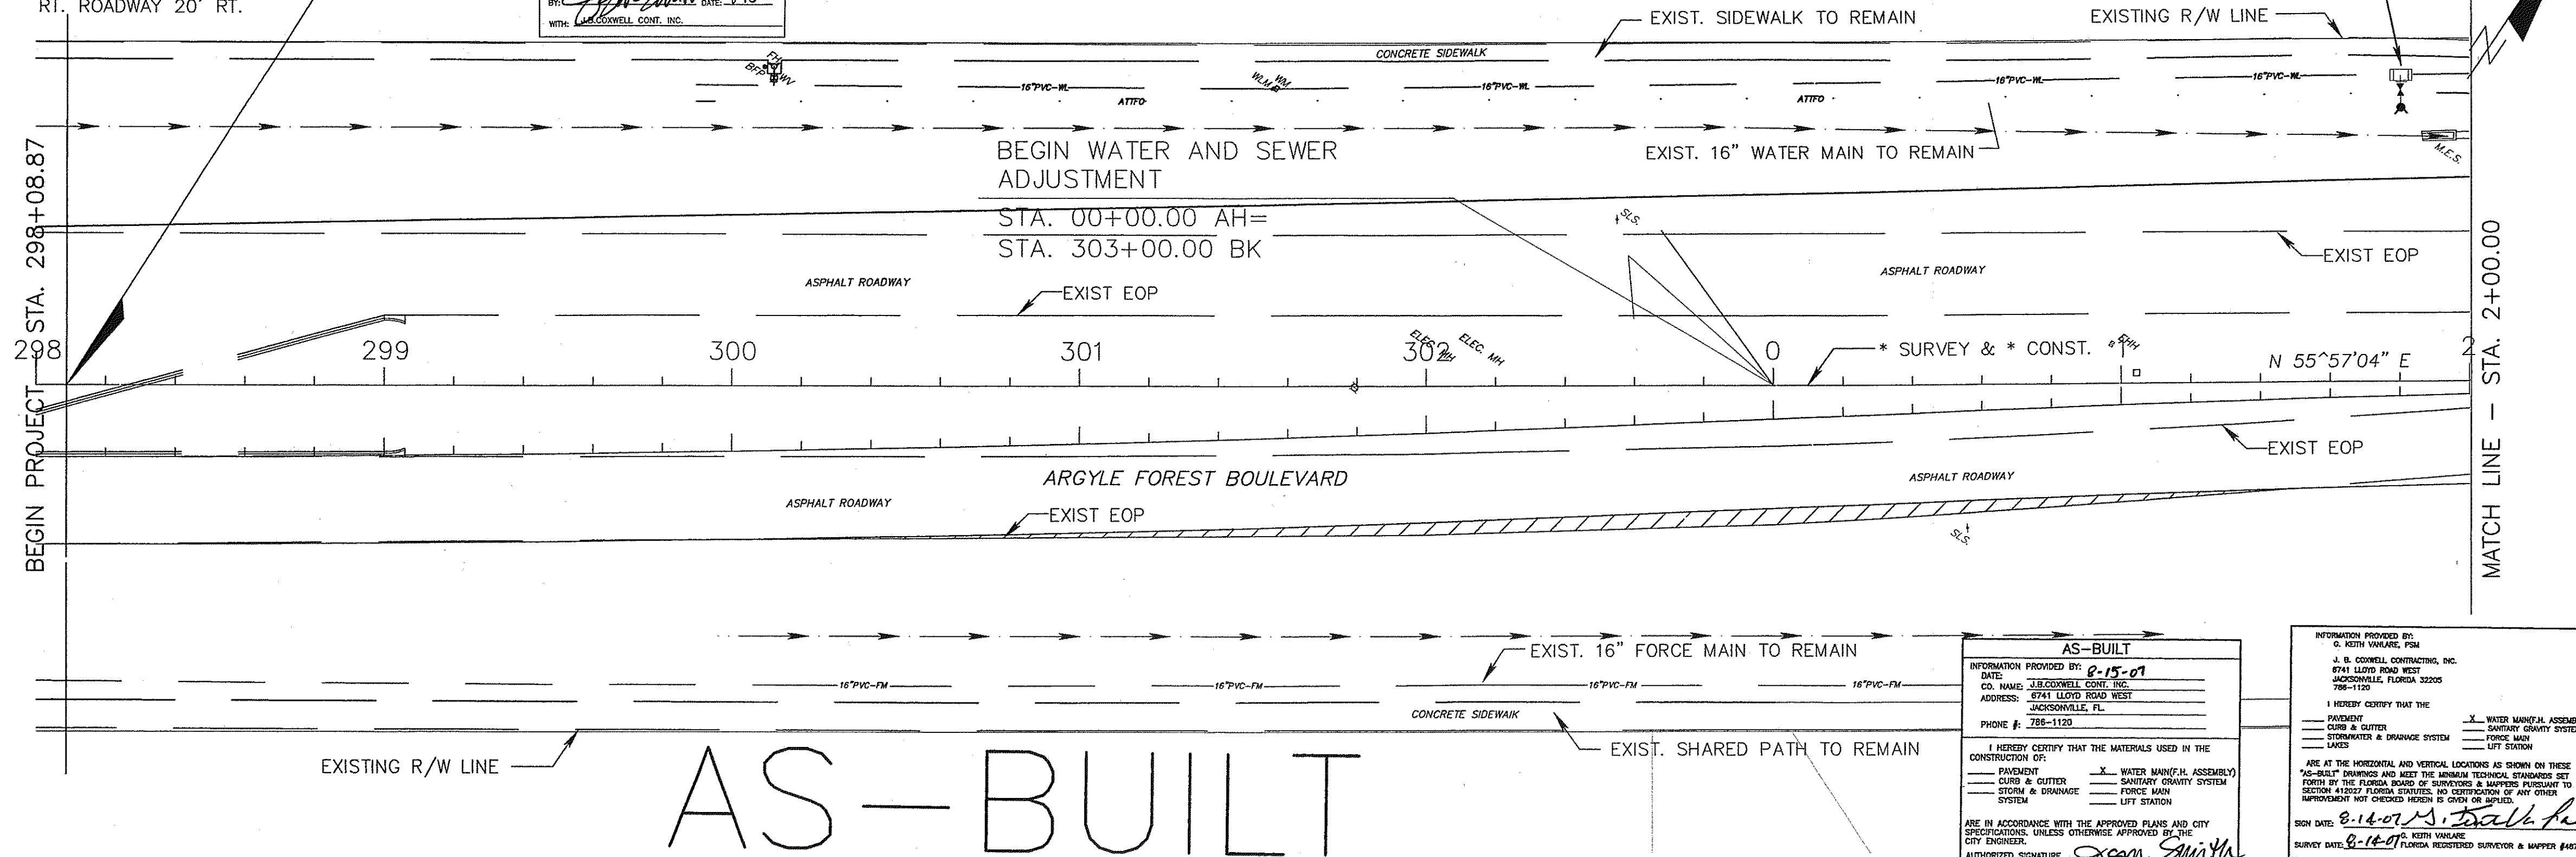

AS-BUILT
INFORMATION PROVIDED BY:
DATE: 8-15-07
CO. NAME: J.B. CORWELL CONT. INC.
ADDRESS: 8741 LLOYD ROAD WEST
JACKSONVILLE, FL 32205
PHONE #: 728-1120
I HEREBY CERTIFY THAT THE MATERIALS USED IN THE
CONSTRUCTION OF:
PAVEMENT: X WATER MAIN (H. ASSEMBLY)
CURB & GUTTER: SANITARY GRAVITY SYSTEM
STORM & DRAINAGE: FORCE MAIN
SYSTEM: LIFT STATION
ARE IN ACCORDANCE WITH THE APPROVED PLANS AND CITY
SPECIFICATIONS, UNLESS OTHERWISE APPROVED BY THE
CITY ENGINEER.
AUTHORIZED SIGNATURE: *[Signature]*

INFORMATION PROVIDED BY:
G. KEITH VAUGHAN, P.E.
J.B. CORWELL CONTRACTING, INC.
8741 LLOYD ROAD WEST
JACKSONVILLE, FLORIDA 32205
728-1120
I HEREBY CERTIFY THAT THE:
PROPERTY: X WATER MAIN (H. ASSEMBLY)
CURB & GUTTER: SANITARY GRAVITY SYSTEM
STORMWATER & DRAINAGE SYSTEM: FORCE MAIN
LAKES: LIFT STATION
ARE AT THE HORIZONTAL AND VERTICAL LOCATIONS AS SHOWN ON THESE
AS-BUILT DRAWINGS AND MEET THE MINIMUM TECHNICAL STANDARDS SET
FORTH BY THE FLORIDA BOARD OF SURVEYORS & MAPPERS PURSUANT TO
SECTION 110.07, F.S. (FLORIDA STATUTES), NO SUPERSEDITION OF ANY OTHER
SUPERSEDITIONARY AND NO CONFLICTS.
SIGN DATE: 8-14-07
SURVEY DATE: 8-14-07
G. KEITH VAUGHAN
FLORIDA REGISTERED SURVEYOR & MAPPER #4872

NOTE:
FOR ROADWAY DESIGN PLANS SEE
JACKSONVILLE TRANSPORTATION AUTHORITY
BETTER JACKSONVILLE PLAN PROJECT No. 91 ARG 2
FOR JEA ELECTRIC DISTRIBUTION PLANS SEE
CONSTRUCTION DRAWINGS FOR ARGYLE FOREST BLVD.
PHASE 2 EAST OF CHIMNEY CAK DR to WEST OF
BRIDGECREEK DR

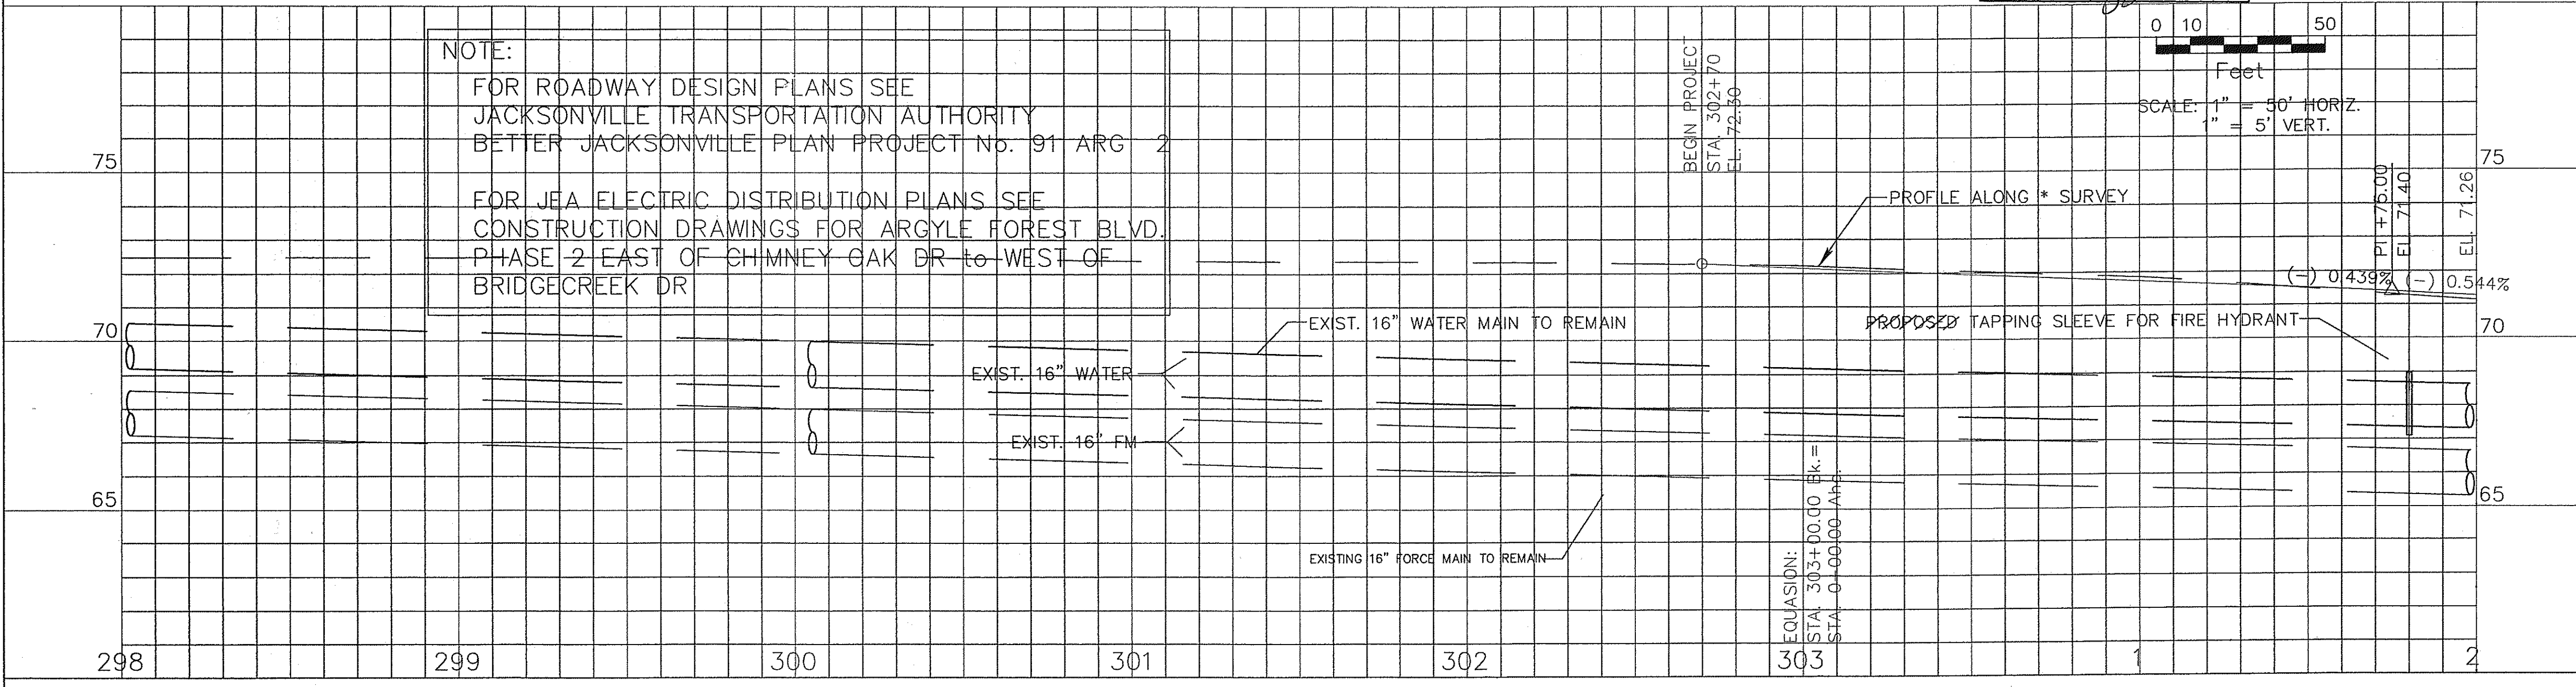

No.	BY	DATE	REVISIONS	SURVEY DATA:	BOOK No.	BY	DATE	PCS.	DESIGNER	H.F.B.
1										
2										
3										
4										
5										
6										
7										
8										
9										
10										

SURVEYED	CHAINS CHECKED	B.M.'S NOTED

ALIGNMENT CHECKED	RT. OF WAY CHECKED	STRUCTURE NOTATION CHECKED


DRAWN BY	DATE	CHECKED BY	DATE
C.B.H.	SEPT. 2005	F.E.G.	SEPT. 2005

PROJECT No.	W-04321015
DATE	SEPT. 2005
SCALE:	1" = 30' H., 1" = 5' V.

WATER AND SEWER ADJUSTMENT PLANS

SHEET No.	5
OF	34
DRAWING No.	

Argyle Forest Blvd
Phase 2
55432

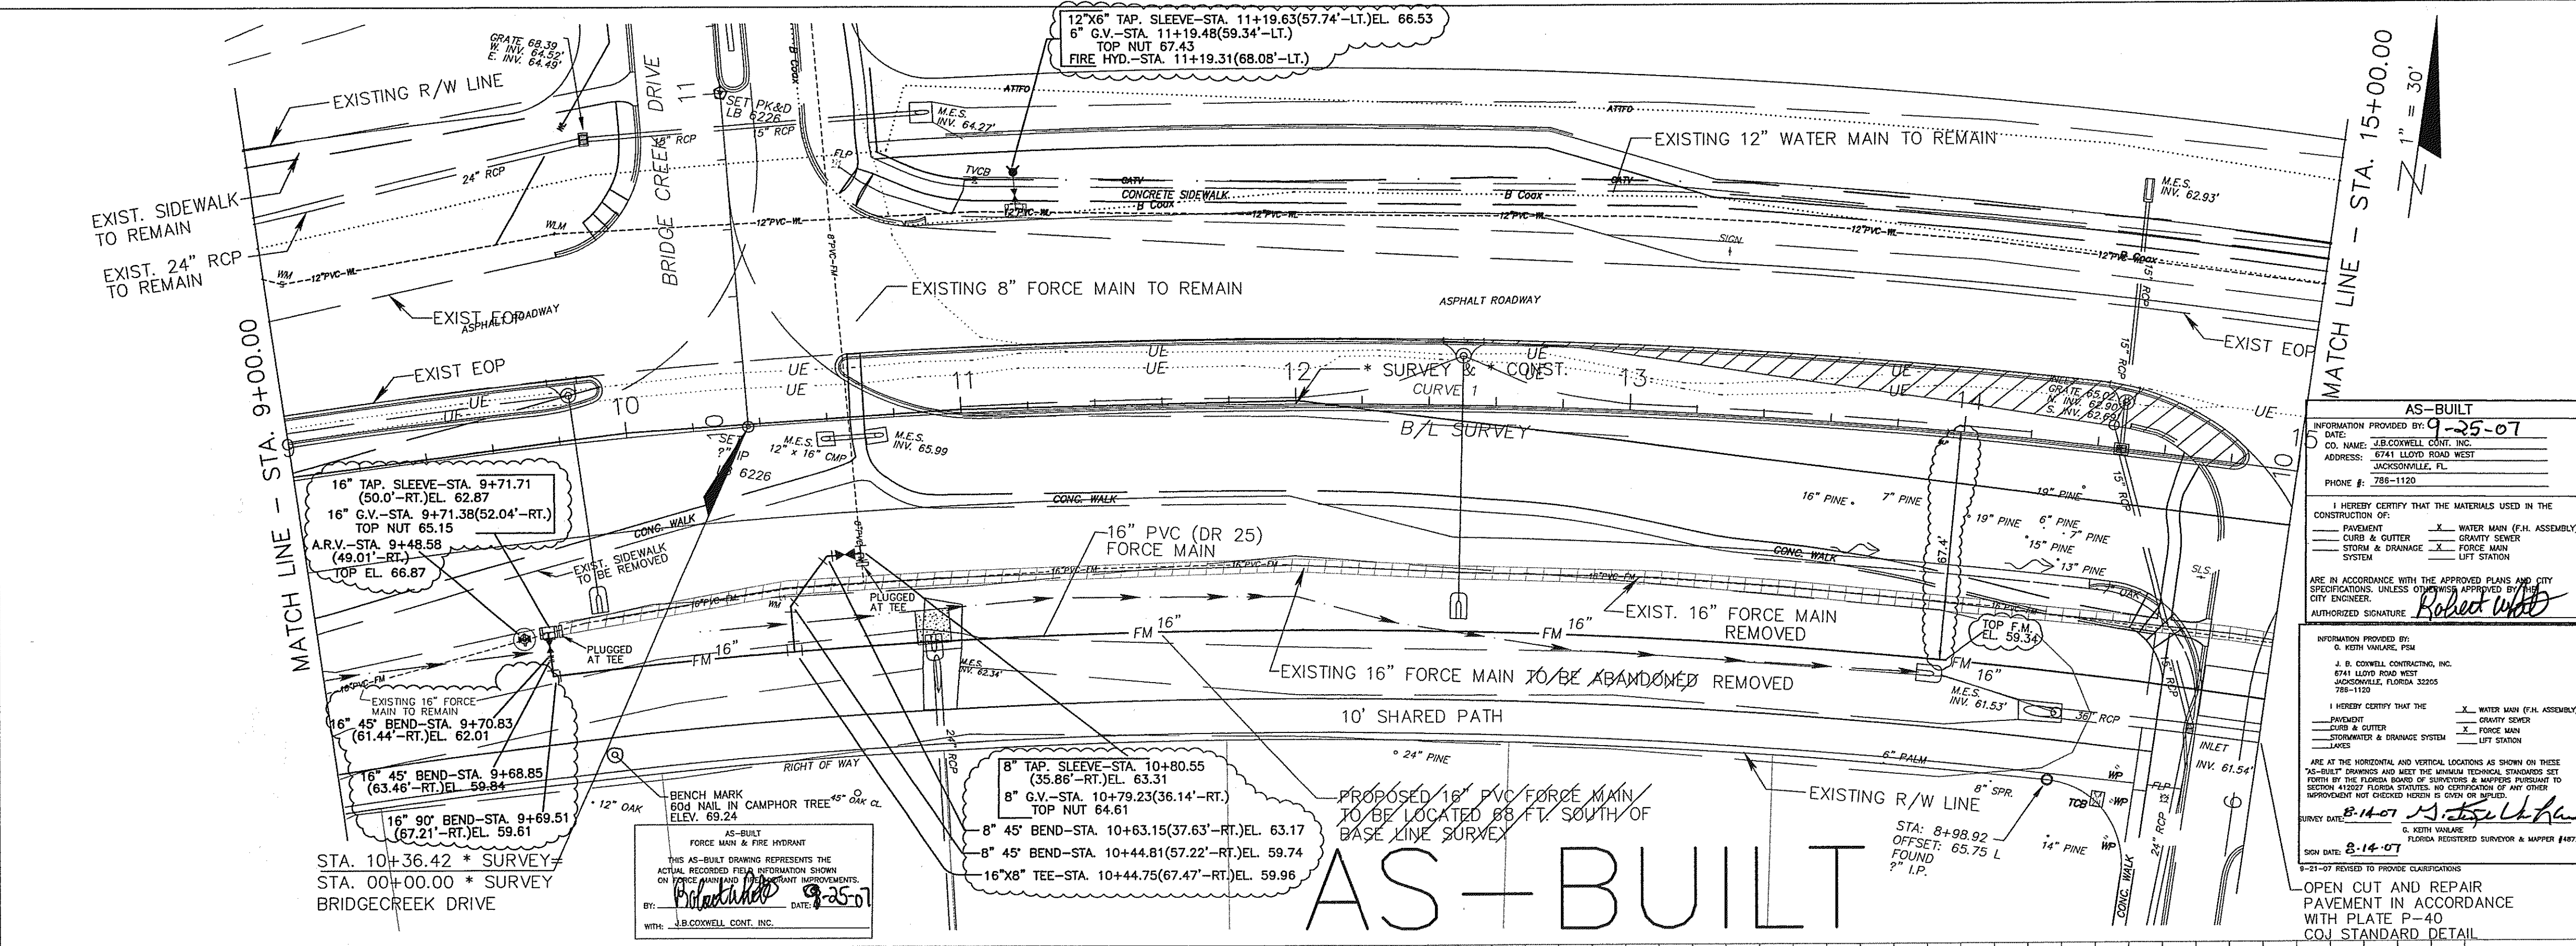

AS-BUILT
INFORMATION PROVIDED BY: 9-25-07
DATE: 9-25-07
C.D. NAME: J.B. CORWELL, INC.
ADDRESS: 6741 LLOYD ROAD WEST
JACKSONVILLE, FL.
PHONE: 785-1120

I HEREBY CERTIFY THAT THE MATERIALS USED IN THE CONSTRUCTION OF:
PAVEMENT _____
CURB & GUTTER _____
STORM & DRAINAGE _____
WATER MAIN (F.H. ASSEMBLY) _____
SEWER _____
FORCE MAIN _____
LIFT STATION _____

ARE IN ACCORDANCE WITH THE APPROVED PLANS AND CITY SPECIFICATIONS, UNLESS OTHERWISE APPROVED BY THE CITY ENGINEER.
AUTHORIZED SIGNATURE: Robert White


INFORMATION PROVIDED BY:
G. KEITH VAHLE, P.E.
J.B. CORWELL CONTRACTING, INC.
6741 LLOYD ROAD WEST
JACKSONVILLE, FLORIDA 32205
785-1120

I HEREBY CERTIFY THAT THE:
PAVEMENT _____
CURB & GUTTER _____
STORMWATER & DRAINAGE SYSTEM _____
WATER MAIN (F.H. ASSEMBLY) _____
SEWER _____
FORCE MAIN _____
LIFT STATION _____

ARE AT THE HORIZONTAL AND VERTICAL LOCATIONS AS SHOWN ON THESE "AS-BUILT" DRAWINGS AND MEET THE MINIMUM TECHNICAL STANDARDS SET FORTH BY THE FLORIDA BOARD OF SURVEYORS & MAPPERS PURSUANT TO SECTION 412007 FLORIDA STATUTES. NO CERTIFICATION OF ANY OTHER INFORMATION NOT SHOWN HEREIN IS GIVEN ON THESE PLANS.

SURVEY DATE: 8-14-07
G. KEITH VAHLE
FLORIDA REGISTERED SURVEYOR & MAPPER #4472

8-21-07 REVISED TO PROVIDE CLARIFICATIONS
OPEN CUT AND REPAIR
PAVEMENT IN ACCORDANCE
WITH PLATE P-40
CITY STANDARD DETAIL

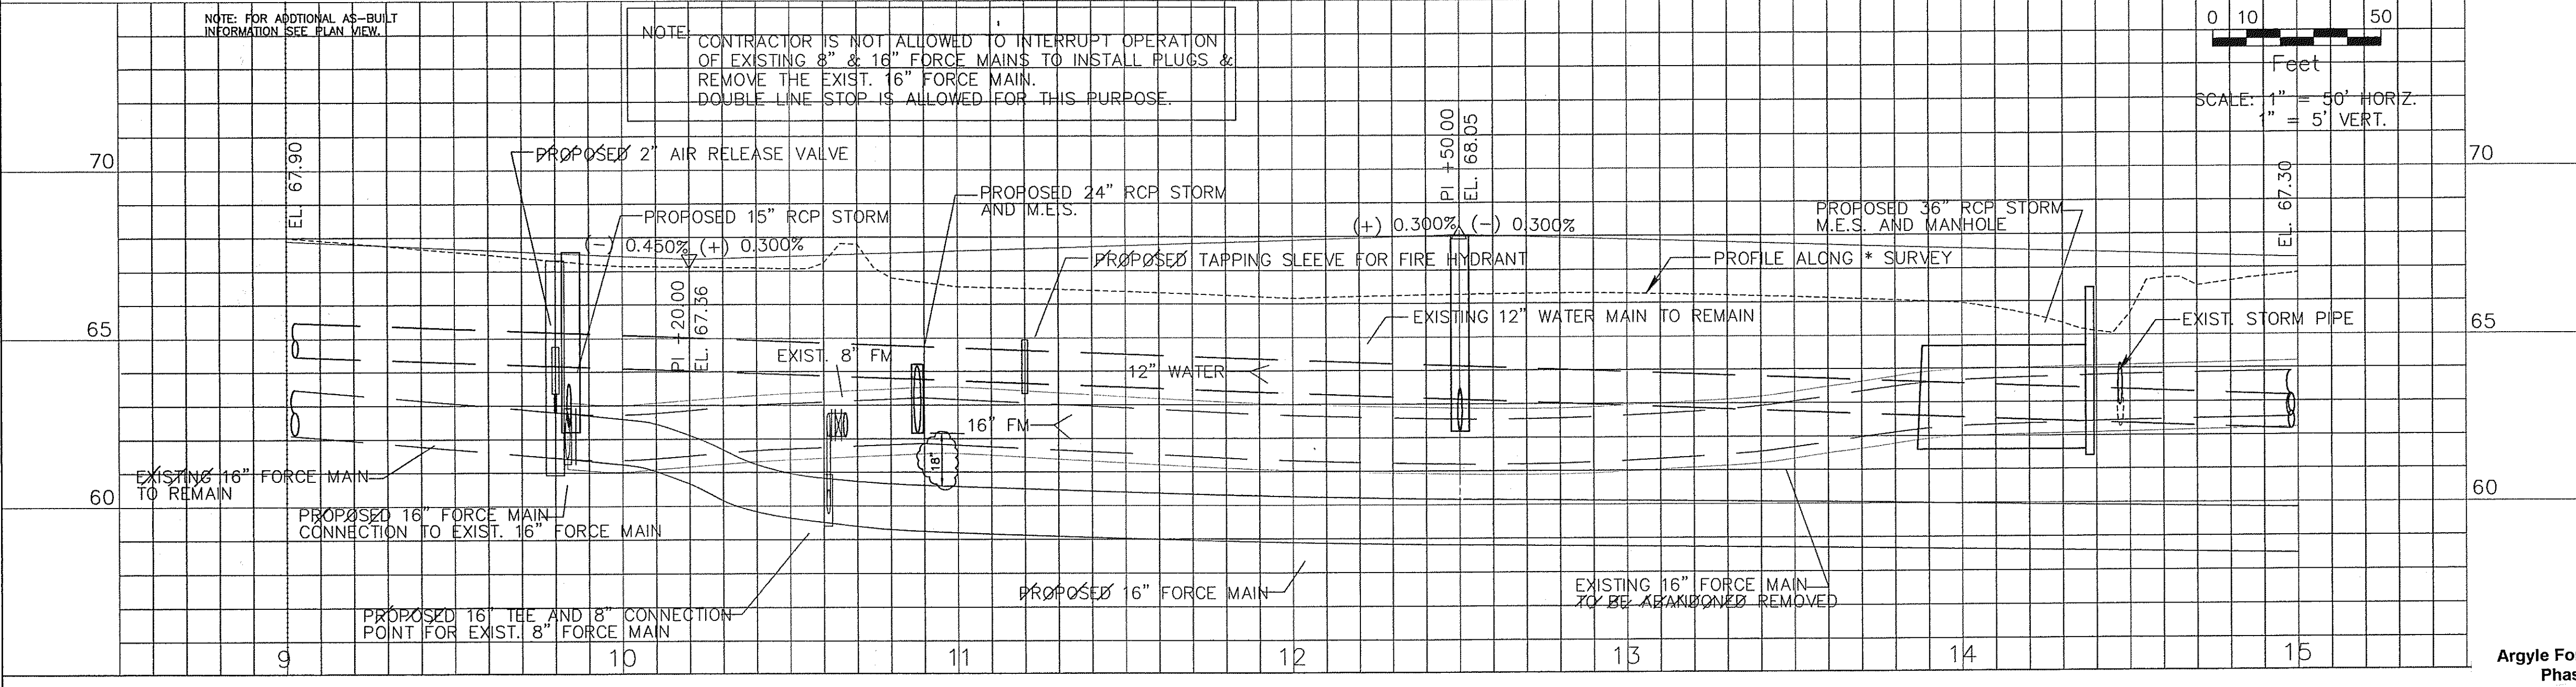

No.	BY	DATE	REVISIONS	SURVEY DATA	BOOK No.	PCS.	DESIGNER	H.F.B.
1								
2								
3								
4								
5								
6								

No.	BY	DATE	REVISIONS	SURVEY DATA	BOOK No.	PCS.	DESIGNER	H.F.B.
1								
2								
3								
4								
5								
6								

No.	BY	DATE	REVISIONS	SURVEY DATA	BOOK No.	PCS.	DESIGNER	H.F.B.
1								
2								
3								
4								
5								
6								

No.	BY	DATE	REVISIONS	SURVEY DATA	BOOK No.	PCS.	DESIGNER	H.F.B.
1								
2								
3								
4								
5								
6								

No.	BY	DATE	REVISIONS	SURVEY DATA	BOOK No.	PCS.	DESIGNER	H.F.B.
1								
2								
3								
4								
5								
6								

No.	BY	DATE	REVISIONS	SURVEY DATA	BOOK No.	PCS.	
-----	----	------	-----------	-------------	----------	------	--

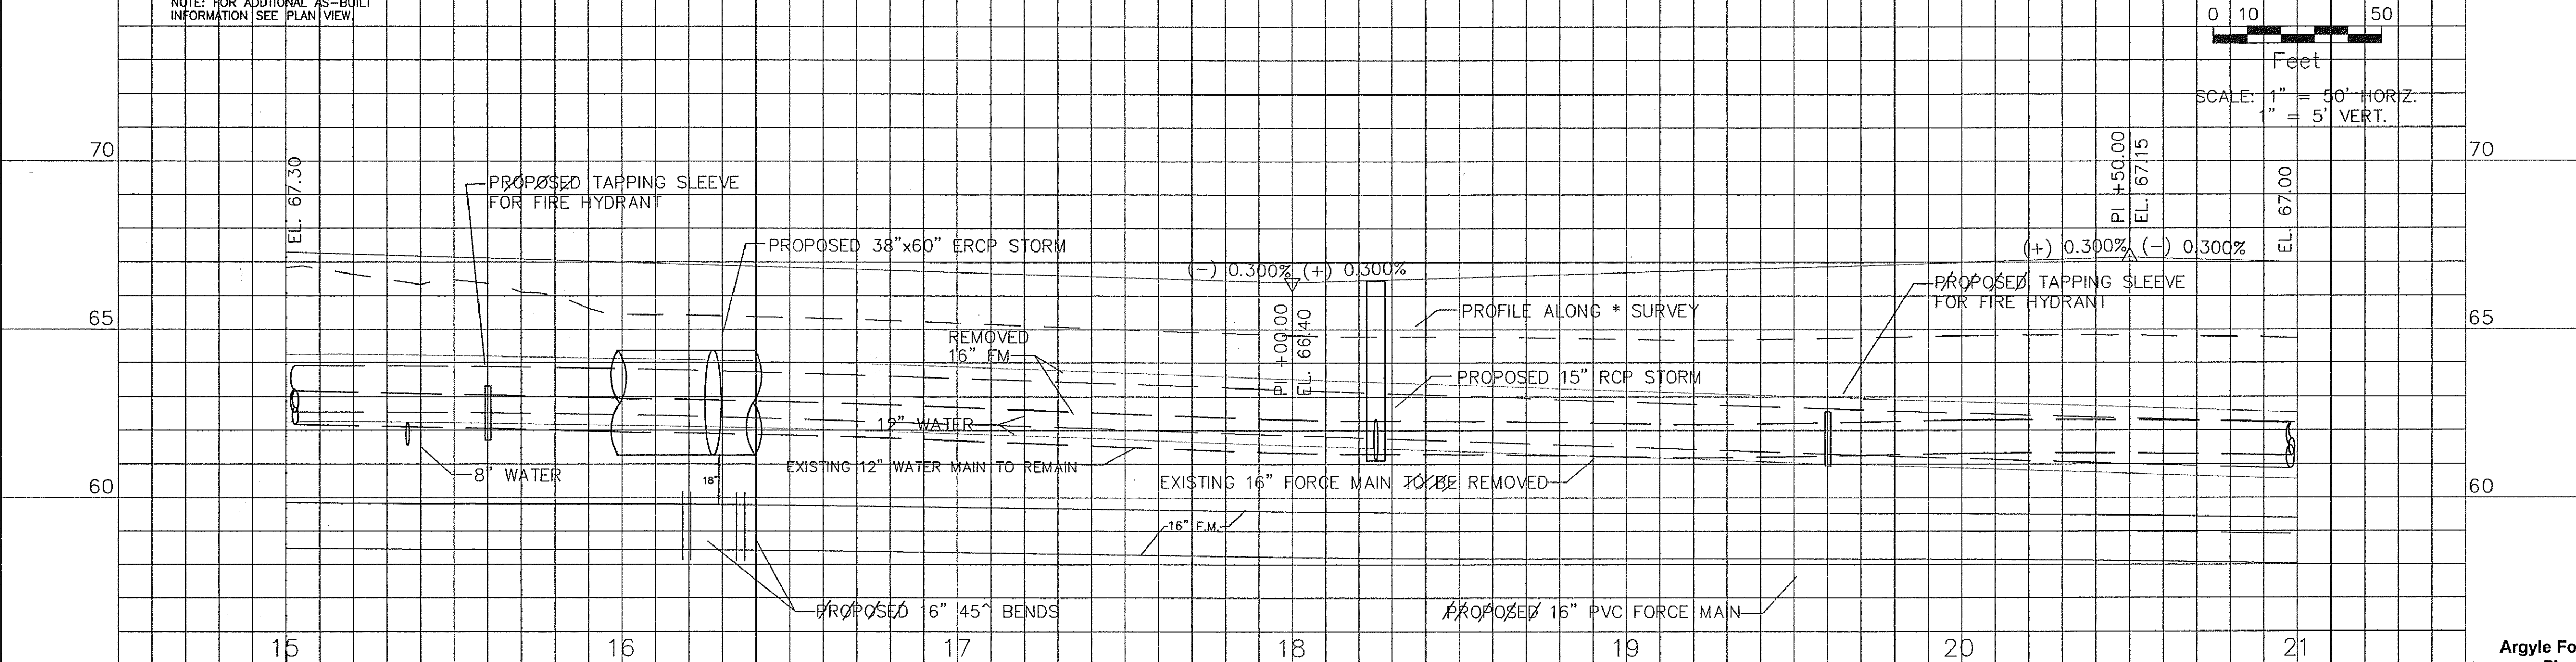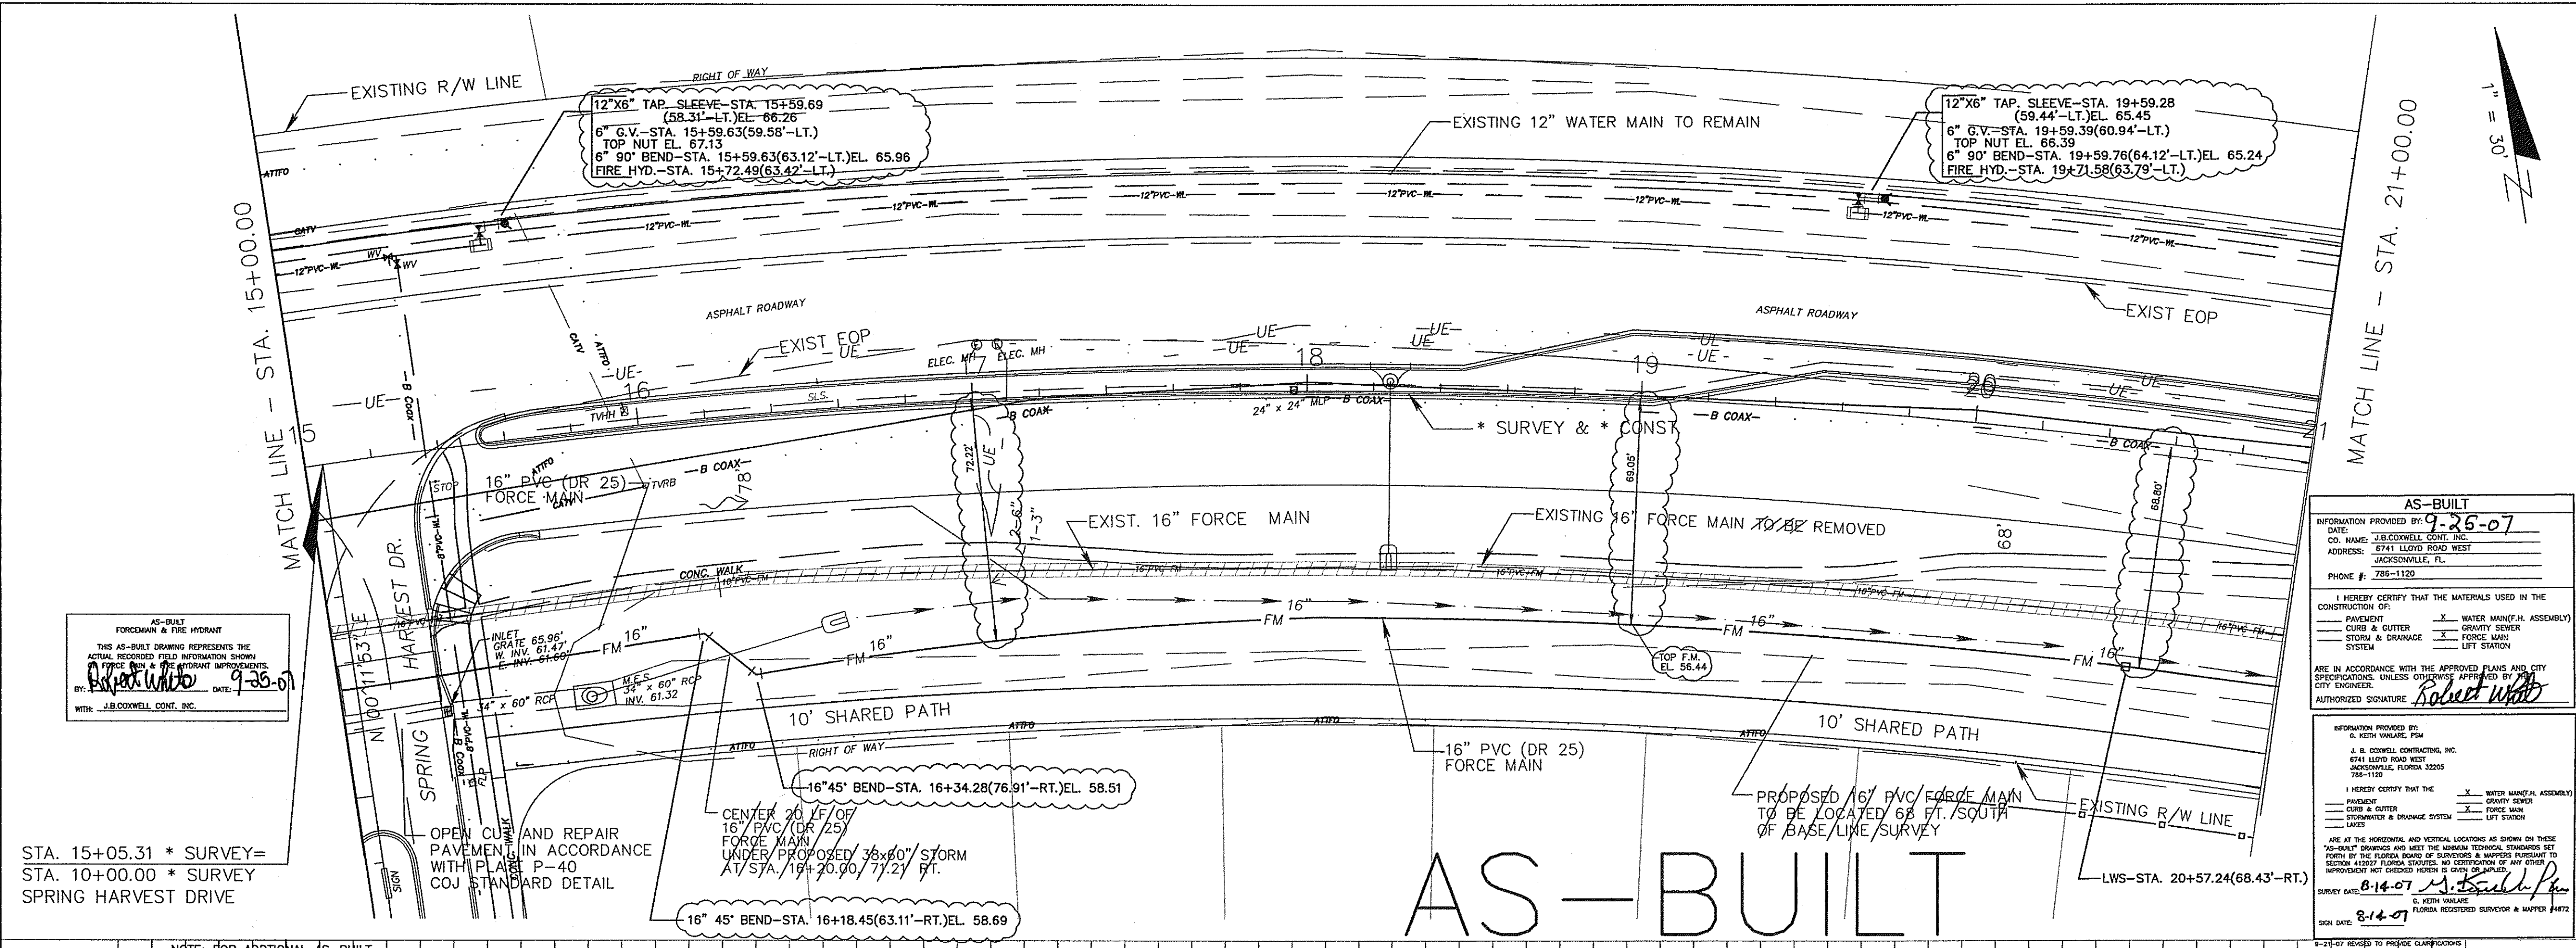



No.	BY	DATE	REVISIONS	SURVEY DATA	BOOK No.	BY	DATE	PCS.	BY	DATE
1										
2										
3										
4										
5										
6										

DESIGNER: H.F.B.
DRAWN BY: C.B.H.
DATE: SEPT. 2005
CHECKED BY: F.E.G.
DATE: SEPT. 2005

PROJECT No. W-04321015
DATE: SEPT. 2005
SCALE: 1" = 30' H., 1" = 5' V.

WATER AND SEWER
ADJUSTMENT PLANS



SHEET No. 8
OF 34
DRAWING No.

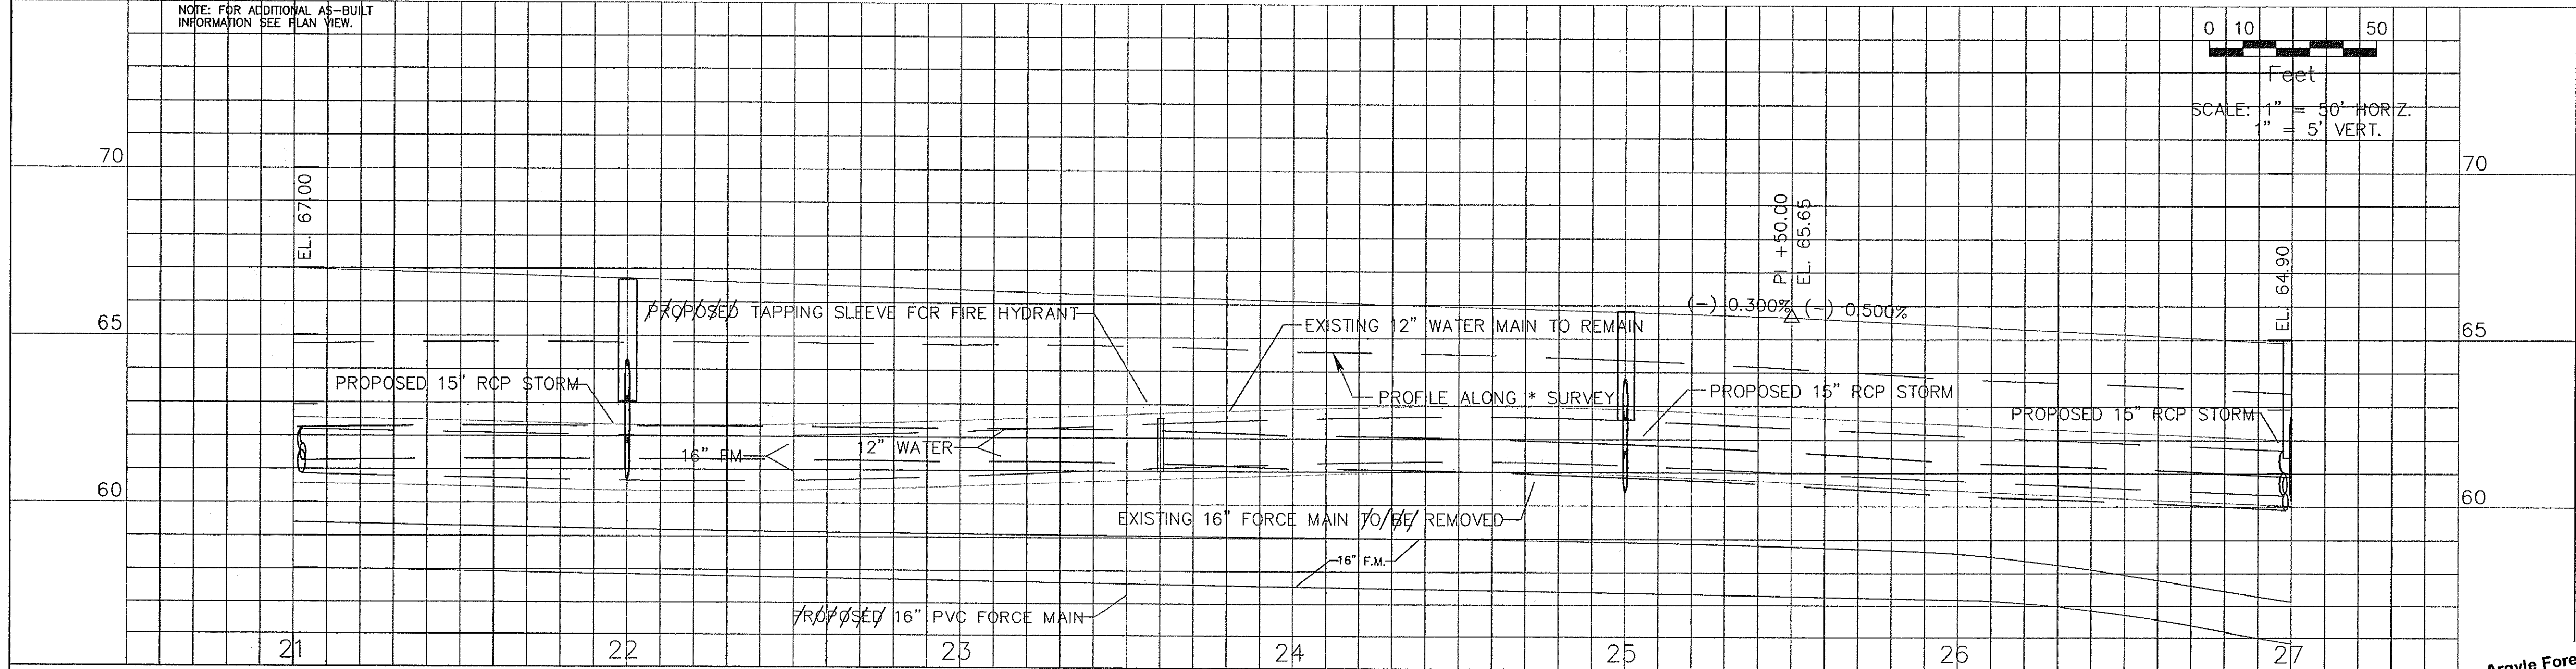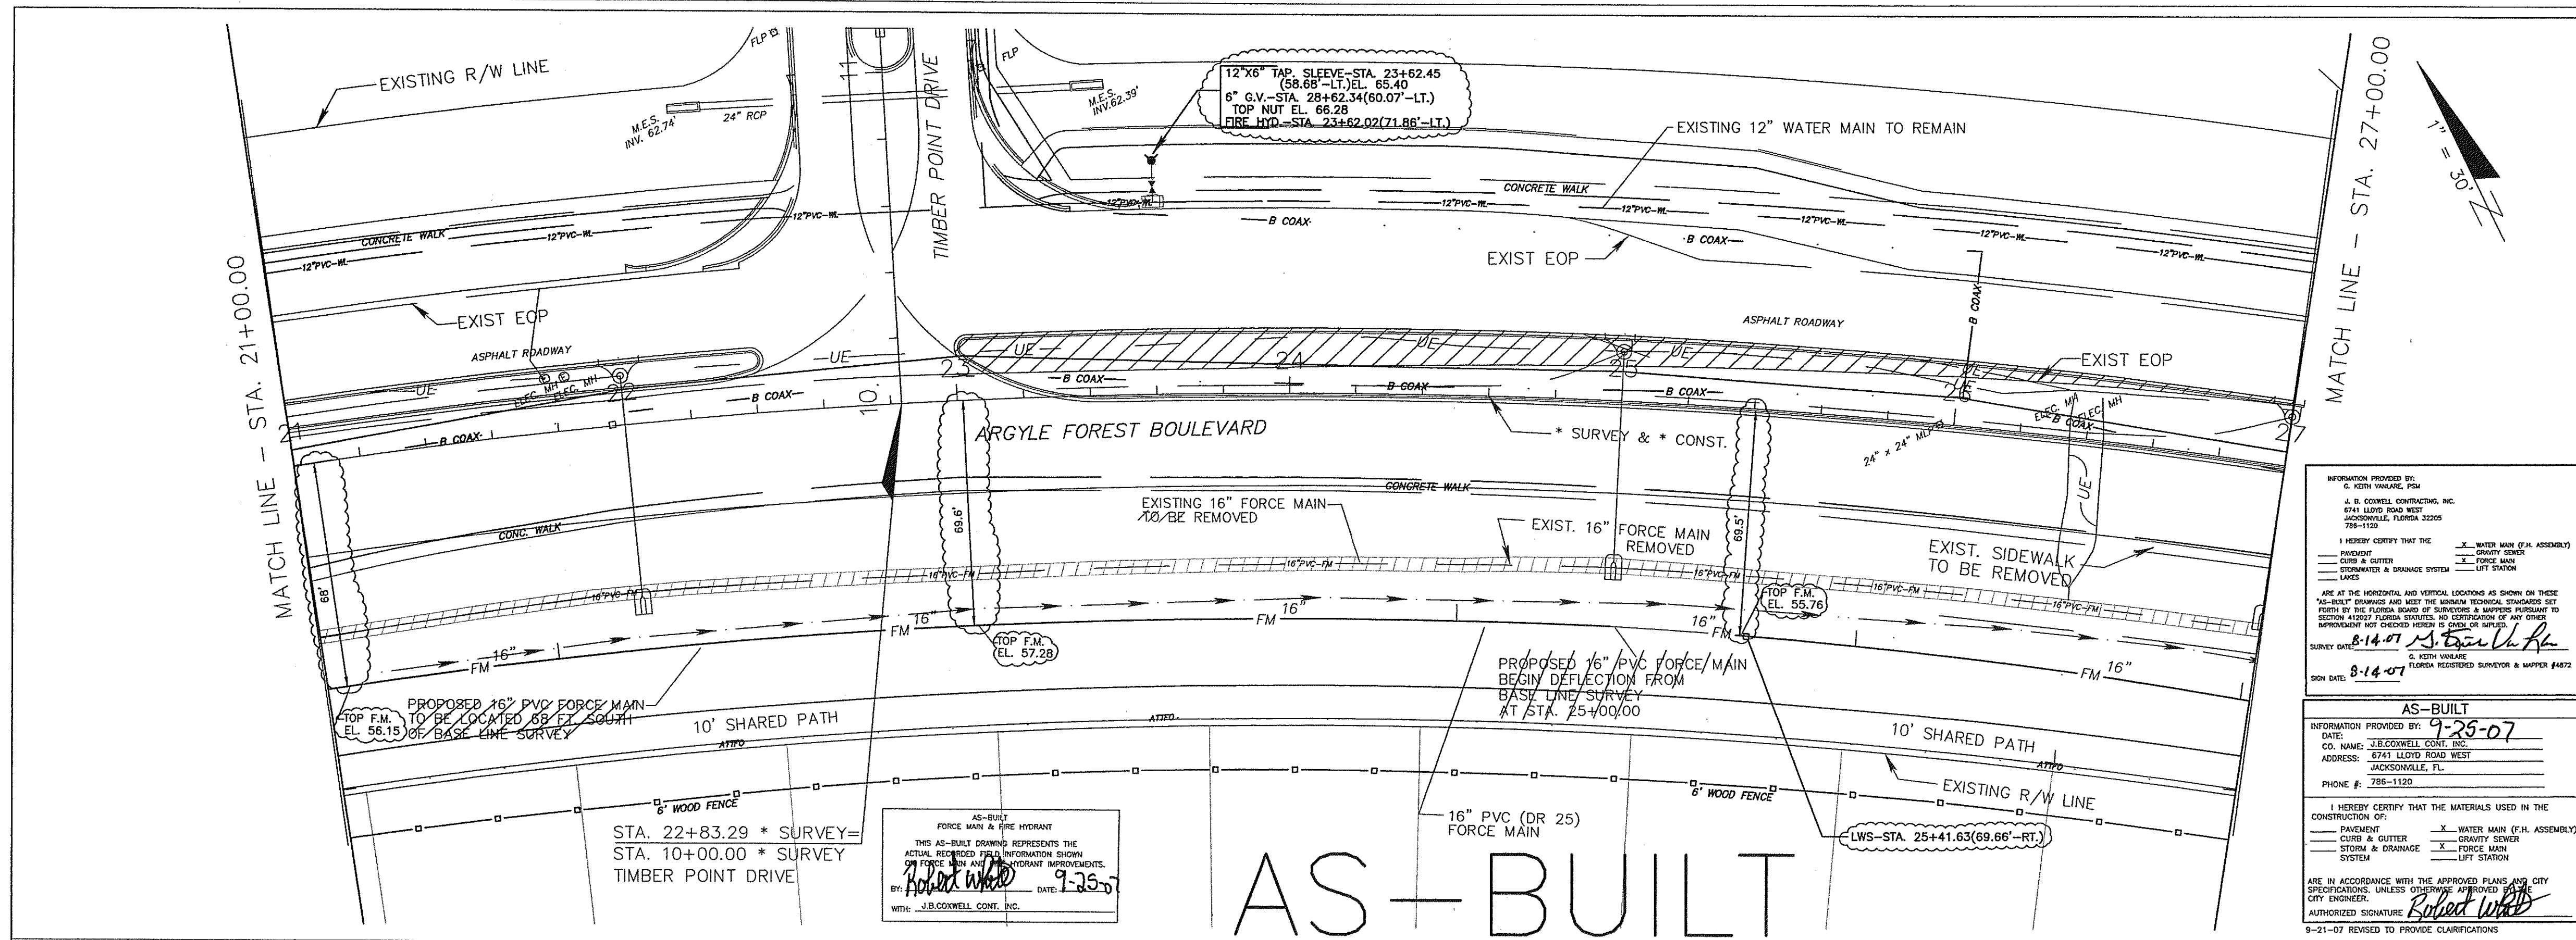

REVISIONS				SURVEY DATA				DESIGNER				PROJECT No.				WATER AND SEWER ADJUSTMENT PLANS			
No.	BY	DATE		BOOK No.	BY	DATE		DATE	BY	DATE		W-04321015	DATE	SEPT. 2005	SCALE: 1" = 30' H., 1" = 5' V.				
1																			
2																			
3																			
4																			

Argyle Forest Blvd
Phase 2
55436

SHEET No.
9
OF
34
DRAWING No.

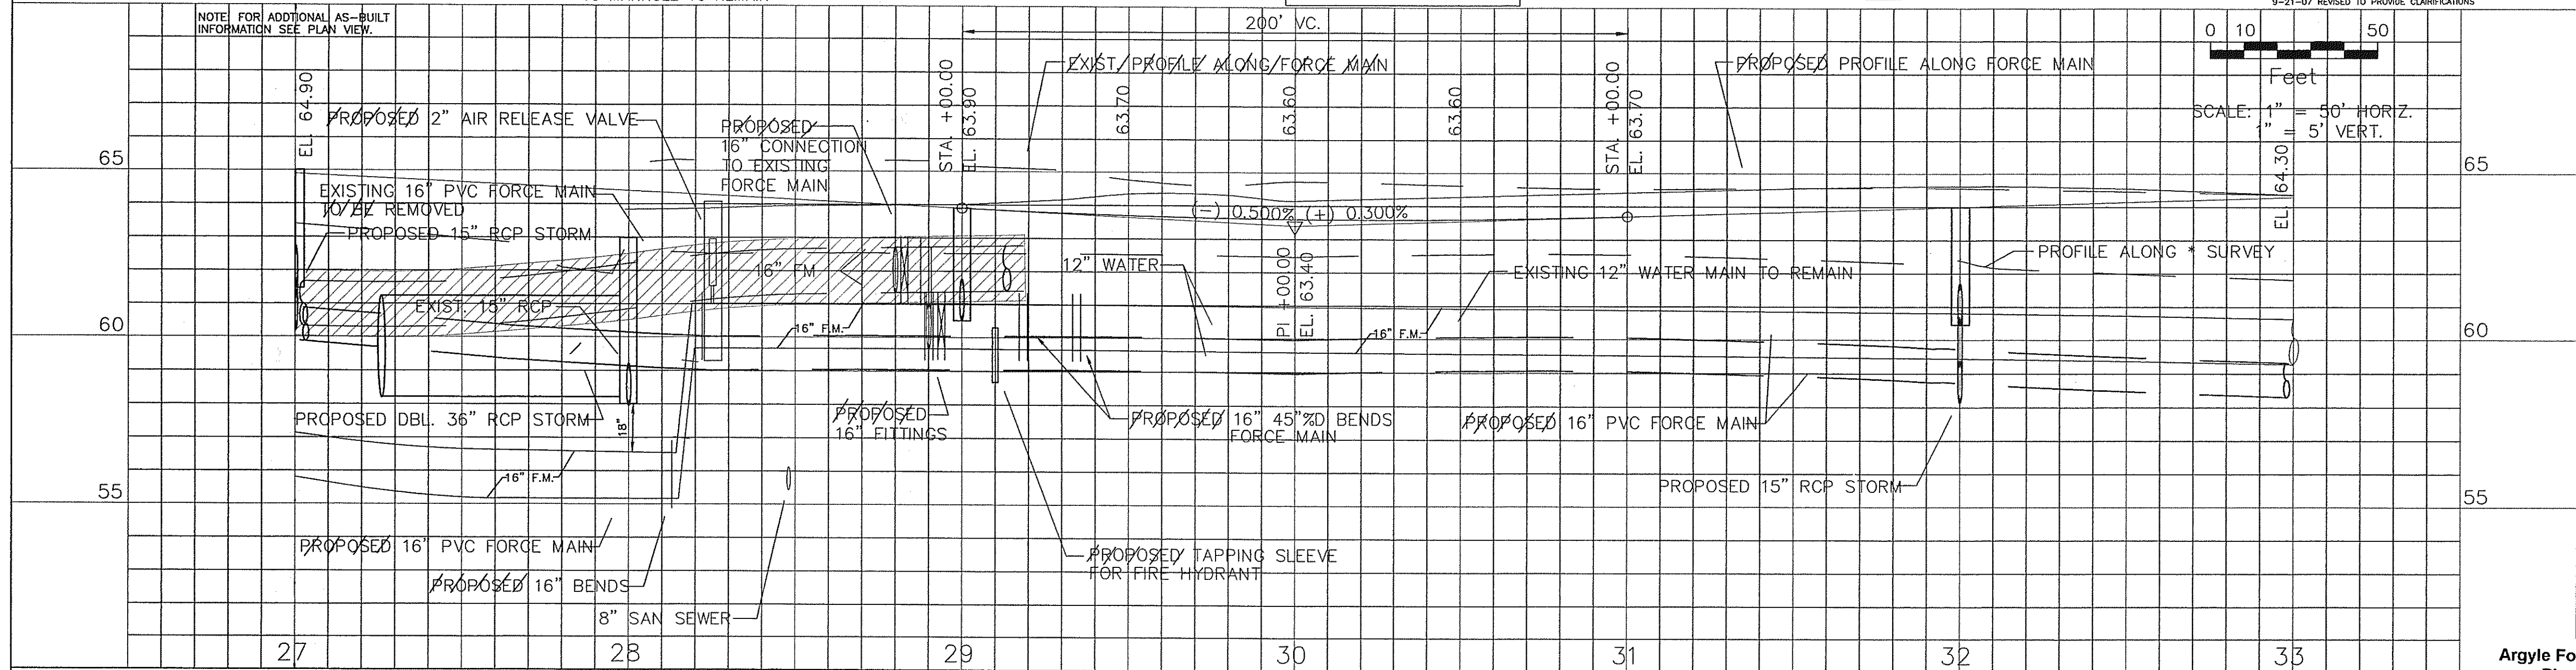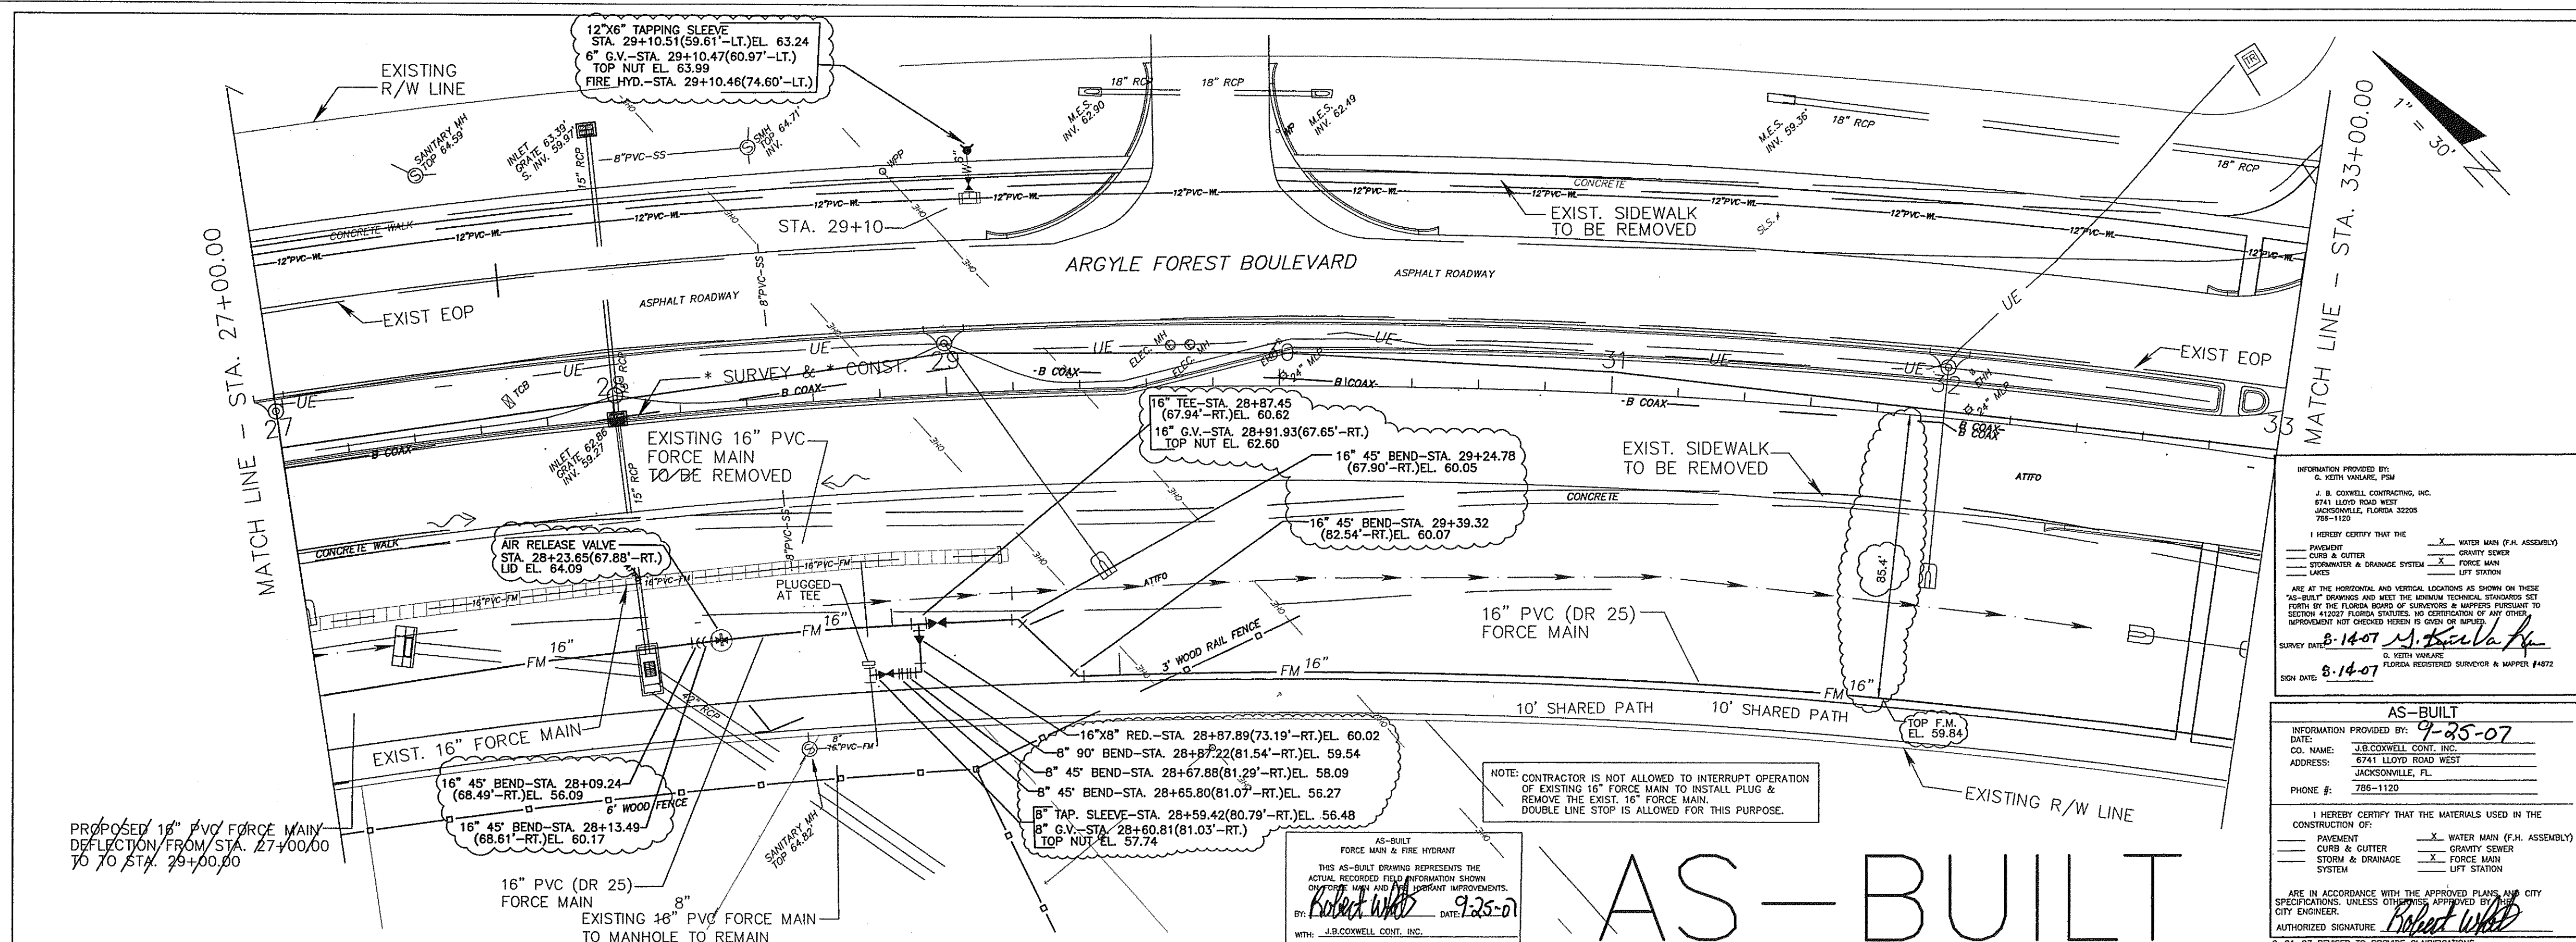

No.	BY	DATE	REVISIONS	SURVEY DATA:	BOOK No.	BY	DATE	FGS	DESIGNER	H.F.B.
1				SURVEYED					DRAWN BY	C.B.H.
2				GRADES CHECKED					DATE	SEPT. 2005
3				RAIS NOTED					CHECKED BY	F.E.G.
4									DATE	SEPT. 2005




PROJECT No. W-04321015
 DATE SEPT. 2005
 SCALE: 1" = 30' H., 1" = 5' V.

WATER AND SEWER
 ADJUSTMENT PLANS


SHEET No.
 10
 OF 34
 DRAWING No.

Argyle Forest Blvd
 Phase 2
 55437

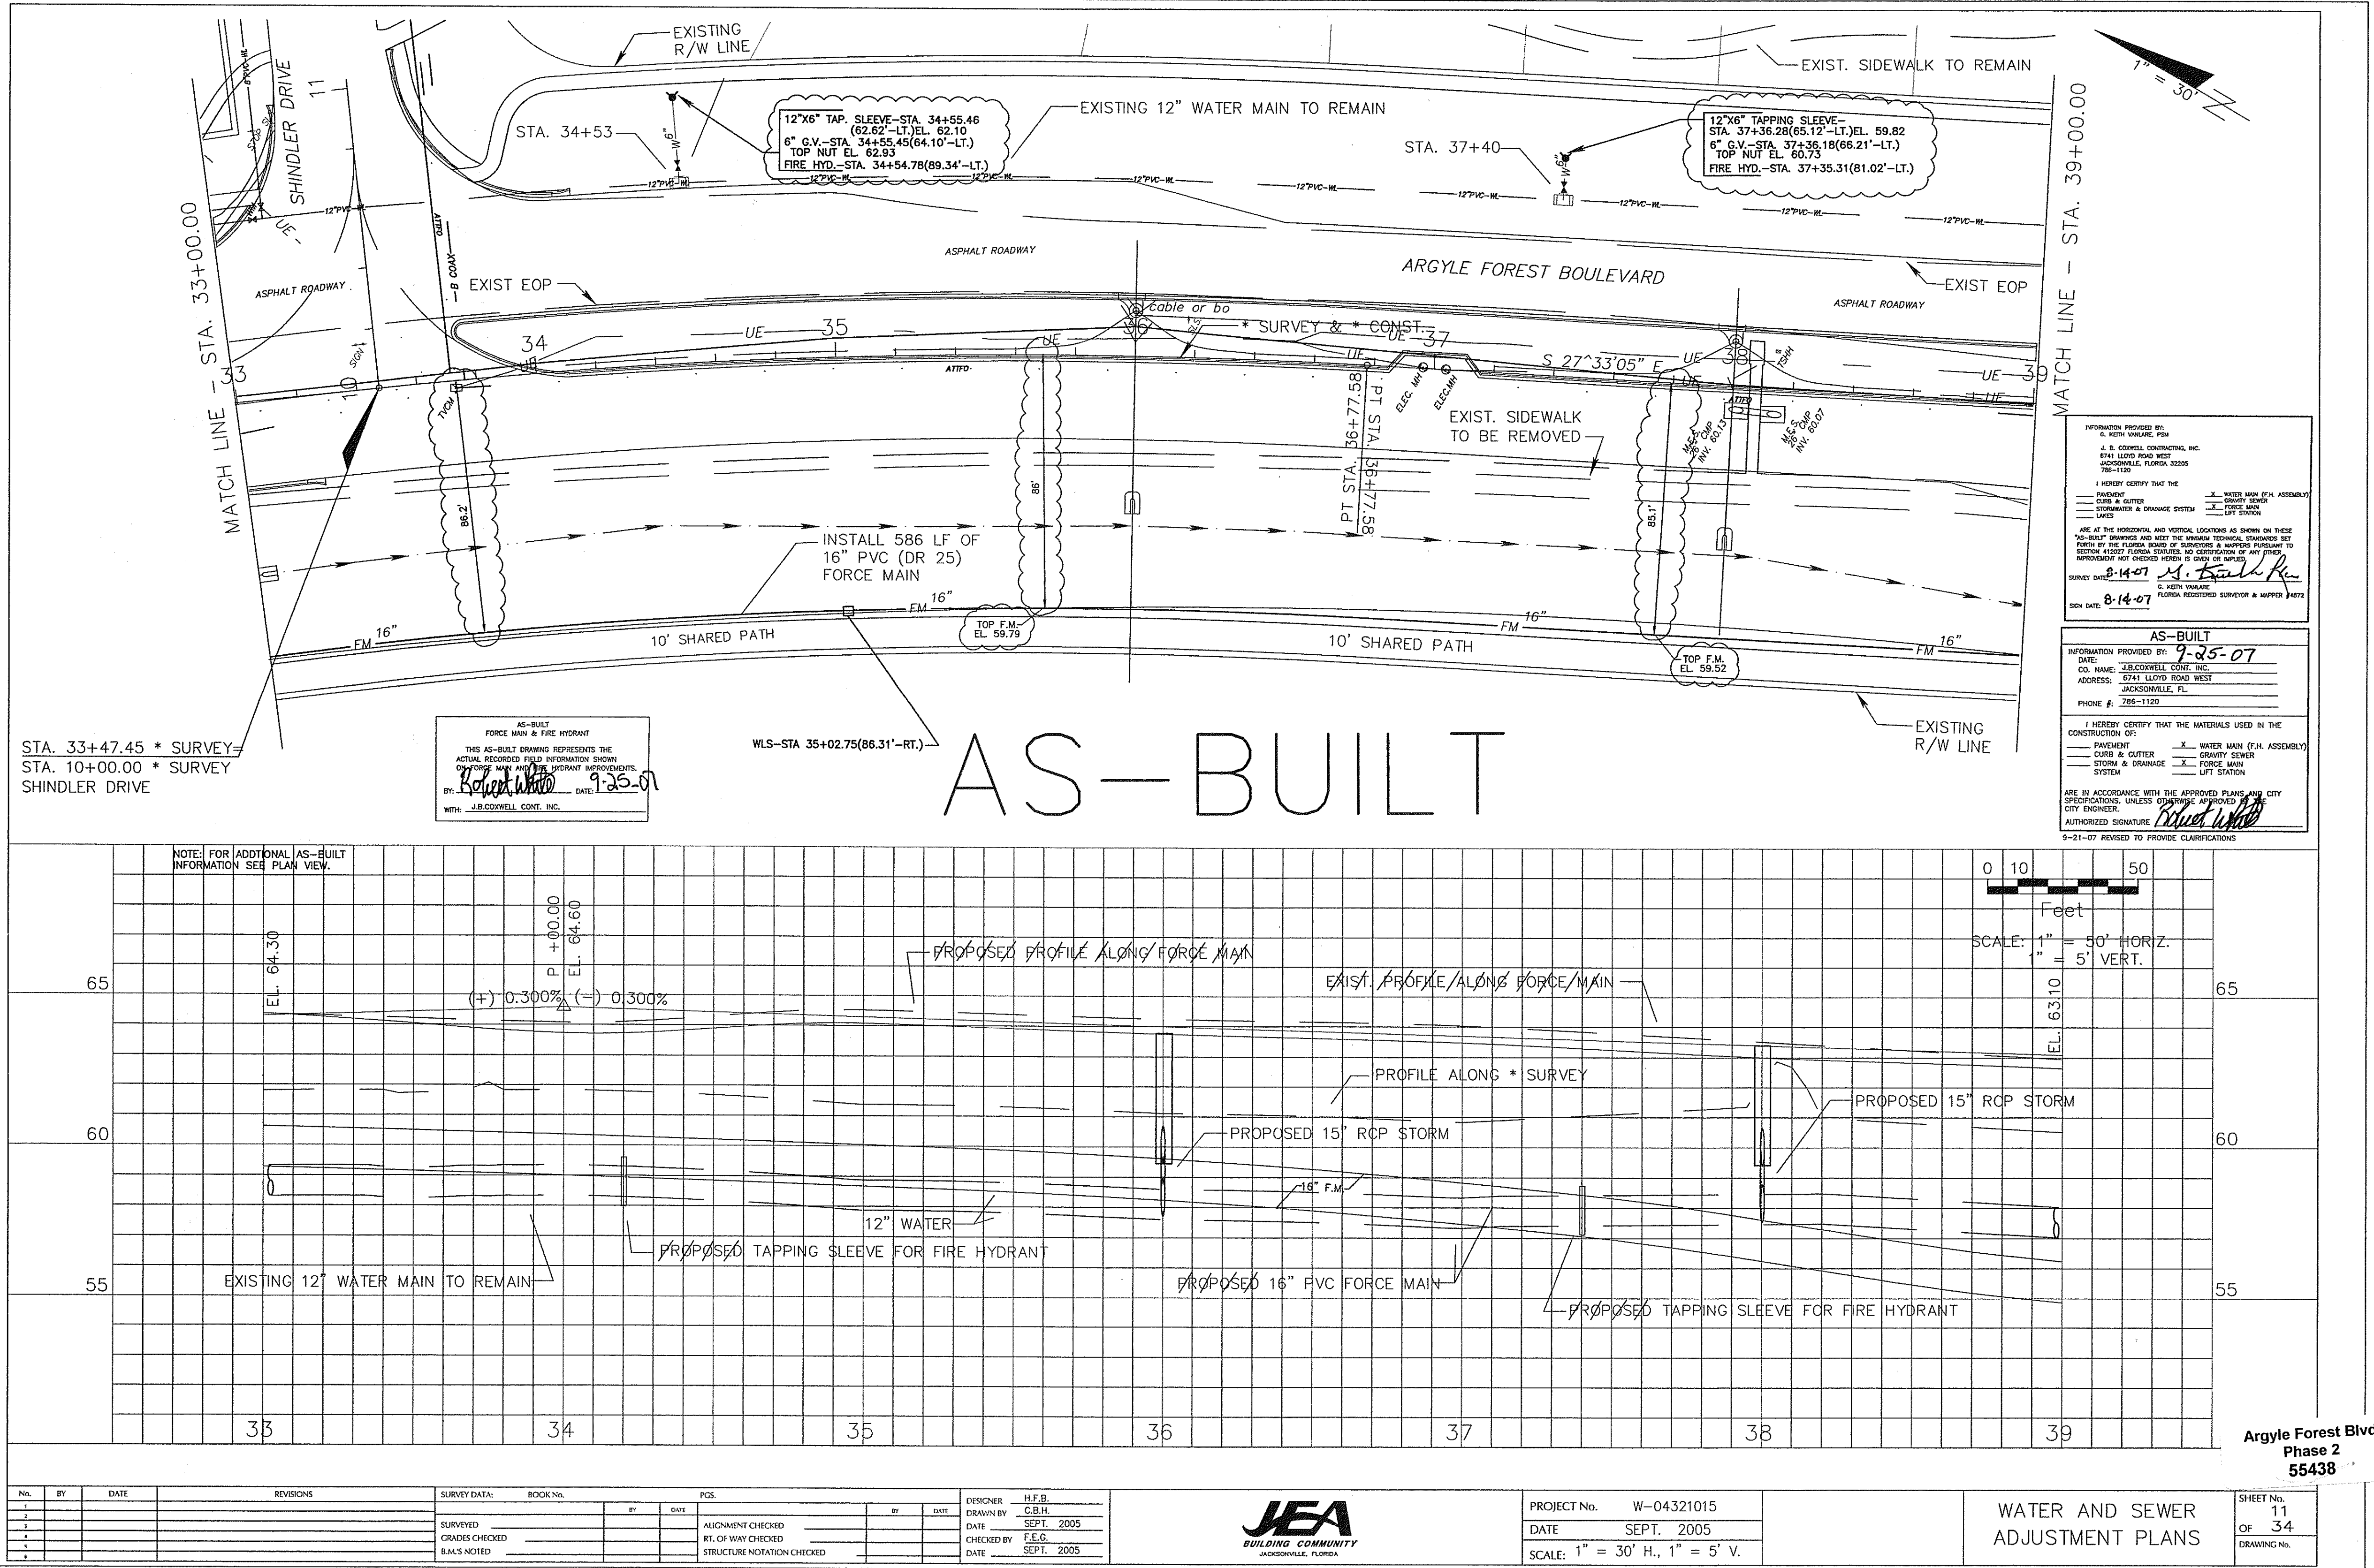

No.		BY	DATE	REVISIONS		SURVEY DATA: BOOK No.		PCS		DESIGNER: H.F.B.			PROJECT No. W-04321015		WATER AND SEWER ADJUSTMENT PLANS	SHEET No. 11	
1										DRAWN BY: C.B.H.			DATE: SEPT. 2005			OF 34	
2										CHECKED BY: F.E.G.			DATE: SEPT. 2005				
3										ALIGNMENT CHECKED							
4										RT. OF WAY CHECKED							
5										STRUCTURE NOTATION CHECKED						DRAWING No.	
6																	
7																	
8																	
9																	

Argyle Forest Blvd
Phase 2
55438

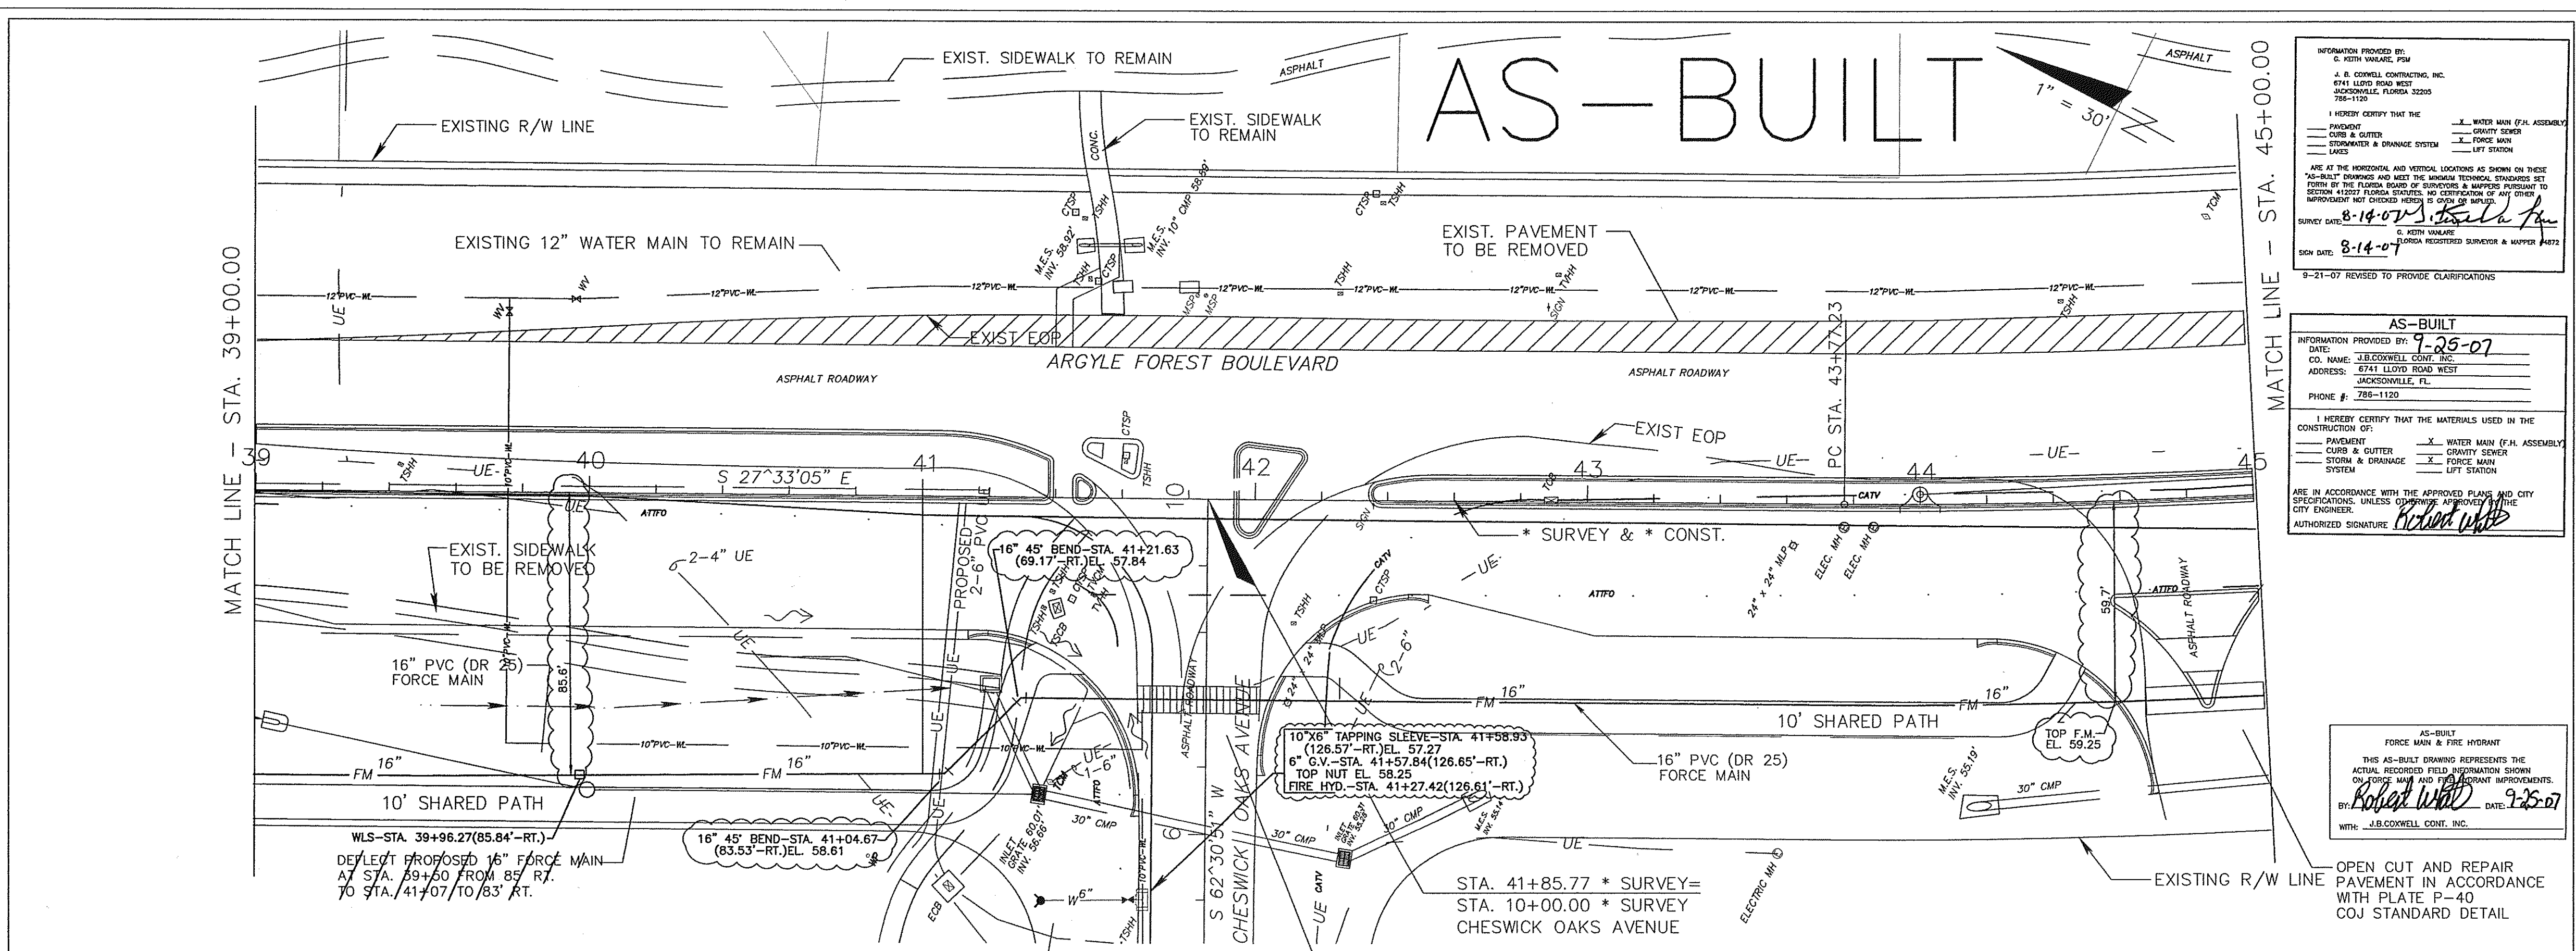

INFORMATION PROVIDED BY:
J. R. CORNELL CONTRACTING, INC.
6741 LLOYD ROAD WEST
JACKSONVILLE, FLORIDA 32205
786-1120

I HEREBY CERTIFY THAT THE
PAVEMENT _____
CURB & GUTTER _____
STORMWATER & DRAINAGE SYSTEM _____
WATER MAIN (F.H. ASSEMBLY) _____
SEWER _____
FORCE MAIN _____
LIFT STATION _____

ARE AT THE HORIZONTAL AND VERTICAL LOCATIONS AS SHOWN ON THESE
AS-BUILT DRAWINGS AND MEET THE MINIMUM TECHNICAL SPECIFICATIONS SET
FORTH BY THE FLORIDA BOARD OF SURVEYORS & SURVEYORS EQUIVALENT TO
SECTION 41252 FLORIDA STATUTES. NO CORRECTION OF ANY OTHER
INFORMATION NOT SHOWN HEREIN IS OFFERED.

SURVEY DATE: 8-14-07
SIGN DATE: 8-14-07
G. JOHN WALKER
FLORIDA REGISTERED SURVEYOR & MAPPER #4872

8-21-07 REVISED TO PROVIDE CLARIFICATIONS


AS-BUILT
INFORMATION PROVIDED BY: 7-25-07
DATE: 7-25-07
CD. NAME: J.R. CORNELL, INC.
ADDRESS: 6741 LLOYD ROAD WEST
JACKSONVILLE, FL
PHONE #: 786-1120

I HEREBY CERTIFY THAT THE MATERIALS USED IN THE
CONSTRUCTION OF:
PAVEMENT _____
CURB & GUTTER _____
STORM & DRAINAGE _____
SYSTEM _____
WATER MAIN (F.H. ASSEMBLY) _____
SEWER _____
FORCE MAIN _____
LIFT STATION _____

ARE IN ACCORDANCE WITH THE APPROVED PLANS AND CITY
SPECIFICATIONS, UNLESS OTHERWISE NOTED BY THE
CITY ENGINEER.


AUTHORIZED SIGNATURE: Robert W. Walker

AS-BUILT
FORCE MAIN & FIRE HYDRANT
THIS AS-BUILT DRAWING REPRESENTS THE
ACTUAL RECORDED FIELD INFORMATION SHOWN
ON THESE PLANS AND PLOTTING IMPROVEMENTS.
BY: Robert W. Walker DATE: 7-25-07
WITH: J.R. CORNELL, INC.

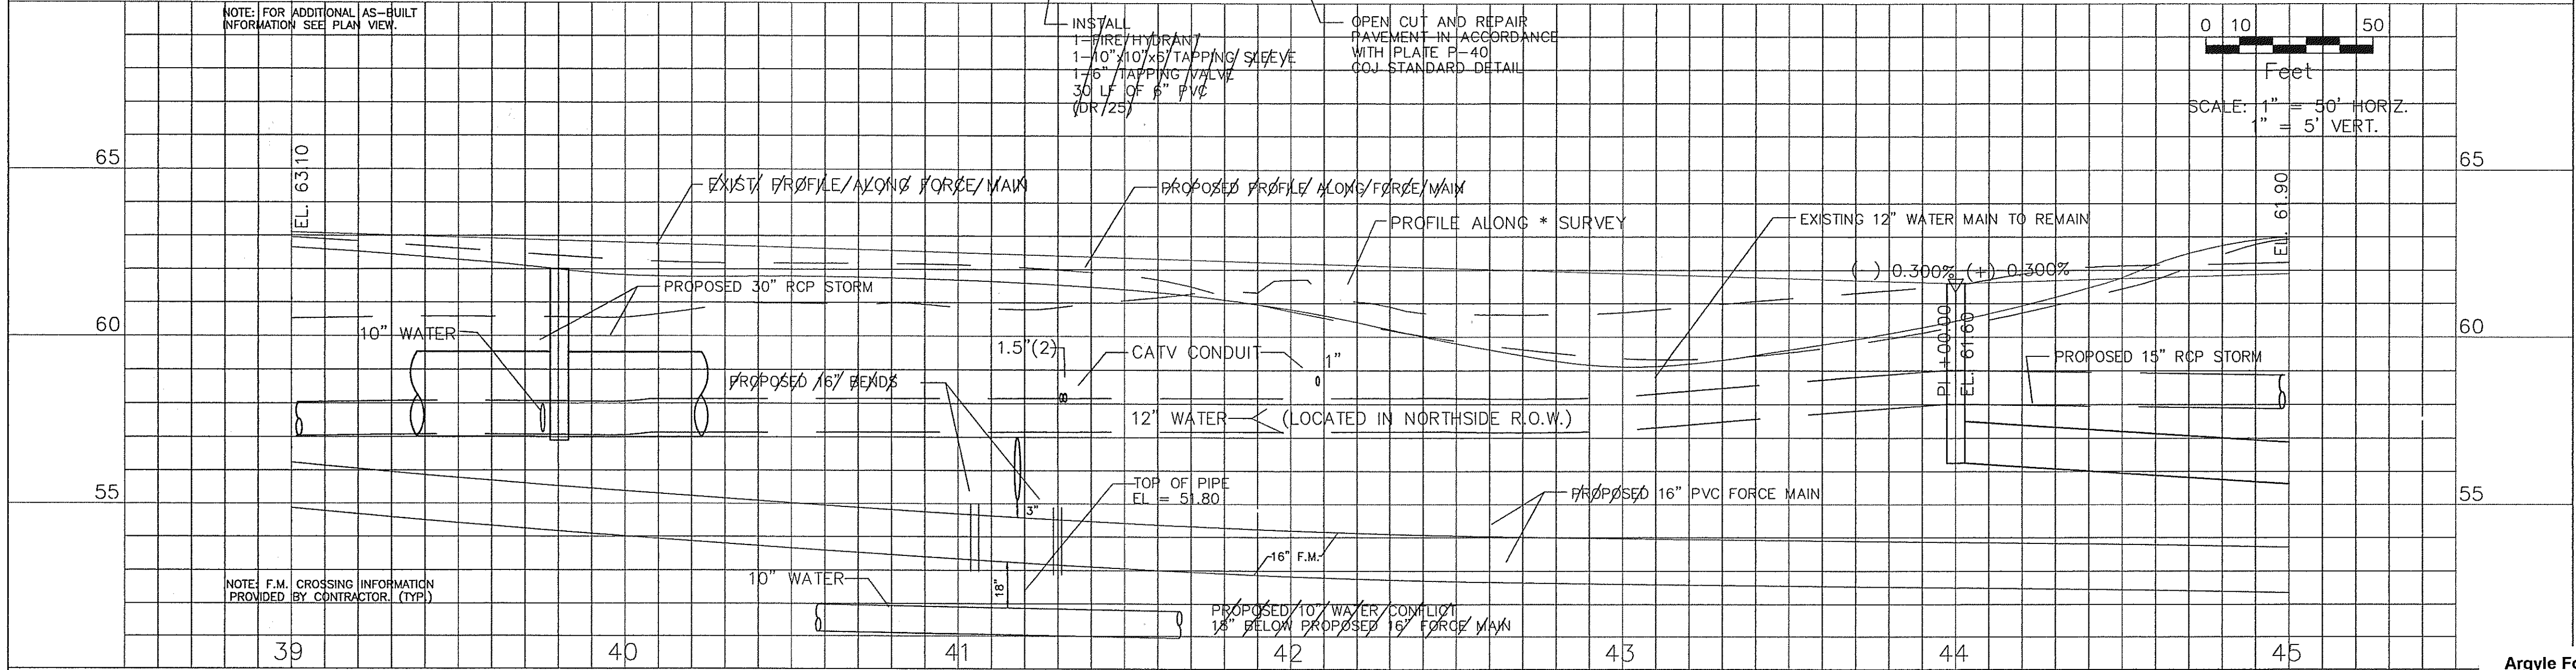

No.	BY	DATE	REVISIONS	SURVEY DATA:	BOOK No.	BY	DATE	PCS.	DESIGNER	H.F.B.
1				SURVEYED					DATE	SEPT. 2005
2				GRADES CHECKED					CHECKED BY	F.E.G.
3				B.M.S. NOTED					DATE	SEPT. 2005

ALIGNMENT CHECKED	BY	DATE	STRUCTURE NOTATION CHECKED	BY	DATE

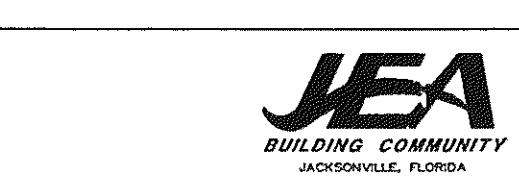


PROJECT No. W-04321015
DATE SEPT. 2005
SCALE: 1" = 30' H., 1" = 5' V.

WATER AND SEWER
ADJUSTMENT PLANS

SHEET No. 12
OF 34
DRAWING No.

Argyle Forest Blvd
Phase 2
55439

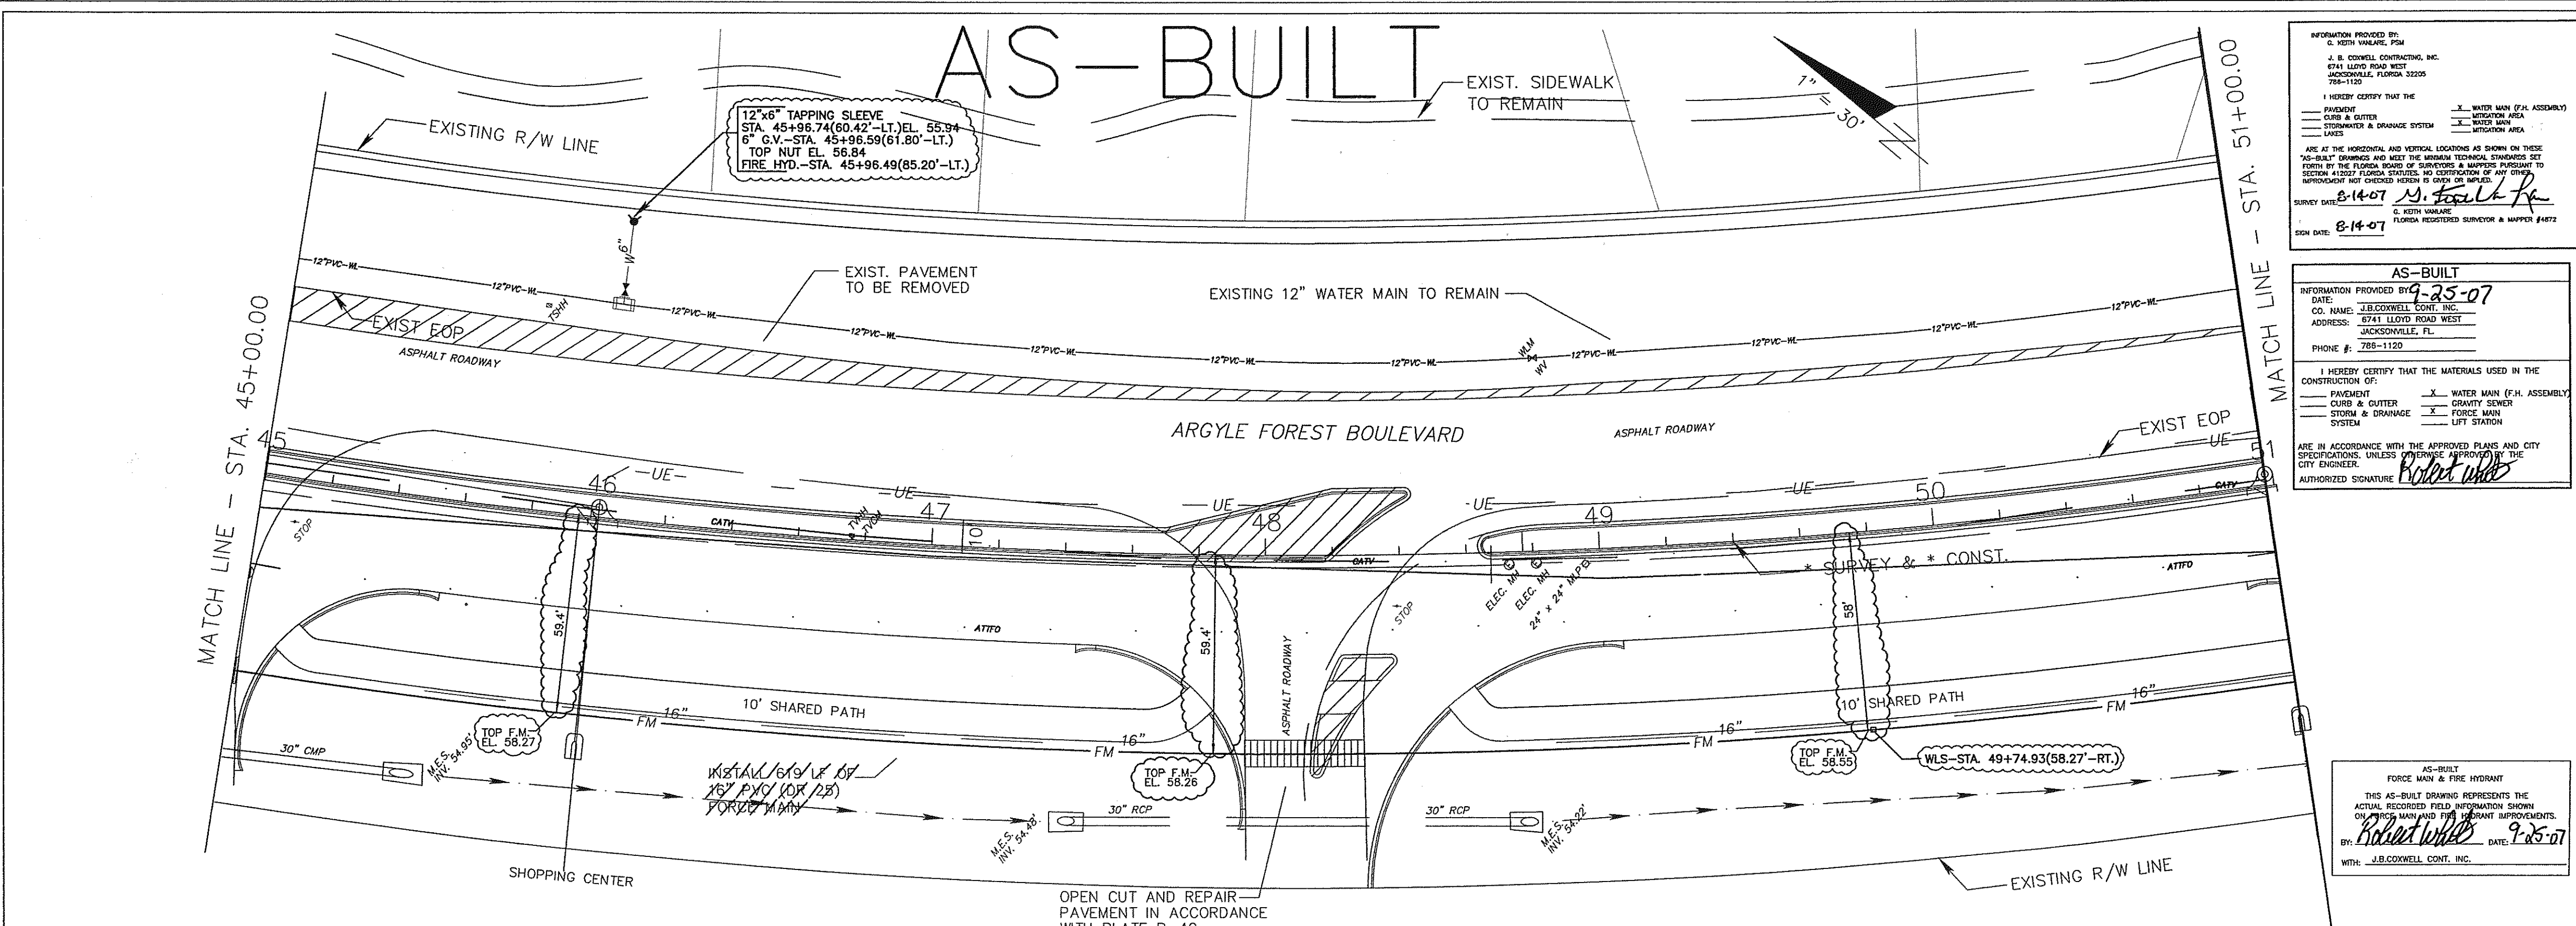

INFORMATION PROVIDED BY:
J. B. CONWELL CONTRACTING, INC.
6741 LLOYD ROAD WEST
JACKSONVILLE, FLORIDA 32205
784-1120

I HEREBY CERTIFY THAT THE
PAVEMENT _____
CURBS & GUTTERS _____
STORMWATER & DRAINAGE SYSTEM _____
LINES _____
WATER MAIN (F.H. ASSEMBLY) _____
STORMWATER MAIN _____
LIFT STATION _____

ARE AT THE HORIZONTAL AND VERTICAL LOCATIONS AS SHOWN ON THESE
AS-BUILT DRAWINGS AND MEET THE MINIMUM TECHNICAL STANDARDS SET
FORTH BY THE FLORIDA BOARD OF SURVEYORS & MAPPERS PURSUANT TO
SECTION 460.01, FLORIDA STATUTES, AND THE FLORIDA BOARD OF
SURVEYORS & MAPPERS. APPROVED FOR THE CITY ENGINEER.

SURVEY DATE: 8-14-07
DATE: 9-25-07
BY: J.B. CONWELL
FLORIDA REGISTERED SURVEYOR & MAPPER #4872


AS-BUILT
INFORMATION PROVIDED BY: 9-25-07
DATE: 9-25-07
CO. NAME: J.B. CONWELL CONTRACTING, INC.
ADDRESS: 6741 LLOYD ROAD WEST
JACKSONVILLE, FL.
PHONE #: 784-1120

I HEREBY CERTIFY THAT THE MATERIALS USED IN THE
CONSTRUCTION OF:
PAVEMENT _____
CURBS & GUTTERS _____
STORM & DRAINAGE _____
SYSTEM _____
WATER MAIN (F.H. ASSEMBLY) _____
STORMWATER MAIN _____
LIFT STATION _____

ARE IN ACCORDANCE WITH THE APPROVED PLANS AND CITY
SPECIFICATIONS, UNLESS OTHERWISE APPROVED BY THE
CITY ENGINEER.

AUTHORIZED SIGNATURE: Robert White

AS-BUILT
FORCE MAIN & FIRE HYDRANT
THIS AS-BUILT DRAWING REPRESENTS THE
ACTUAL RECORDED FIELD INFORMATION SHOWN
ON THESE PLANS AND THE RECORDED APPROVED
BY: Robert White DATE: 9-25-07
WITH: J.B. CONWELL CONT. INC.

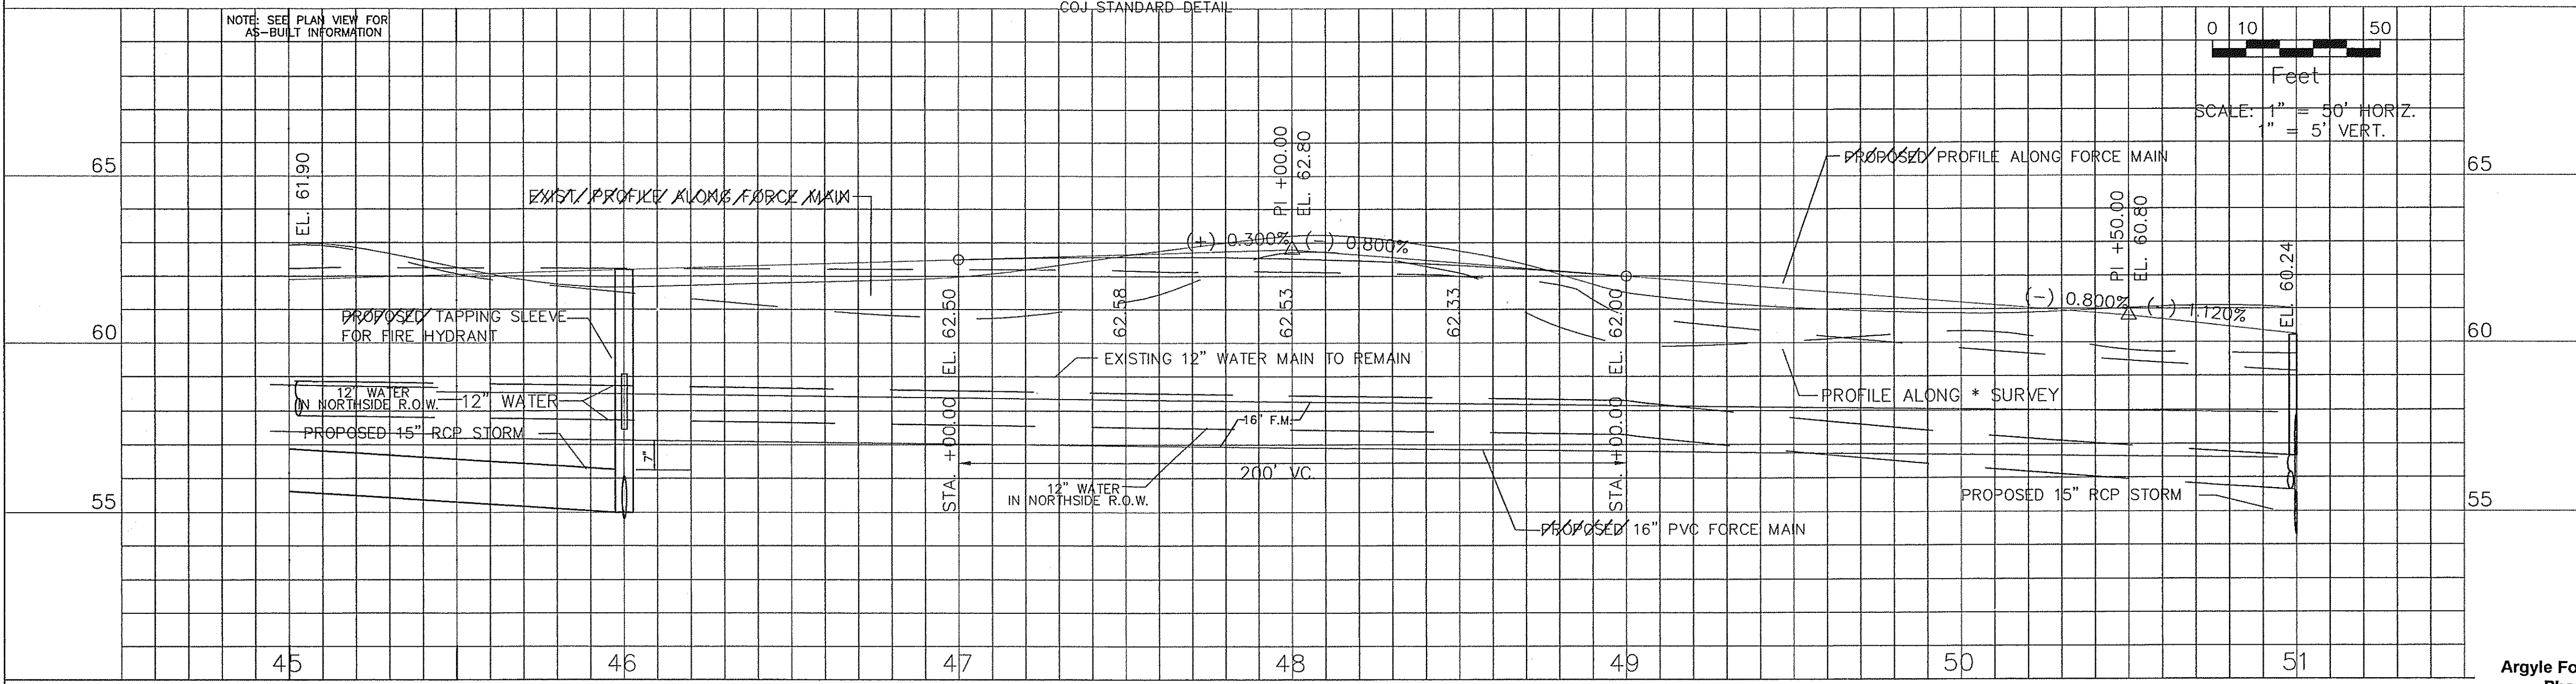

No.	BY	DATE	REVISIONS	SURVEY DATA	BOOK NO.	POS.	DESIGNER	H.F.B.
1								
2								
3								
4								
5								
6								

BY	DATE	DESIGNER	H.F.B.

BY	DATE	DESIGNER	H.F.B.

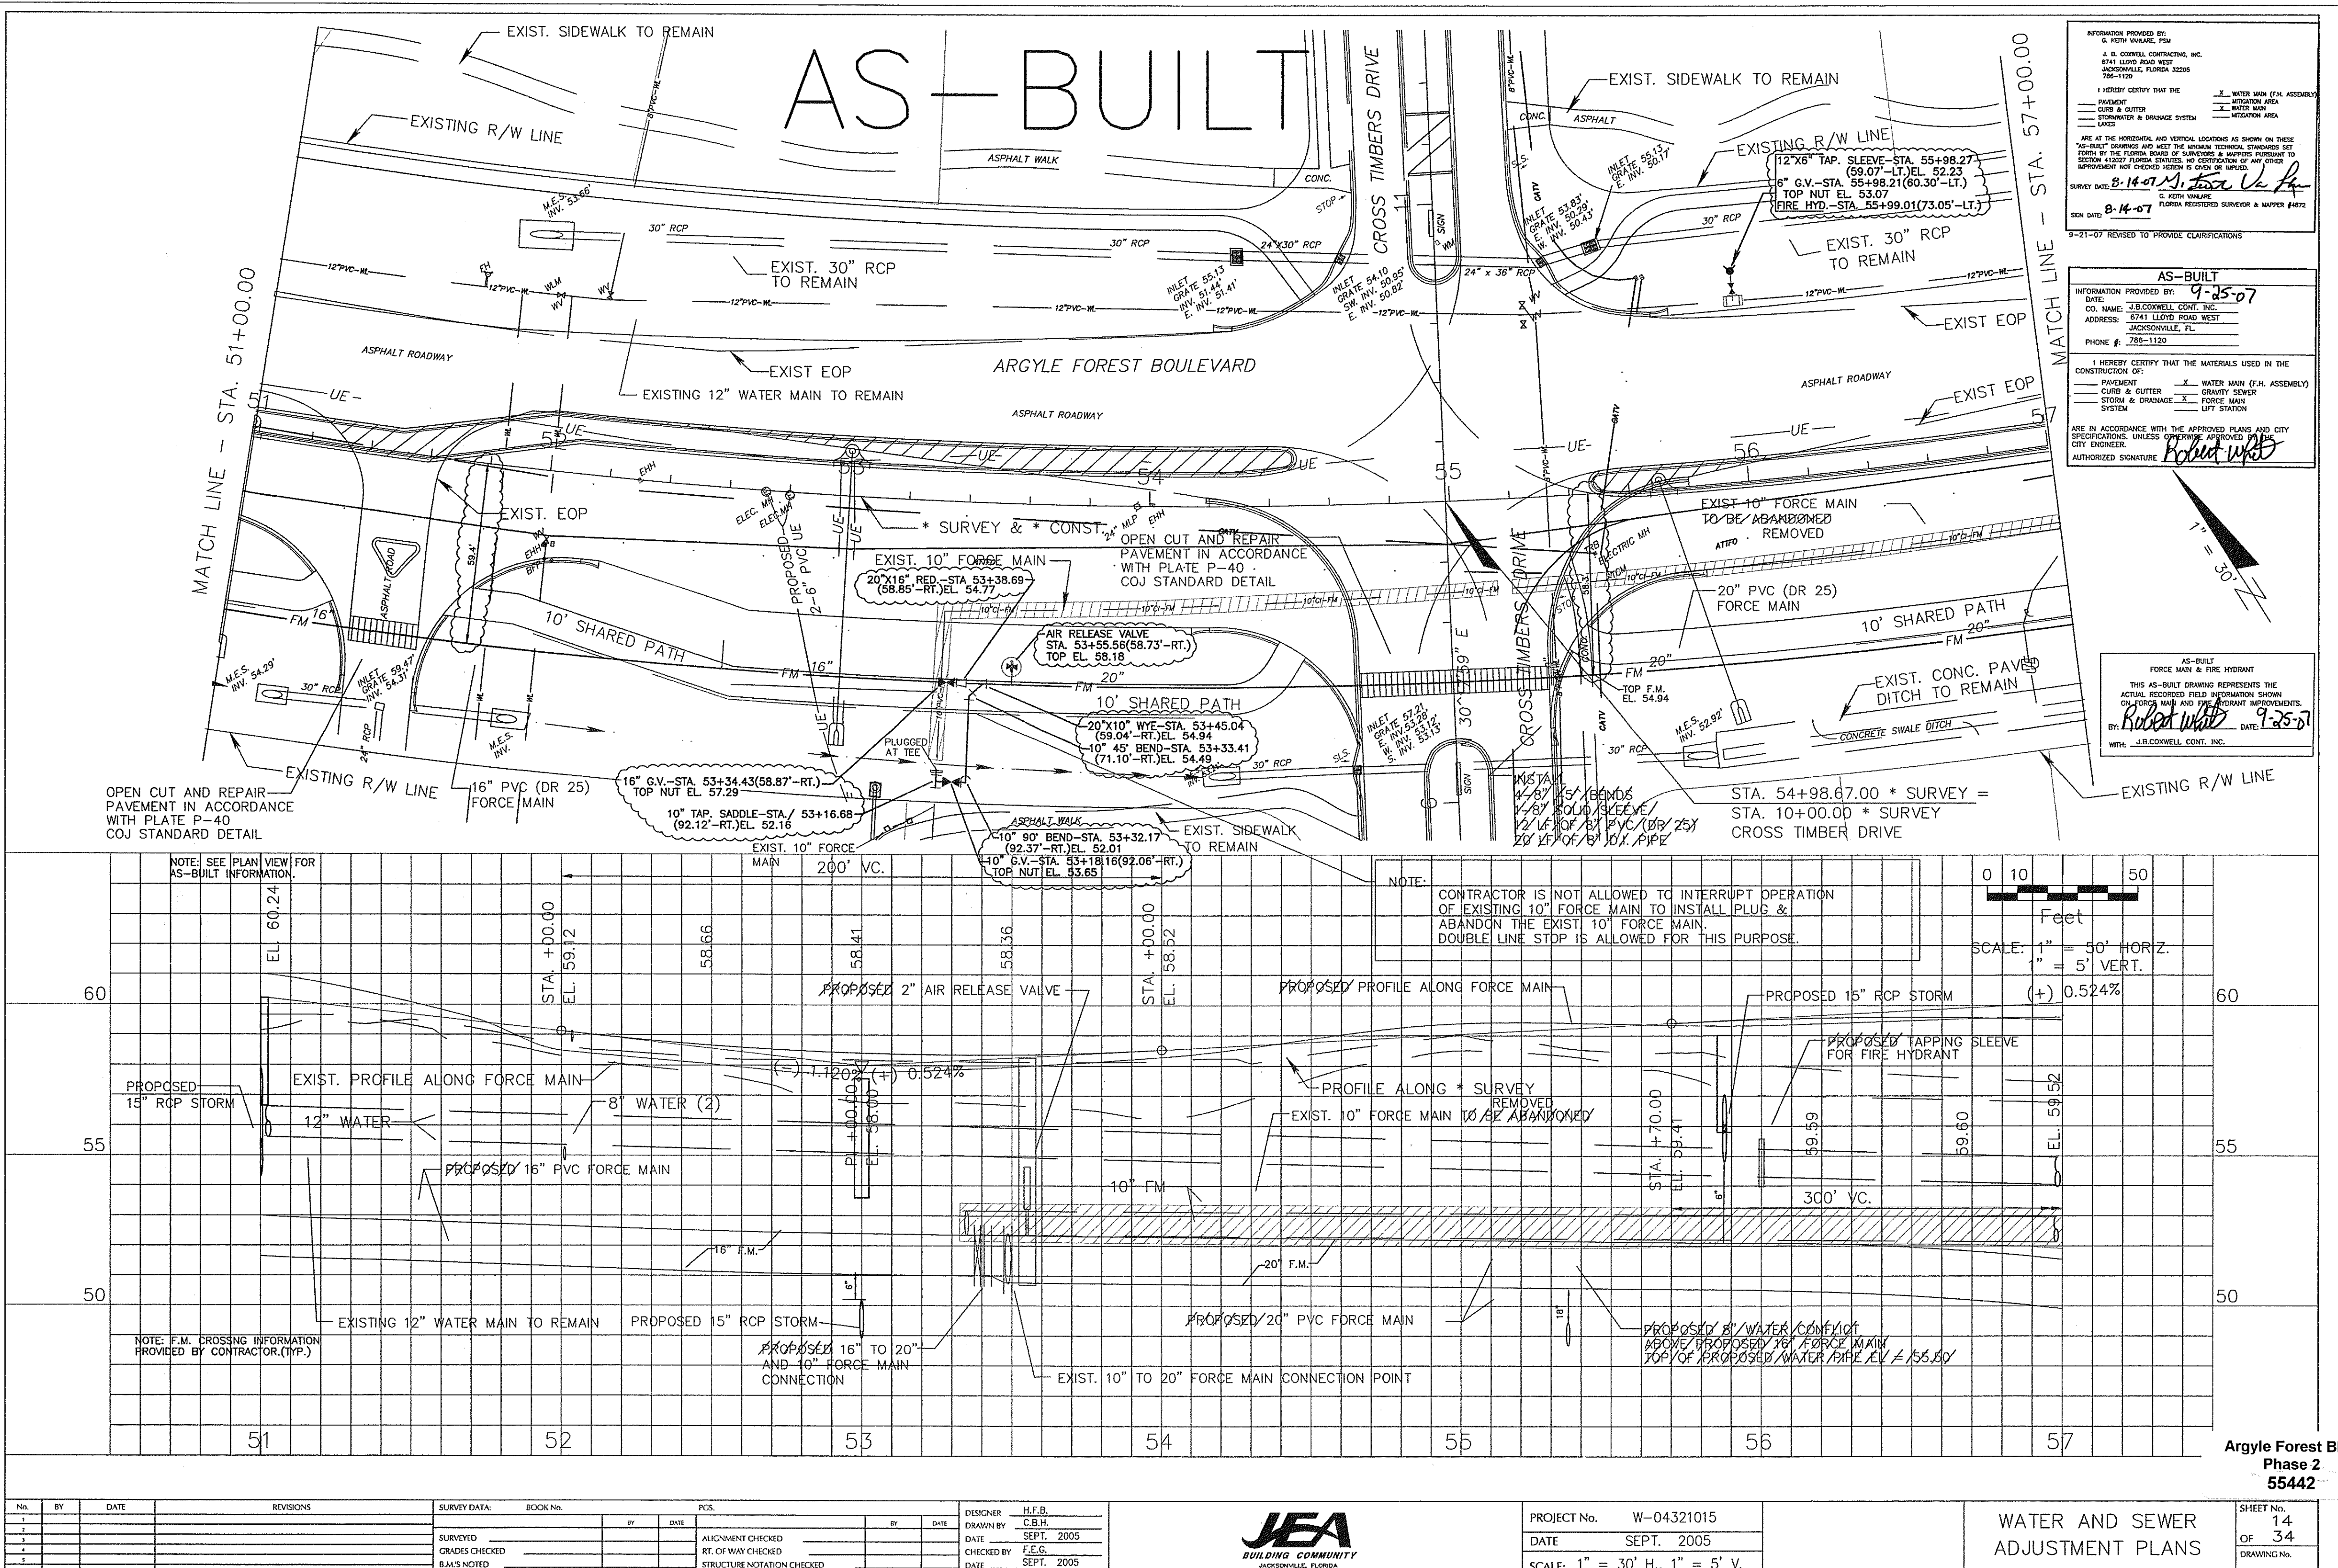

INFORMATION PROVIDED BY:
G. KATH VALUAS, P.E.
J. B. CORWELL CONTRACTING, INC.
8041 LUDLO ROAD WEST
JACKSONVILLE, FLORIDA 32205
325-1100

I HEREBY CERTIFY THAT THE
PROJECT
CONSTRUCTION AREA
FORMERLY A DRAINAGE SYSTEM
LAYOUT

ARE AT THE HORIZONTAL AND VERTICAL LOCATIONS AS SHOWN ON THESE
10-BUILT DRAWINGS AND MEET THE MINIMUM TECHNICAL STANDARDS SET
FORWARD BY THE FLORIDA BOARD OF SURVEYING & MAPPING PURSUANT TO
SECTION 110.07, FLORIDA STATUTES, AND THE FLORIDA BOARD OF SURVEYING & MAPPING
APPROPRIATELY NOTED OTHERWISE TO THE CONTRARY.

SURVEY DATE: 8-14-07
G. KATH VALUAS
FLORIDA REGISTERED SURVEYOR & MAPPER #4872

DATE: 9-21-07
9-21-07 REVISION TO PROVIDE CLARIFICATIONS

AS-BUILT
INFORMATION PROVIDED BY: 9-25-07
DATE: 9-25-07
CO. NAME: J.B. CORWELL CONTRACTING, INC.
ADDRESS: 8041 LUDLO ROAD WEST
JACKSONVILLE, FL
PHONE #: 325-1120

I HEREBY CERTIFY THAT THE MATERIALS USED IN THE
CONSTRUCTION OF:
PROJECT
CLUB & OUTLET
STORM & DRAINAGE
SYSTEM
LIFT STATION

ARE IN ACCORDANCE WITH THE APPROVED PLANS AND CITY
SPECIFICATIONS, UNLESS OTHERWISE NOTED BY THE
CITY ENGINEER.

AUTHORIZED SIGNATURE: Robert White
DATE: 9-25-07
WITH: J.B. CORWELL CONTRACTING, INC.

No.	BY	DATE	REVISIONS	SURVEY DATA	BOOK No.	BY	DATE	PCS	DESIGNER	H.F.B.
1										
2										
3										
4										
5										
6										

SURVEYED	GRADES CHECKED	B.M.S. NOTED	ALIGNMENT CHECKED	RT. OF WAY CHECKED	STRUCTURE NOTATION CHECKED

DRAWN BY	C.B.H.	DATE	SEPT. 2005
CHECKED BY	F.E.G.	DATE	SEPT. 2005





PROJECT No. W-04321015
DATE SEPT. 2005
SCALE: 1" = 30' H., 1" = 5' V.

WATER AND SEWER
ADJUSTMENT PLANS

SHEET No. 14
OF 34
DRAWING No.

Argyle Forest Blvd
Phase 2
55442

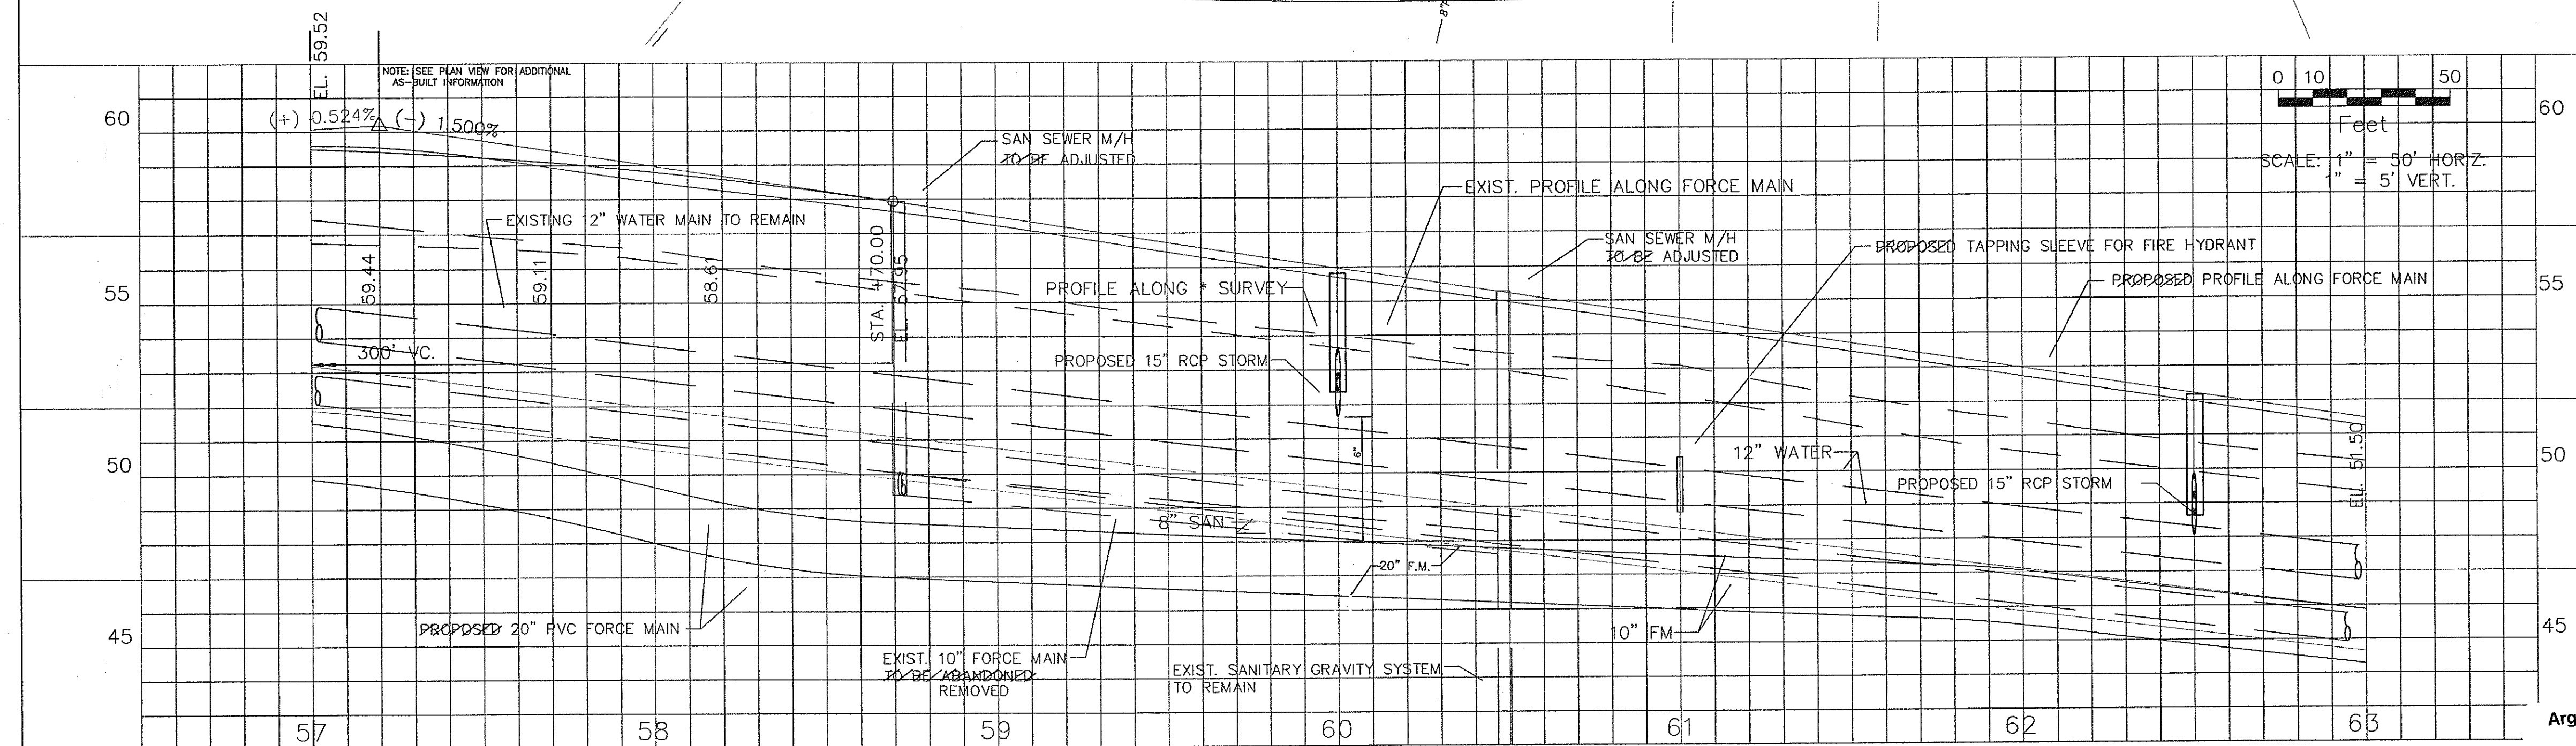
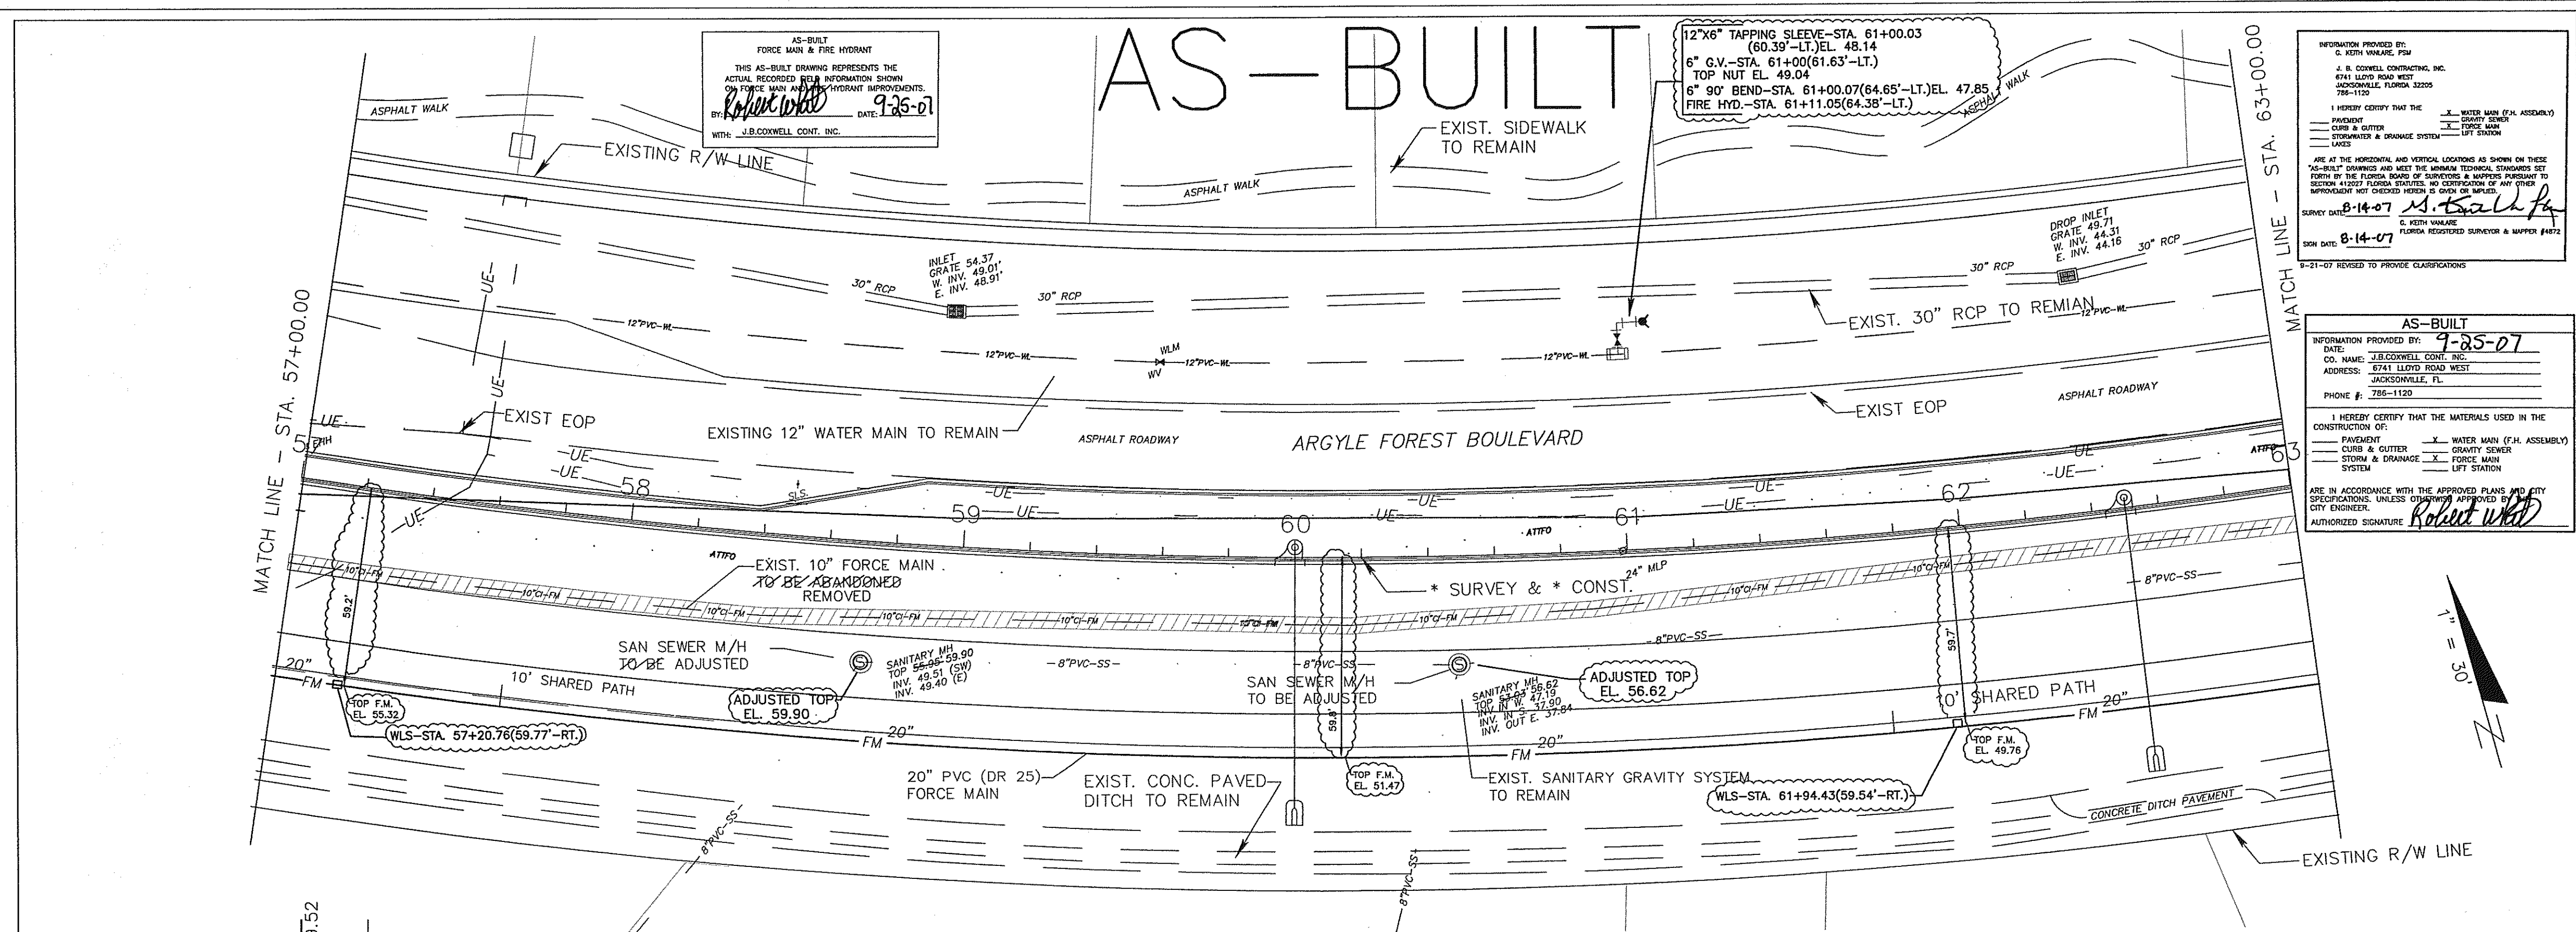
[illegible]

PROJECT No.	W-04321015
DATE	SEPT. 2005
SCALE:	1" = 30' H., 1" = 5' V.

WATER AND SEWER
ADJUSTMENT PLANS

SHEET No.	15
OF	34
DRAWING No.	

Argyle Forest Blvd
Phase 2
55443

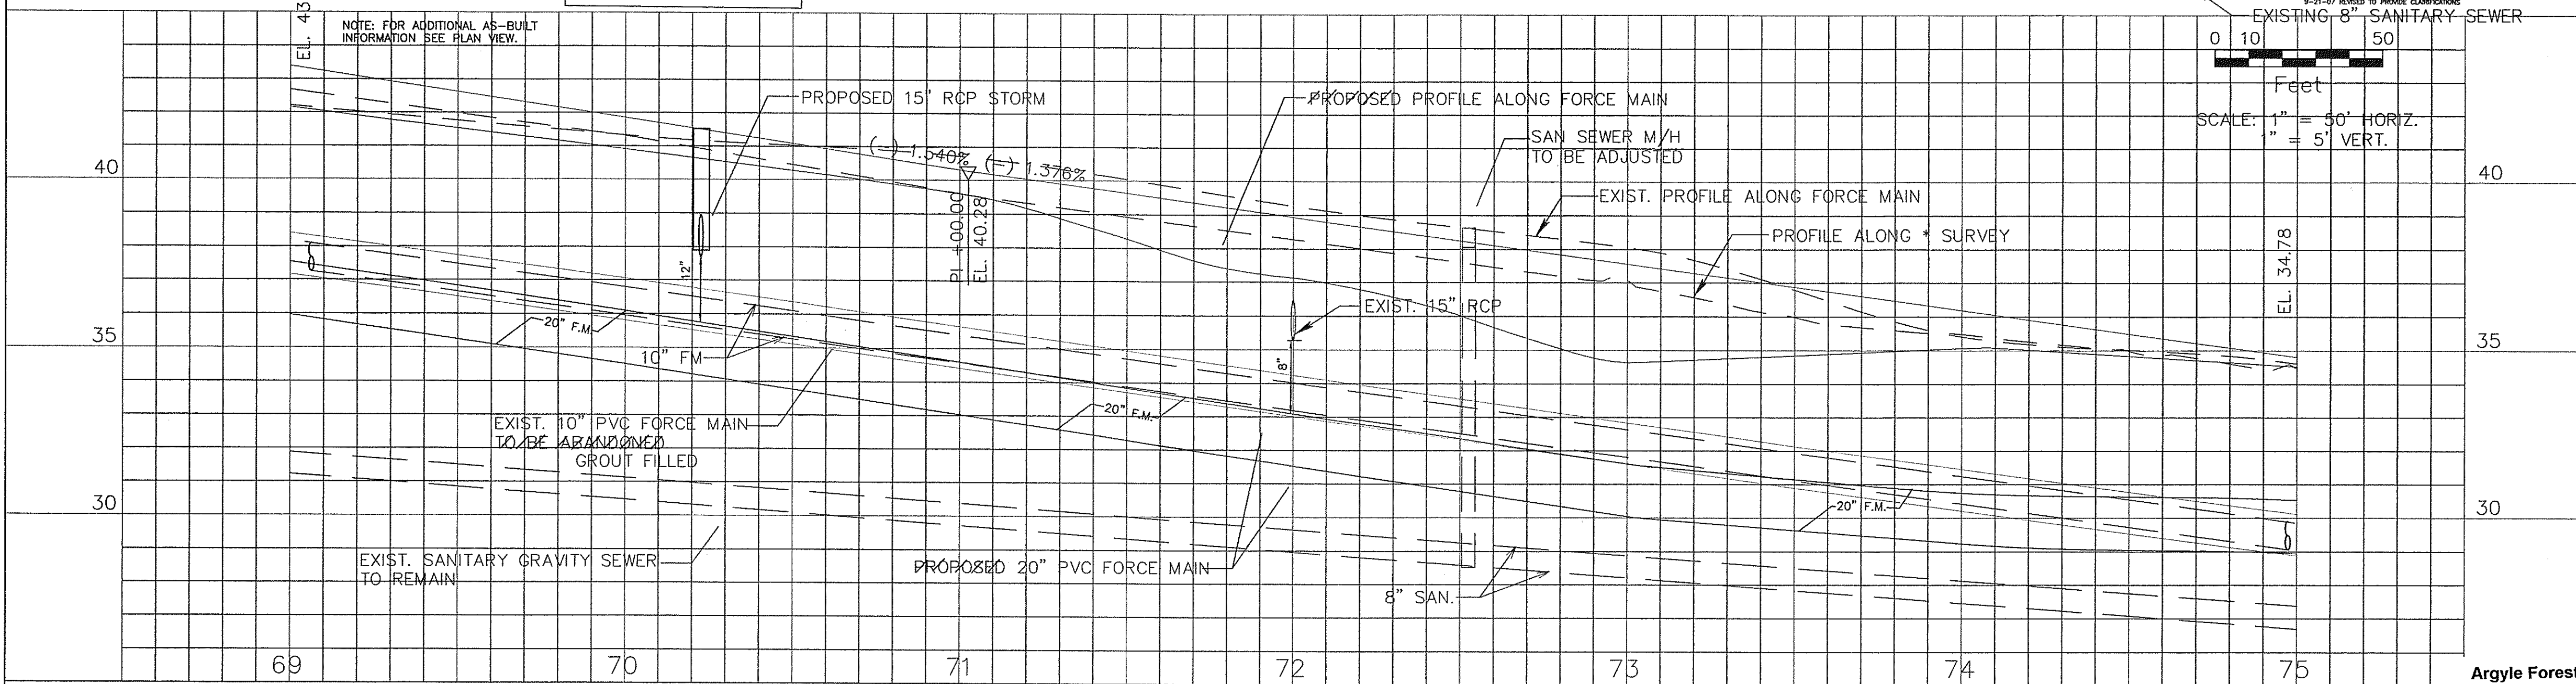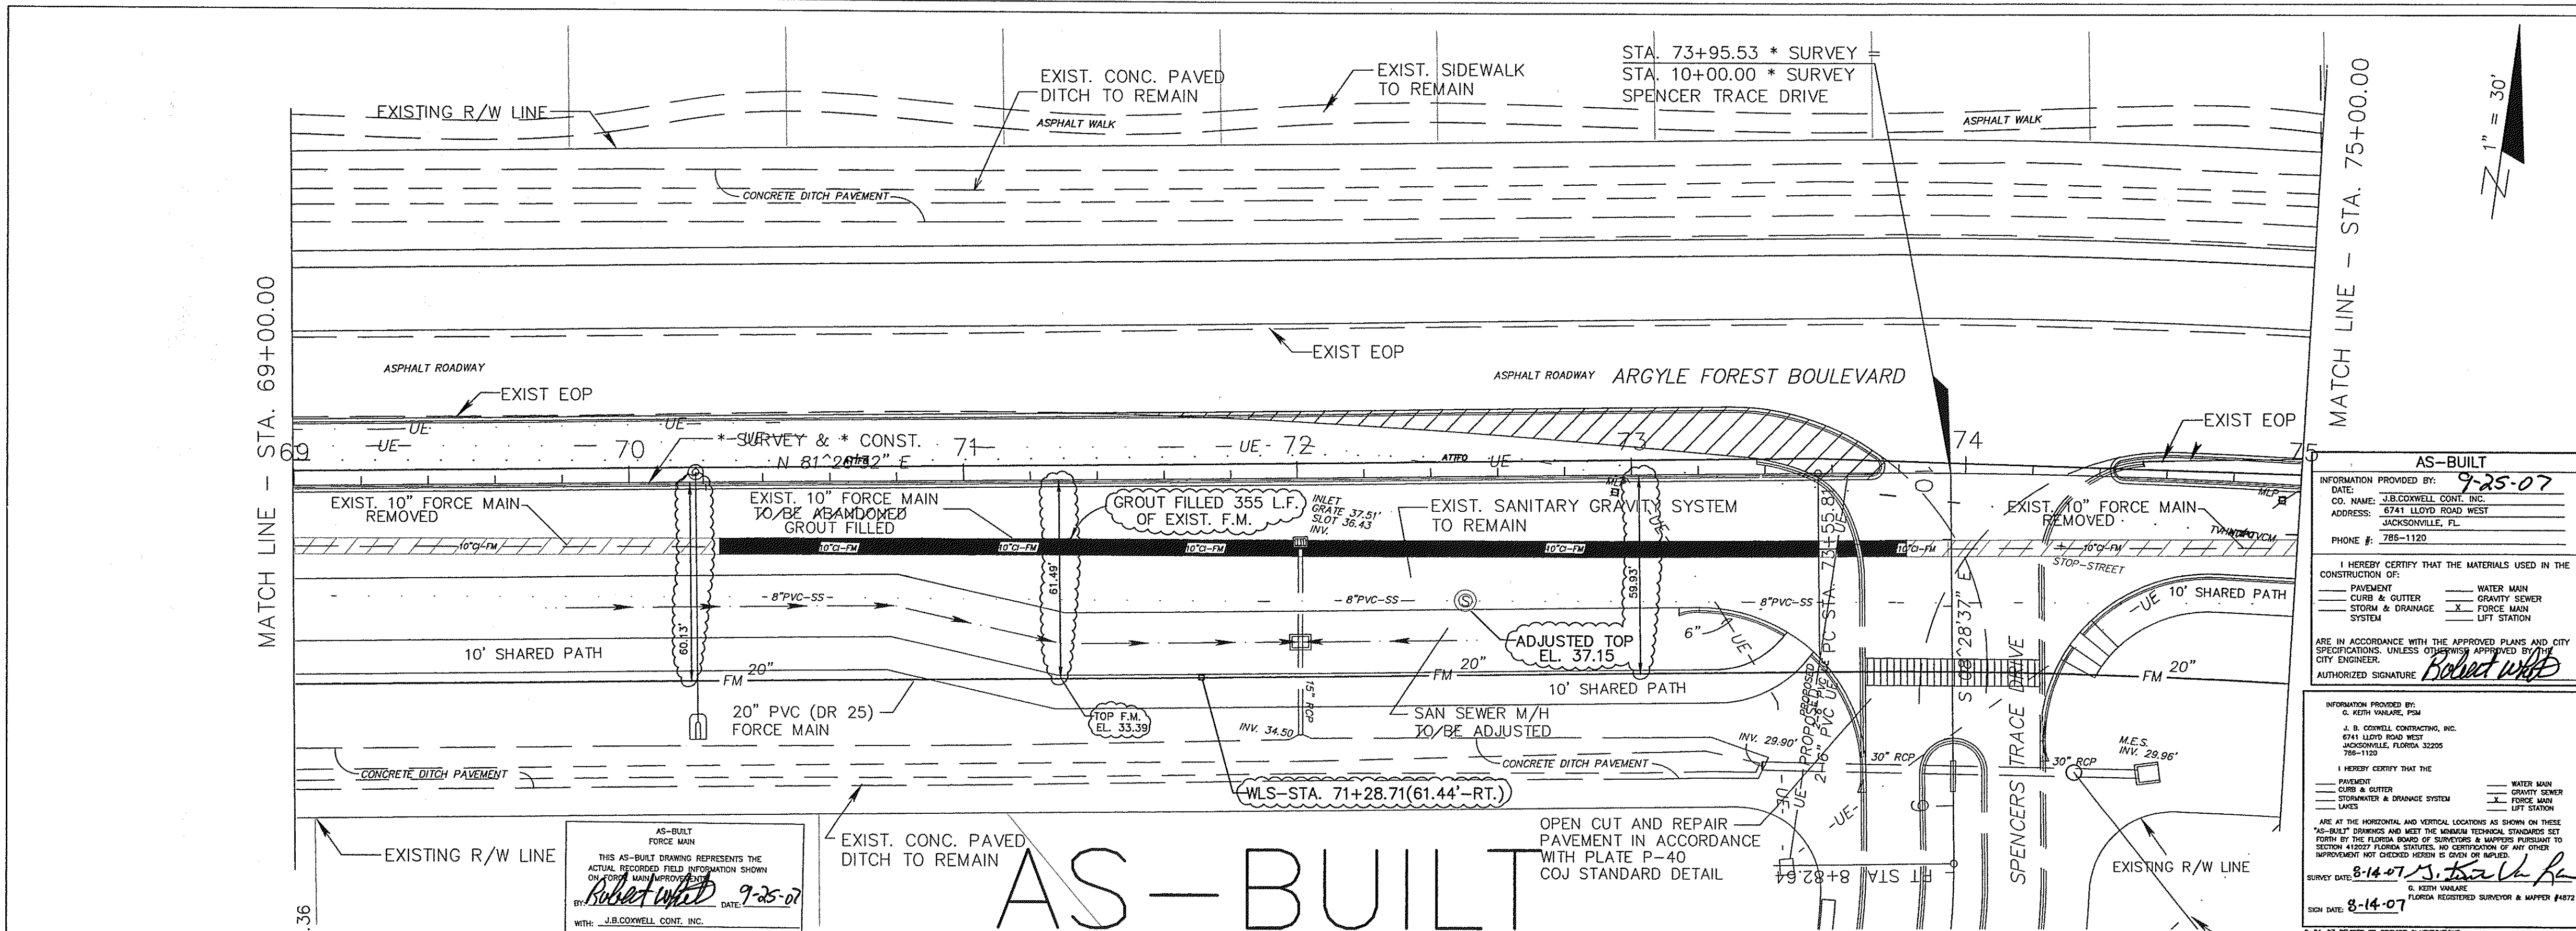

No.	BY	DATE	REVISIONS	SURVEY DATA:	BOOK No.	DATE	DESIGNER
1							H.F.B.
2							C.B.H.
3							SEPT. 2005
4							F.E.G.
5							SEPT. 2005




PROJECT No. W-04321015
DATE SEPT. 2005
SCALE: 1" = 30' H., 1" = 5' V.


WATER AND SEWER
ADJUSTMENT PLANS

SHEET No. 17
OF 34
DRAWING No.

Argyle Forest Blvd
Phase 2
55445

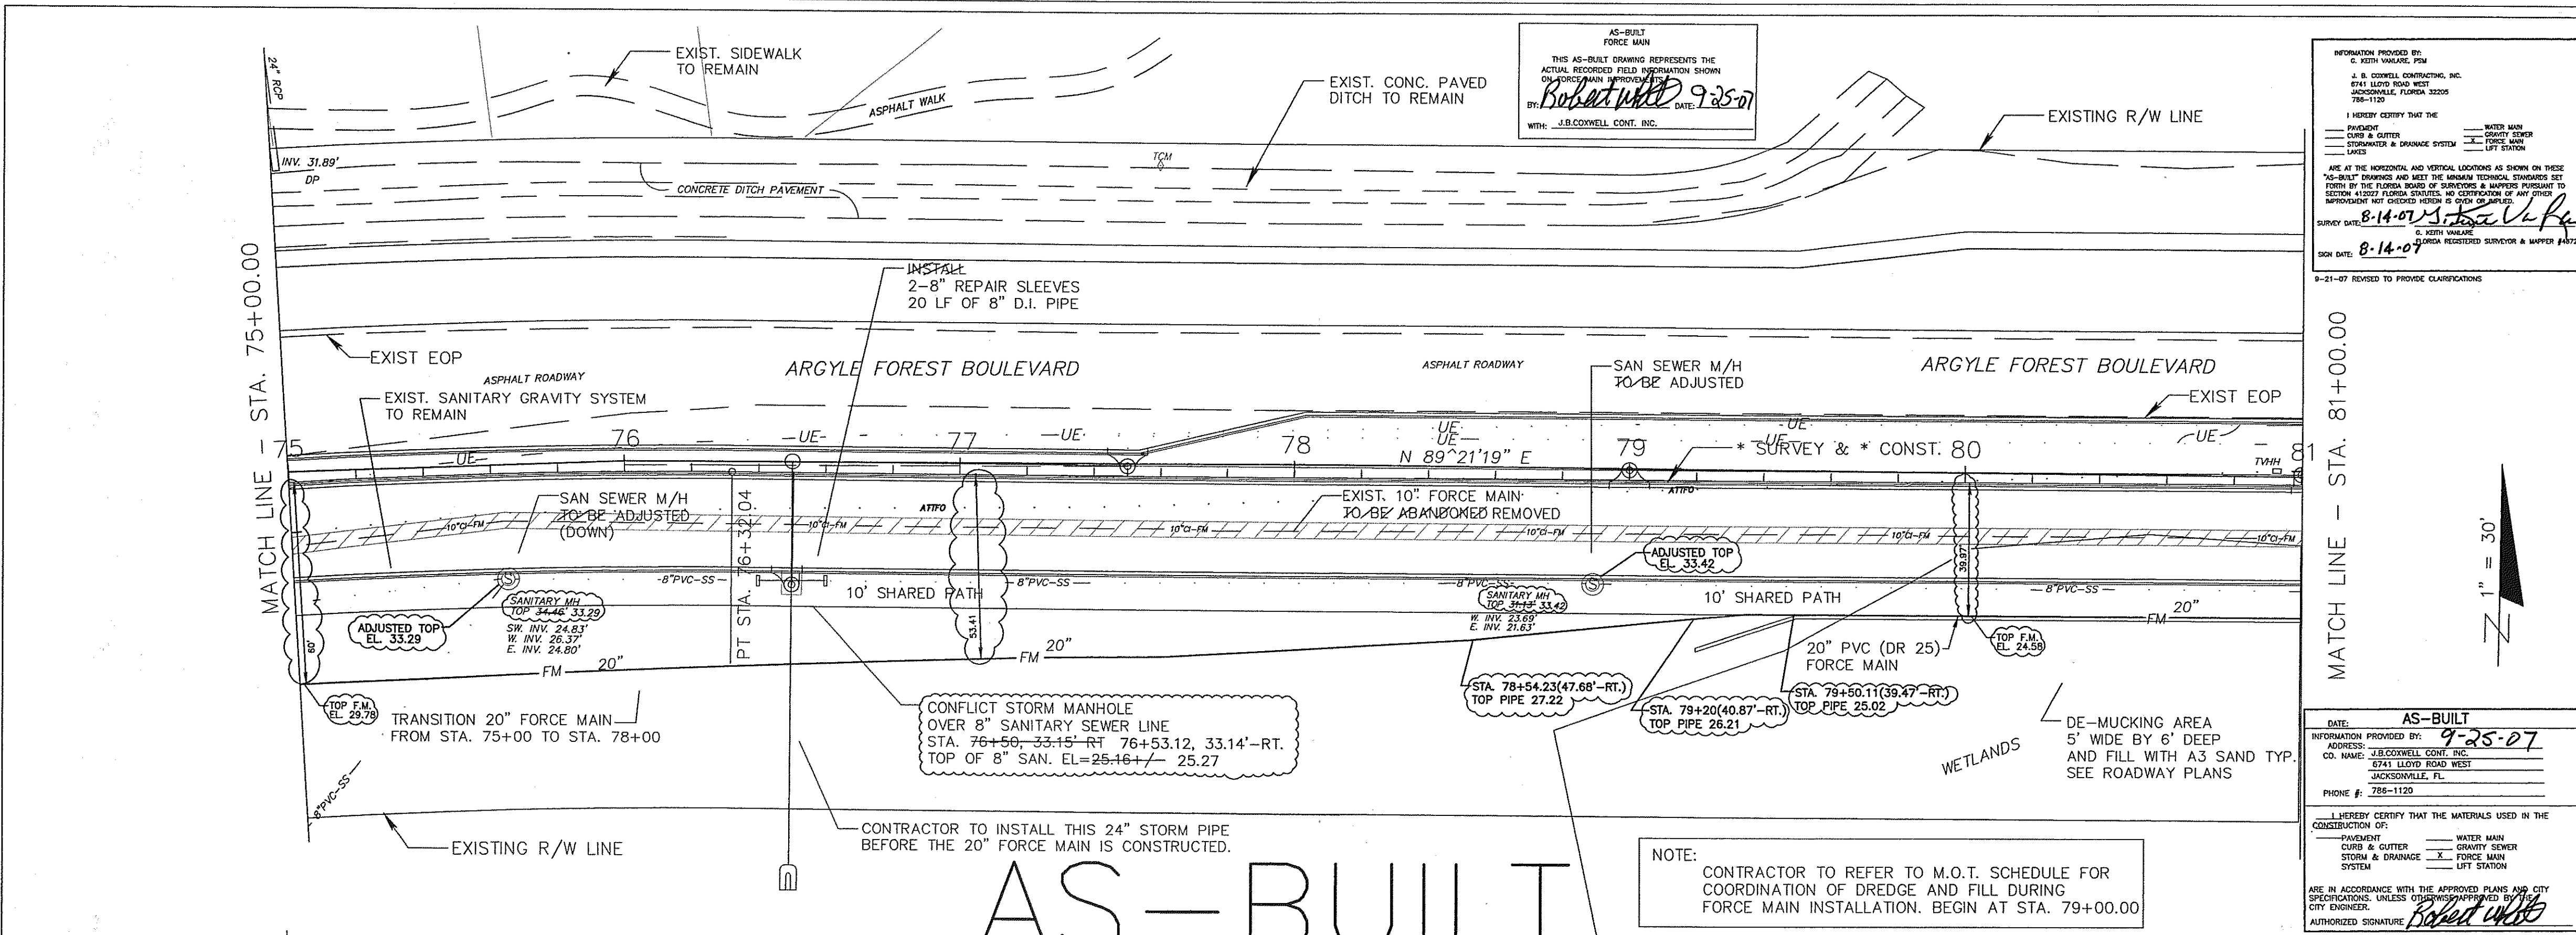

AS-BUILT

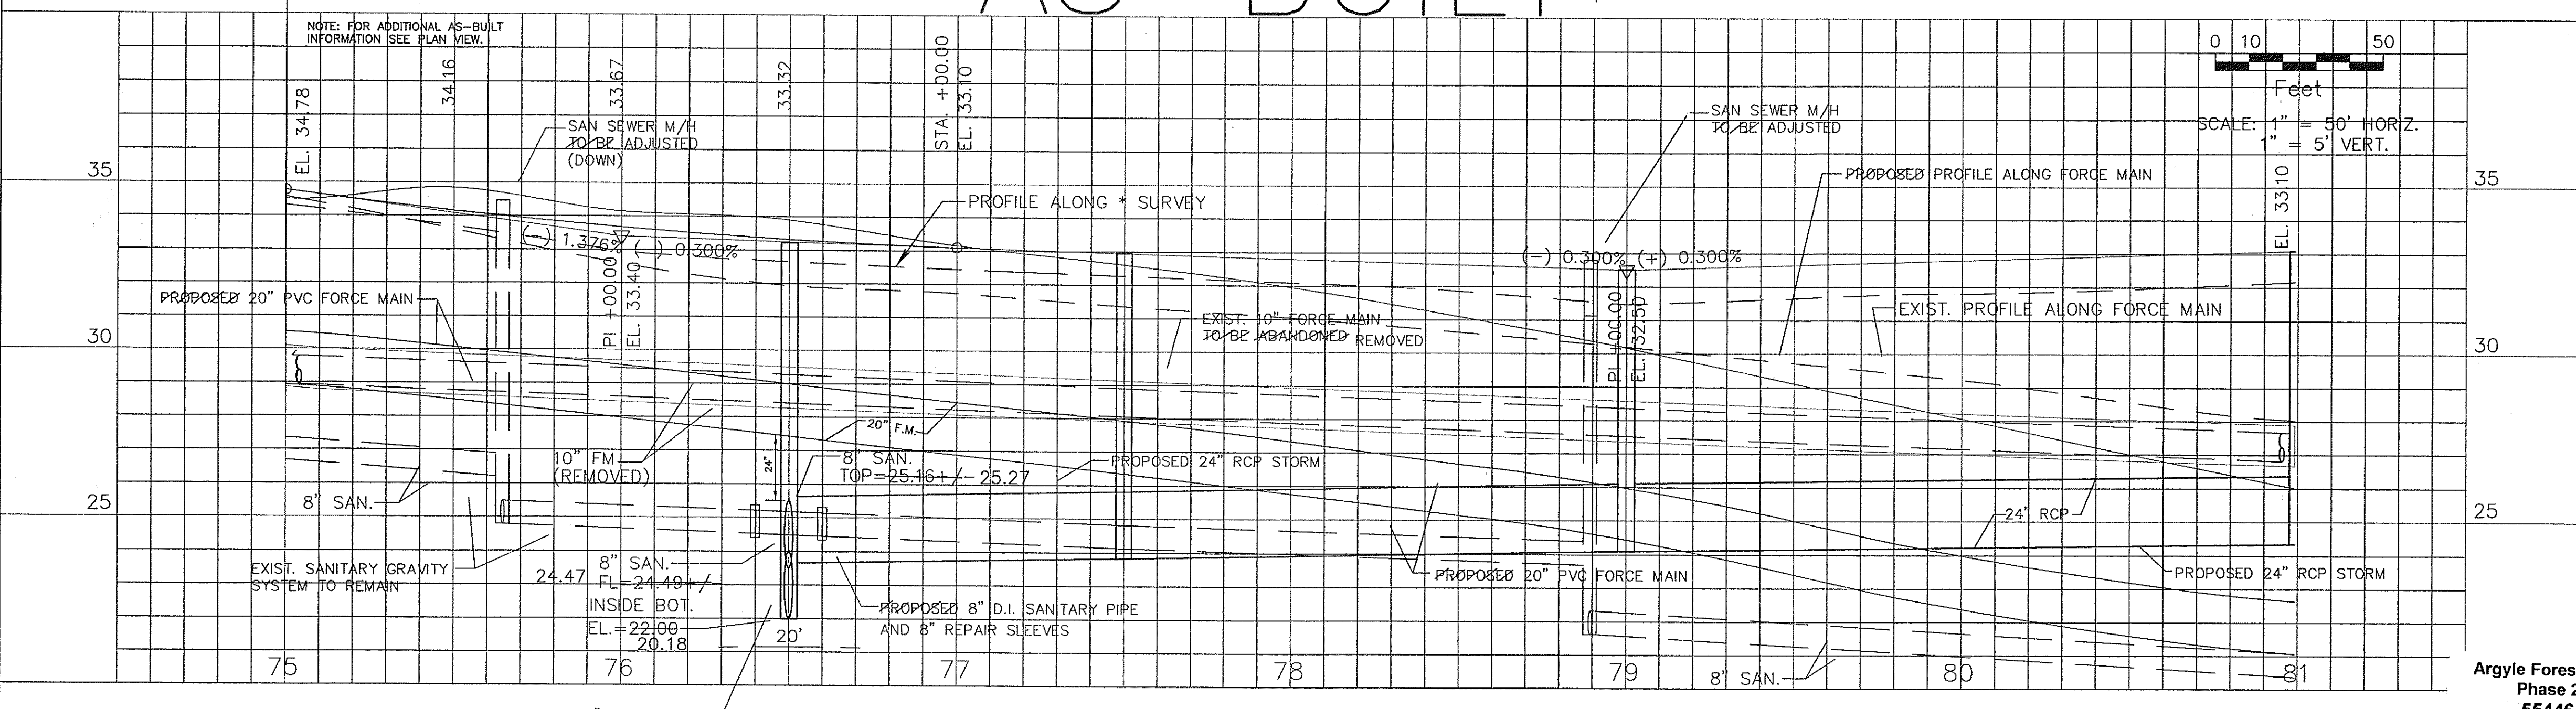


REVISIONS			SURVEY DATA		BOOK No.		PCS.		DESIGNER		PROJECT No.		WATER AND SEWER		SHEET No.	
No.	BY	DATE				BY	DATE			H.F.B.	W-04321015			18		
1										C.B.H.				OF	34	
2										SEPT. 2005	DATE	SEPT. 2005				
3										C.E.C.	SCALE: 1" = 30' H., 1" = 5' V.					
4										SEPT. 2005						
5																
6																
PROJECT No. W-04321015
DATE SEPT. 2005
SCALE: 1" = 30' H., 1" = 5' V.

WATER AND SEWER
ADJUSTMENT PLANS

SHEET No. 18
OF 34
DRAWING No.

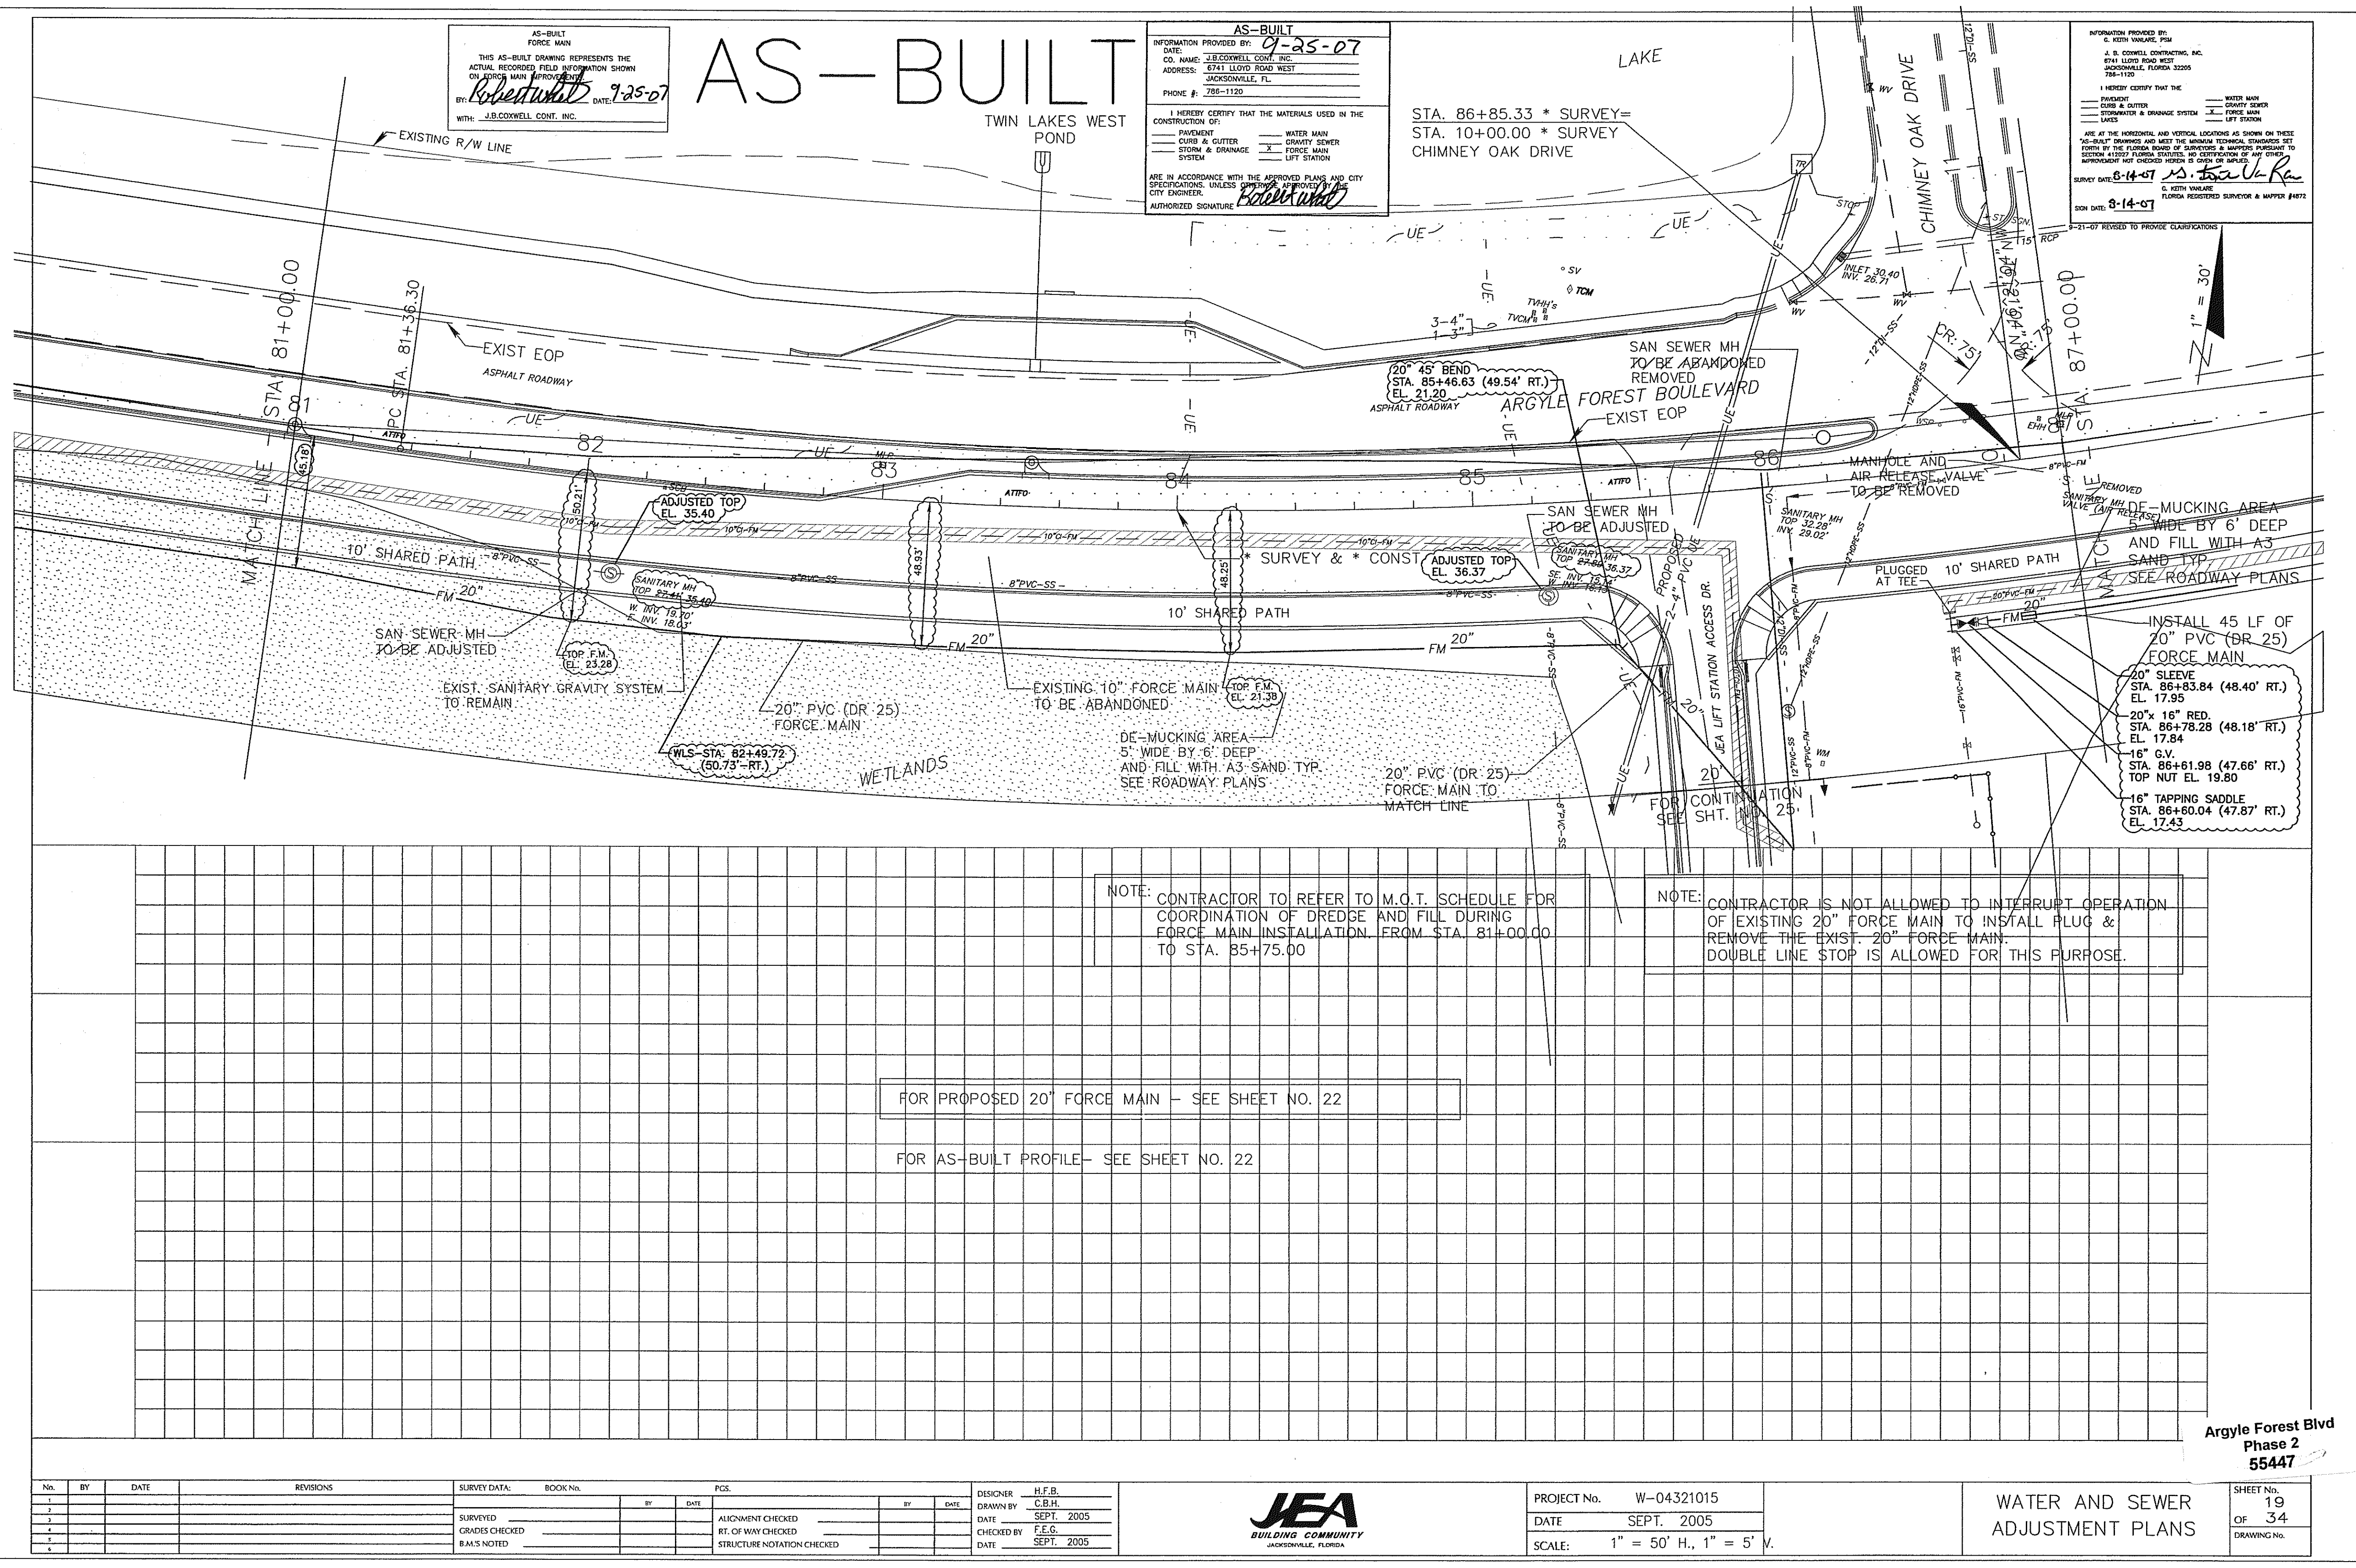

No.		BY	DATE	REVISIONS		SURVEY DATA		BOOK No.	BY	DATE	PCS.	DESIGNER	H.F.B.
1													
2													
3													
4													
5													
6													

DESIGNED BY		H.F.B.
DRAWN BY		C.B.H.
DATE		SEPT. 2005
CHECKED BY		F.E.G.
DATE		SEPT. 2005

SURVEYED		BOOK No.	BY	DATE
GRADES CHECKED				
B.M.'S NOTED				
ALIGNMENT CHECKED				
RT. OF WAY CHECKED				
STRUCTURE NOTATION CHECKED				




PROJECT No. W-04321015
DATE SEPT. 2005
SCALE: 1" = 50' H., 1" = 5' V.

WATER AND SEWER
ADJUSTMENT PLANS

SHEET No. 19
OF 34
DRAWING No.

Argyle Forest Blvd
Phase 2
55447

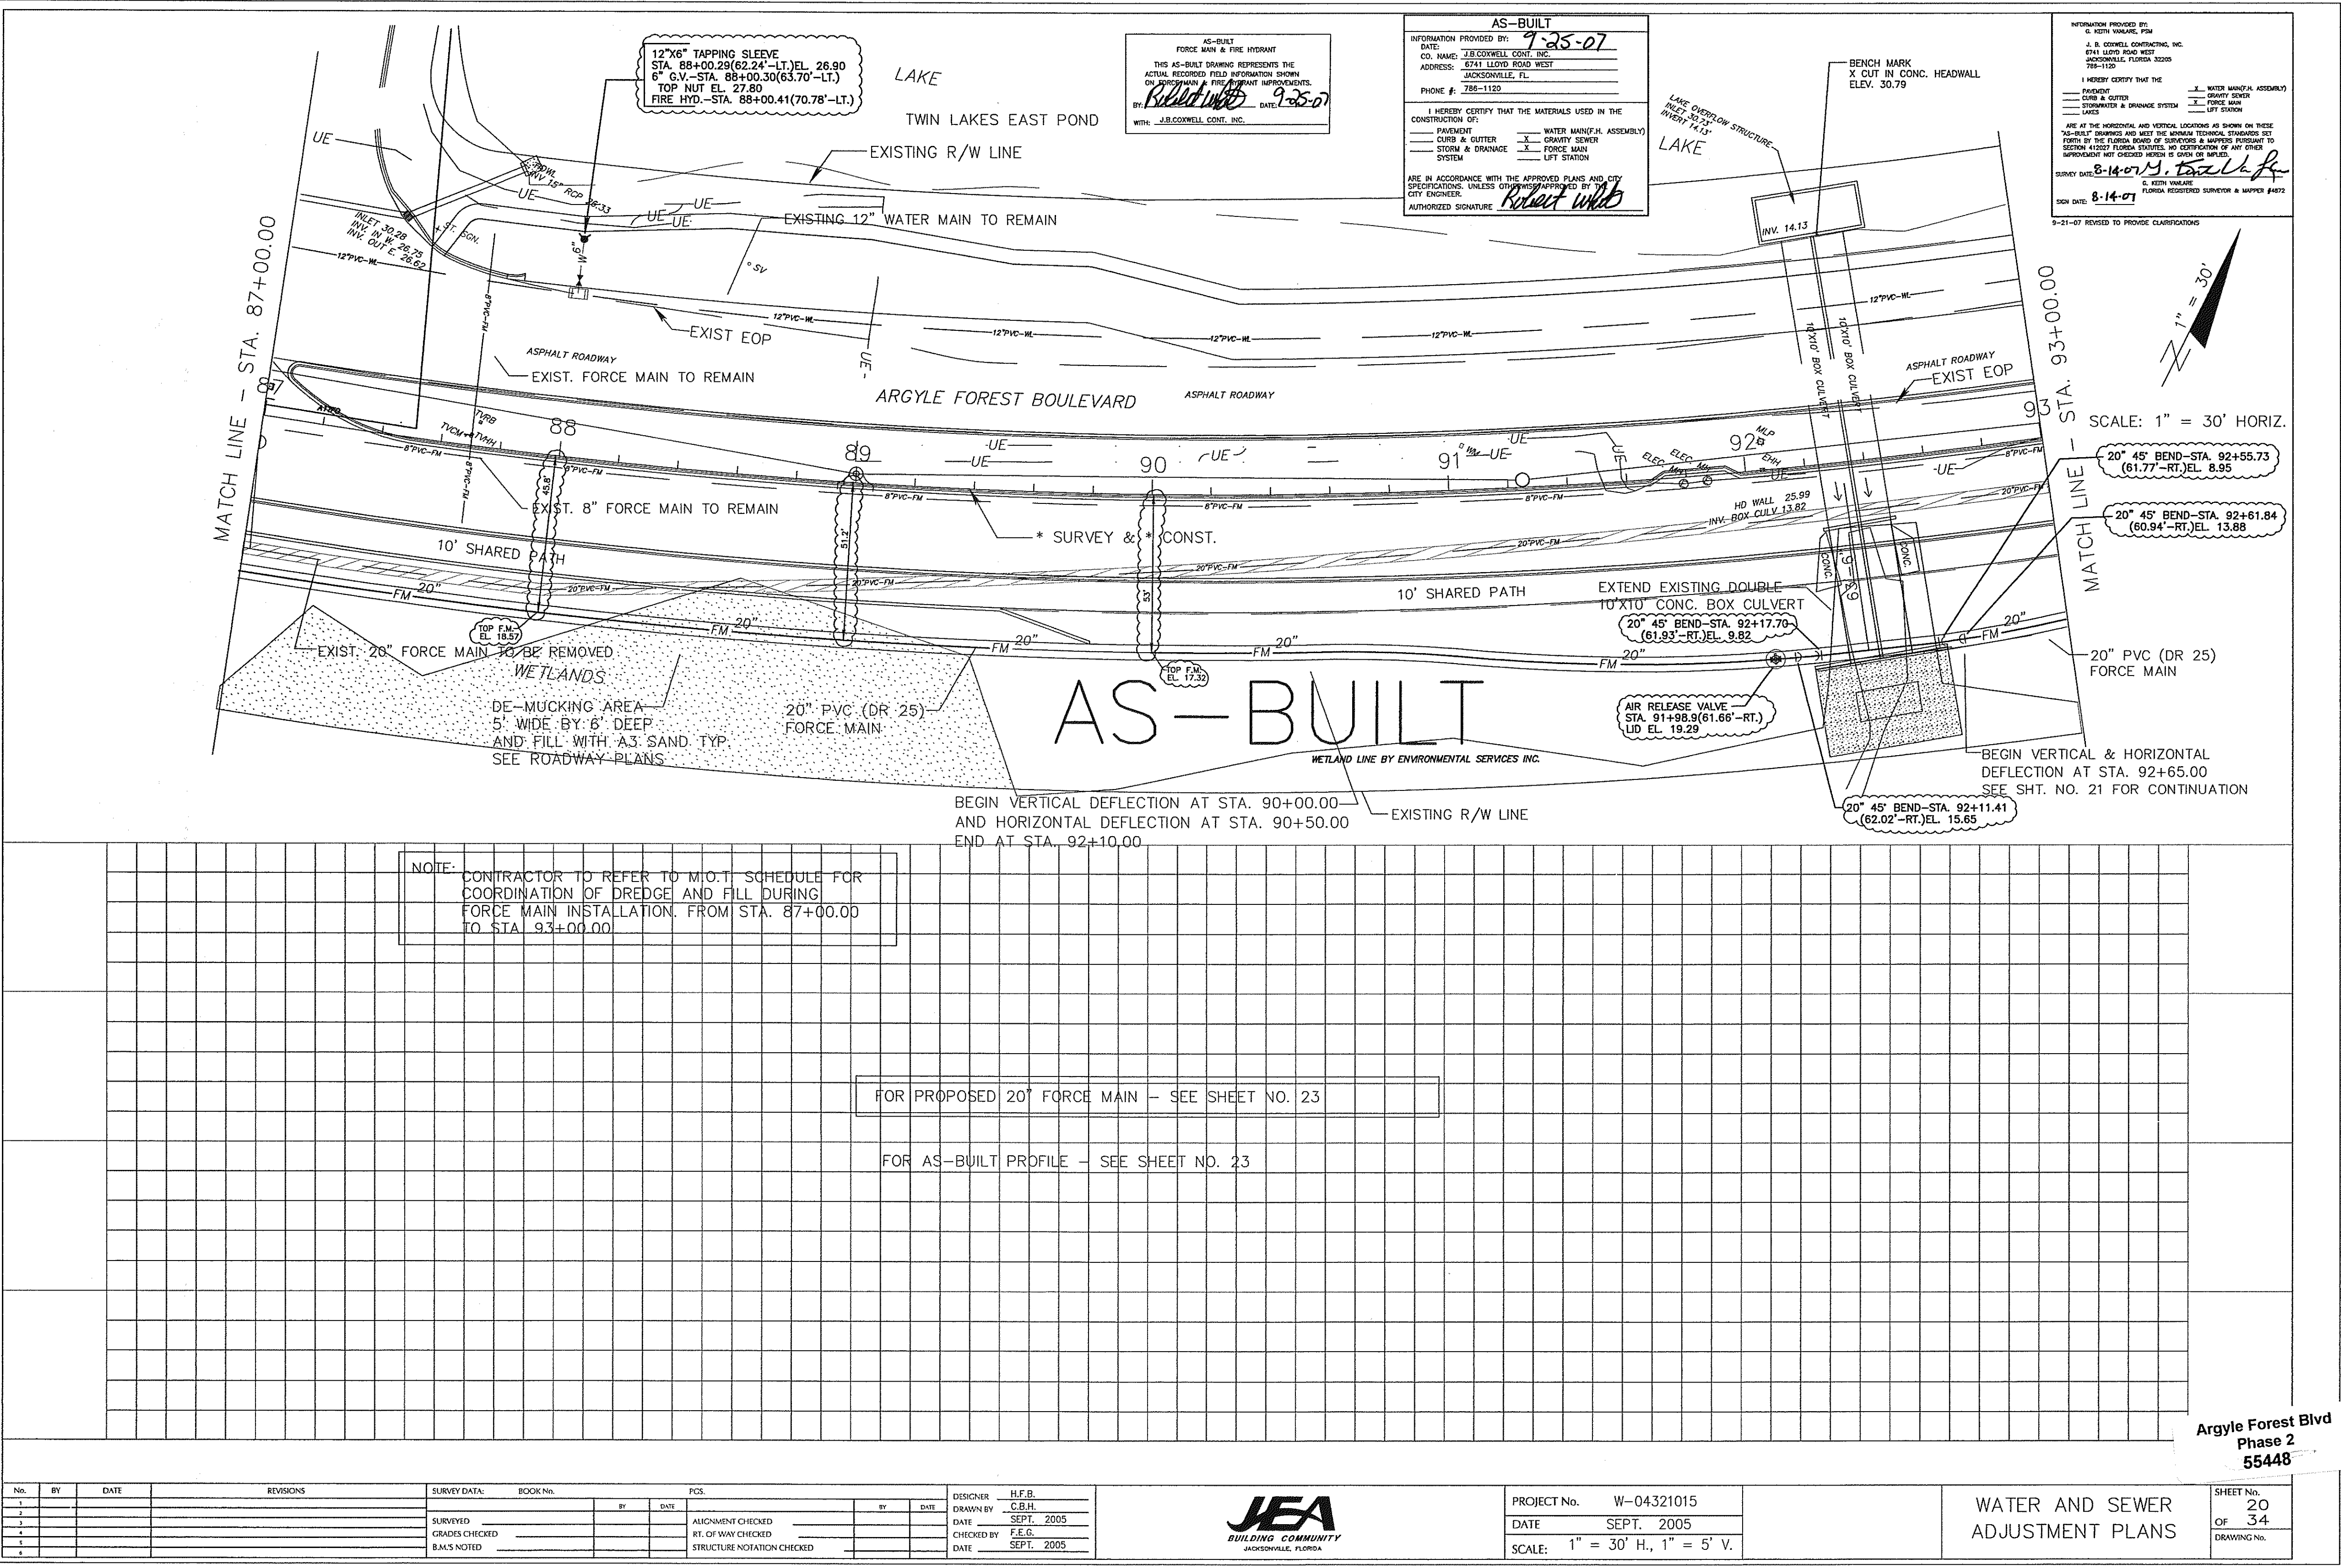

No.	BY	DATE	REVISIONS	SURVEY DATA	BOOK No.	PCS.	DESIGNER	H.F.B.
1								
2								
3								
4								
5								

BY	DATE	BY	DATE	BY	DATE	BY	DATE




PROJECT No. W-04321015
DATE SEPT. 2005
SCALE: 1" = 30' H., 1" = 5' V.

WATER AND SEWER
ADJUSTMENT PLANS

SHEET No. 20
OF 34
DRAWING No.

Argyle Forest Blvd
Phase 2
55448

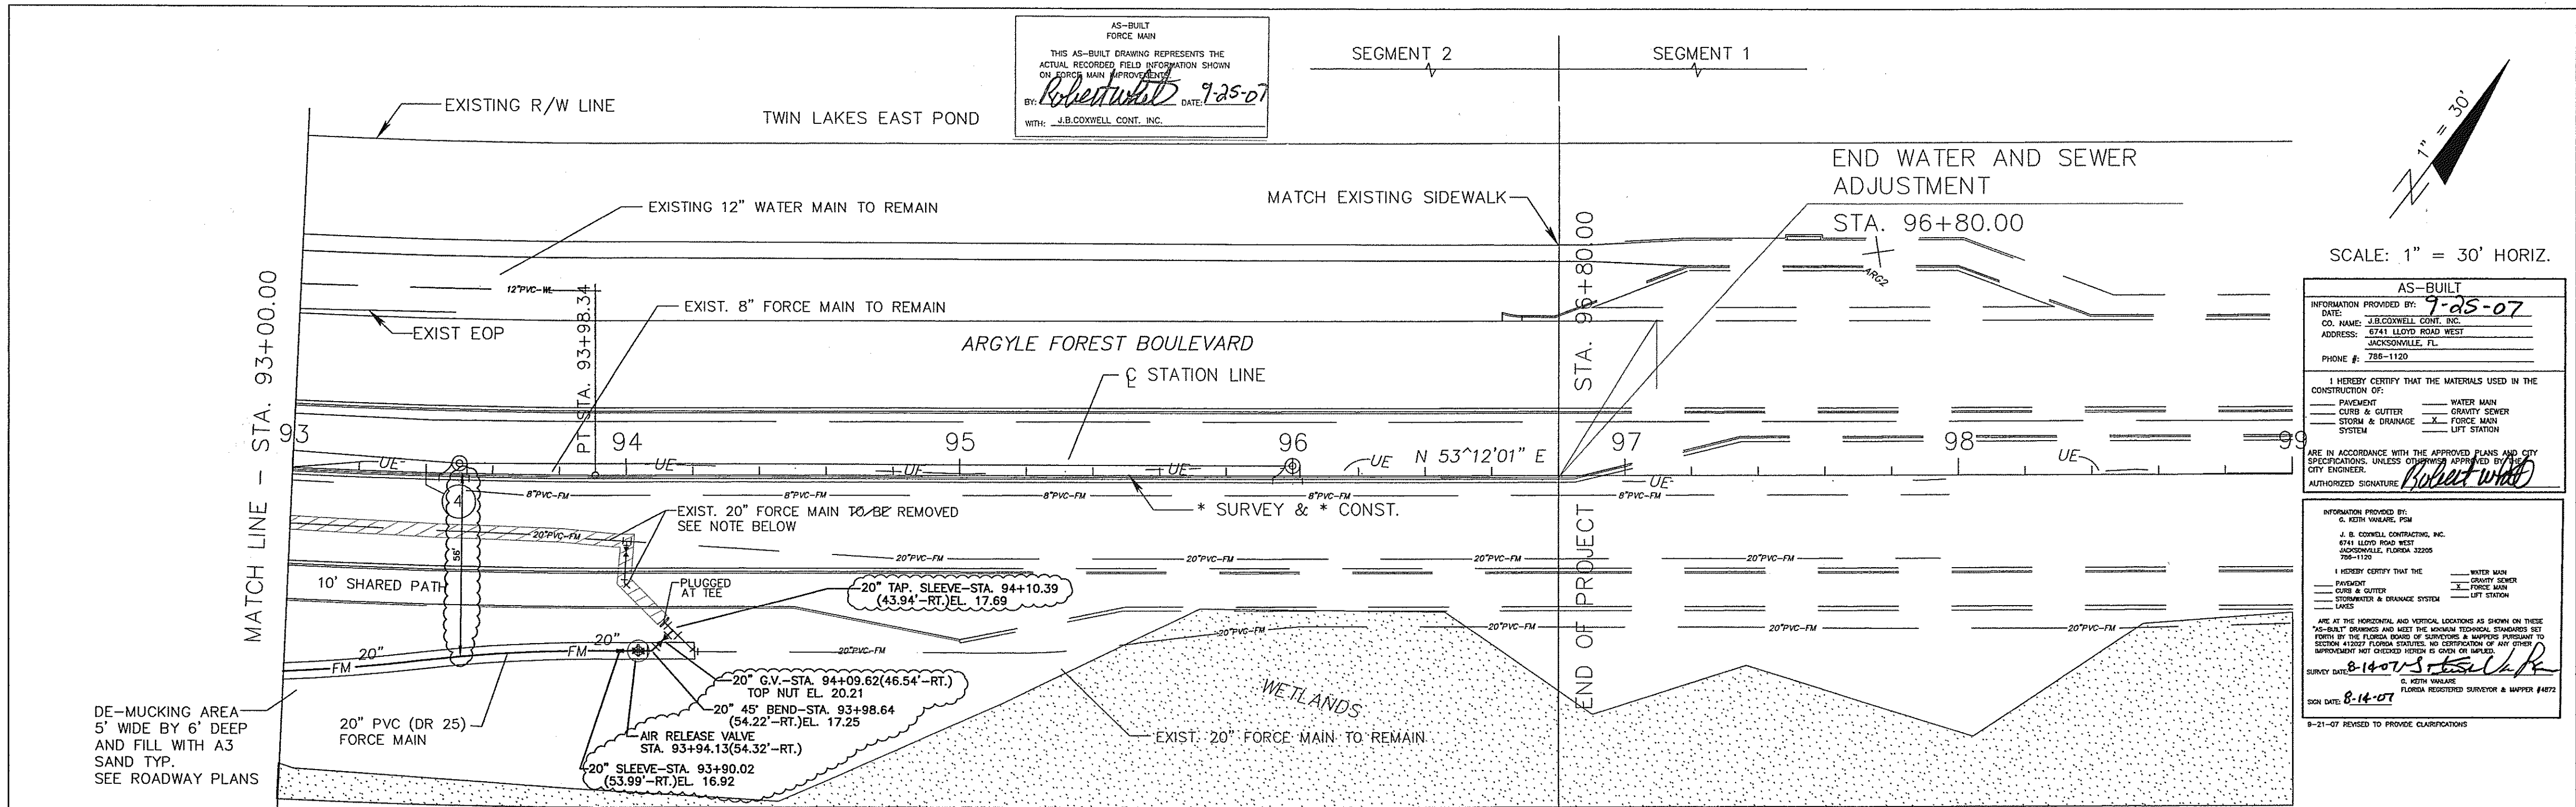

AS-BUILT

NOTE: CONTRACTOR IS NOT ALLOWED TO INTERRUPT OPERATION OF EXISTING 20" FORCE MAIN TO INSTALL PLUG & REMOVE THE EXIST. 20" FORCE MAIN. DOUBLE LINE STOP IS ALLOWED FOR THIS PURPOSE.

NOTE: CONTRACTOR TO REFER TO M.O.T. SCHEDULE FOR COORDINATION OF DEEDS AND FILL DURING FORCE MAIN INSTALLATION. FROM STA. 93+00.00 TO STA. 94+20.00.

FOR PROPOSED 20" FORCE MAIN - SEE SHEET NO. 24

FOR AS-BUILT PROFILE - SEE SHEET NO. 24

No.	BY	DATE	REVISIONS	SURVEY DATA	BOOK No.	BY	DATE	PCB	DESIGNER	H.F.B.
1										
2										
3										
4										
5										

SURVEYED	GRADES CHECKED	B.M.'S NOTED	ALIGNMENT CHECKED	RT. OF WAY CHECKED	STRUCTURE NOTATION CHECKED	DATE	SEPT. 2005
----------	----------------	--------------	-------------------	--------------------	----------------------------	------	------------



PROJECT No. W-04321015
DATE SEPT. 2005
SCALE: 1" = 30' H., 1" = 5' V.

WATER AND SEWER
ADJUSTMENT PLANS

SHEET No. 21
OF 34
DRAWING No.

Argyle Forest Blvd
Phase 2
55449

AS-BUILT


NOTE: FOR AS-BUILT INFORMATION SEE SHEET NO. 19

FOR PLAN - SEE SHEET NO. 19

AS-BUILT
INFORMATION PROVIDED BY: 9-25-07
DATE:
CO. NAME: J.B. CORWELL CONT. INC.
ADDRESS: 6741 LLOYD ROAD WEST
JACKSONVILLE, FL.
PHONE #: 786-1120
I HEREBY CERTIFY THAT THE MATERIALS USED IN THE CONSTRUCTION OF:
— PAVEMENT — WATER MAIN
— CURB & GUTTER — SANITARY GRAVITY SYSTEM
— STORM & DRAINAGE — FORCE MAIN
— SYSTEM — LIFT STATION
ARE IN ACCORDANCE WITH THE APPROVED PLANS AND CITY SPECIFICATIONS, UNLESS OTHERWISE APPROVED BY THE CITY ENGINEER.
AUTHORIZED SIGNATURE: Robert W. Bell

INFORMATION PROVIDED BY:
G. KETH WALKER, F.S.M.
J. B. CORWELL CONTRACTING, INC.
6741 LLOYD ROAD WEST
JACKSONVILLE, FLORIDA 32205
786-1120
I HEREBY CERTIFY THAT THE:
— PAVEMENT — WATER MAIN
— CURB & GUTTER — SANITARY GRAVITY SYSTEM
— STORMWATER & DRAINAGE SYSTEM — FORCE MAIN
— LAKES — LIFT STATION
ARE AT THE HORIZONTAL AND VERTICAL LOCATIONS AS SHOWN ON THESE "AS-BUILT" DRAWINGS AND MEET THE MINIMUM TECHNICAL STANDARDS SET FORTH BY THE FLORIDA BOARD OF SURVEYORS & MAPPERS PURSUANT TO SECTION 410227, FLORIDA STATUTES. NO CERTIFICATION OF ANY OTHER IMPROVEMENT NOT CHECKED HEREIN IS GIVEN OR IMPLIED.
SIGN DATE: 8-14-07 Robert W. Bell
SURVEY DATE: 8-14-07 G. KETH WALKER
FLORIDA REGISTERED SURVEYOR & MAPPER #4872
8-21-07 REVISED TO PROVIDE CLASSIFICATIONS

SCALE: 1" = 30' HORIZ.
1" = 5' VERT.

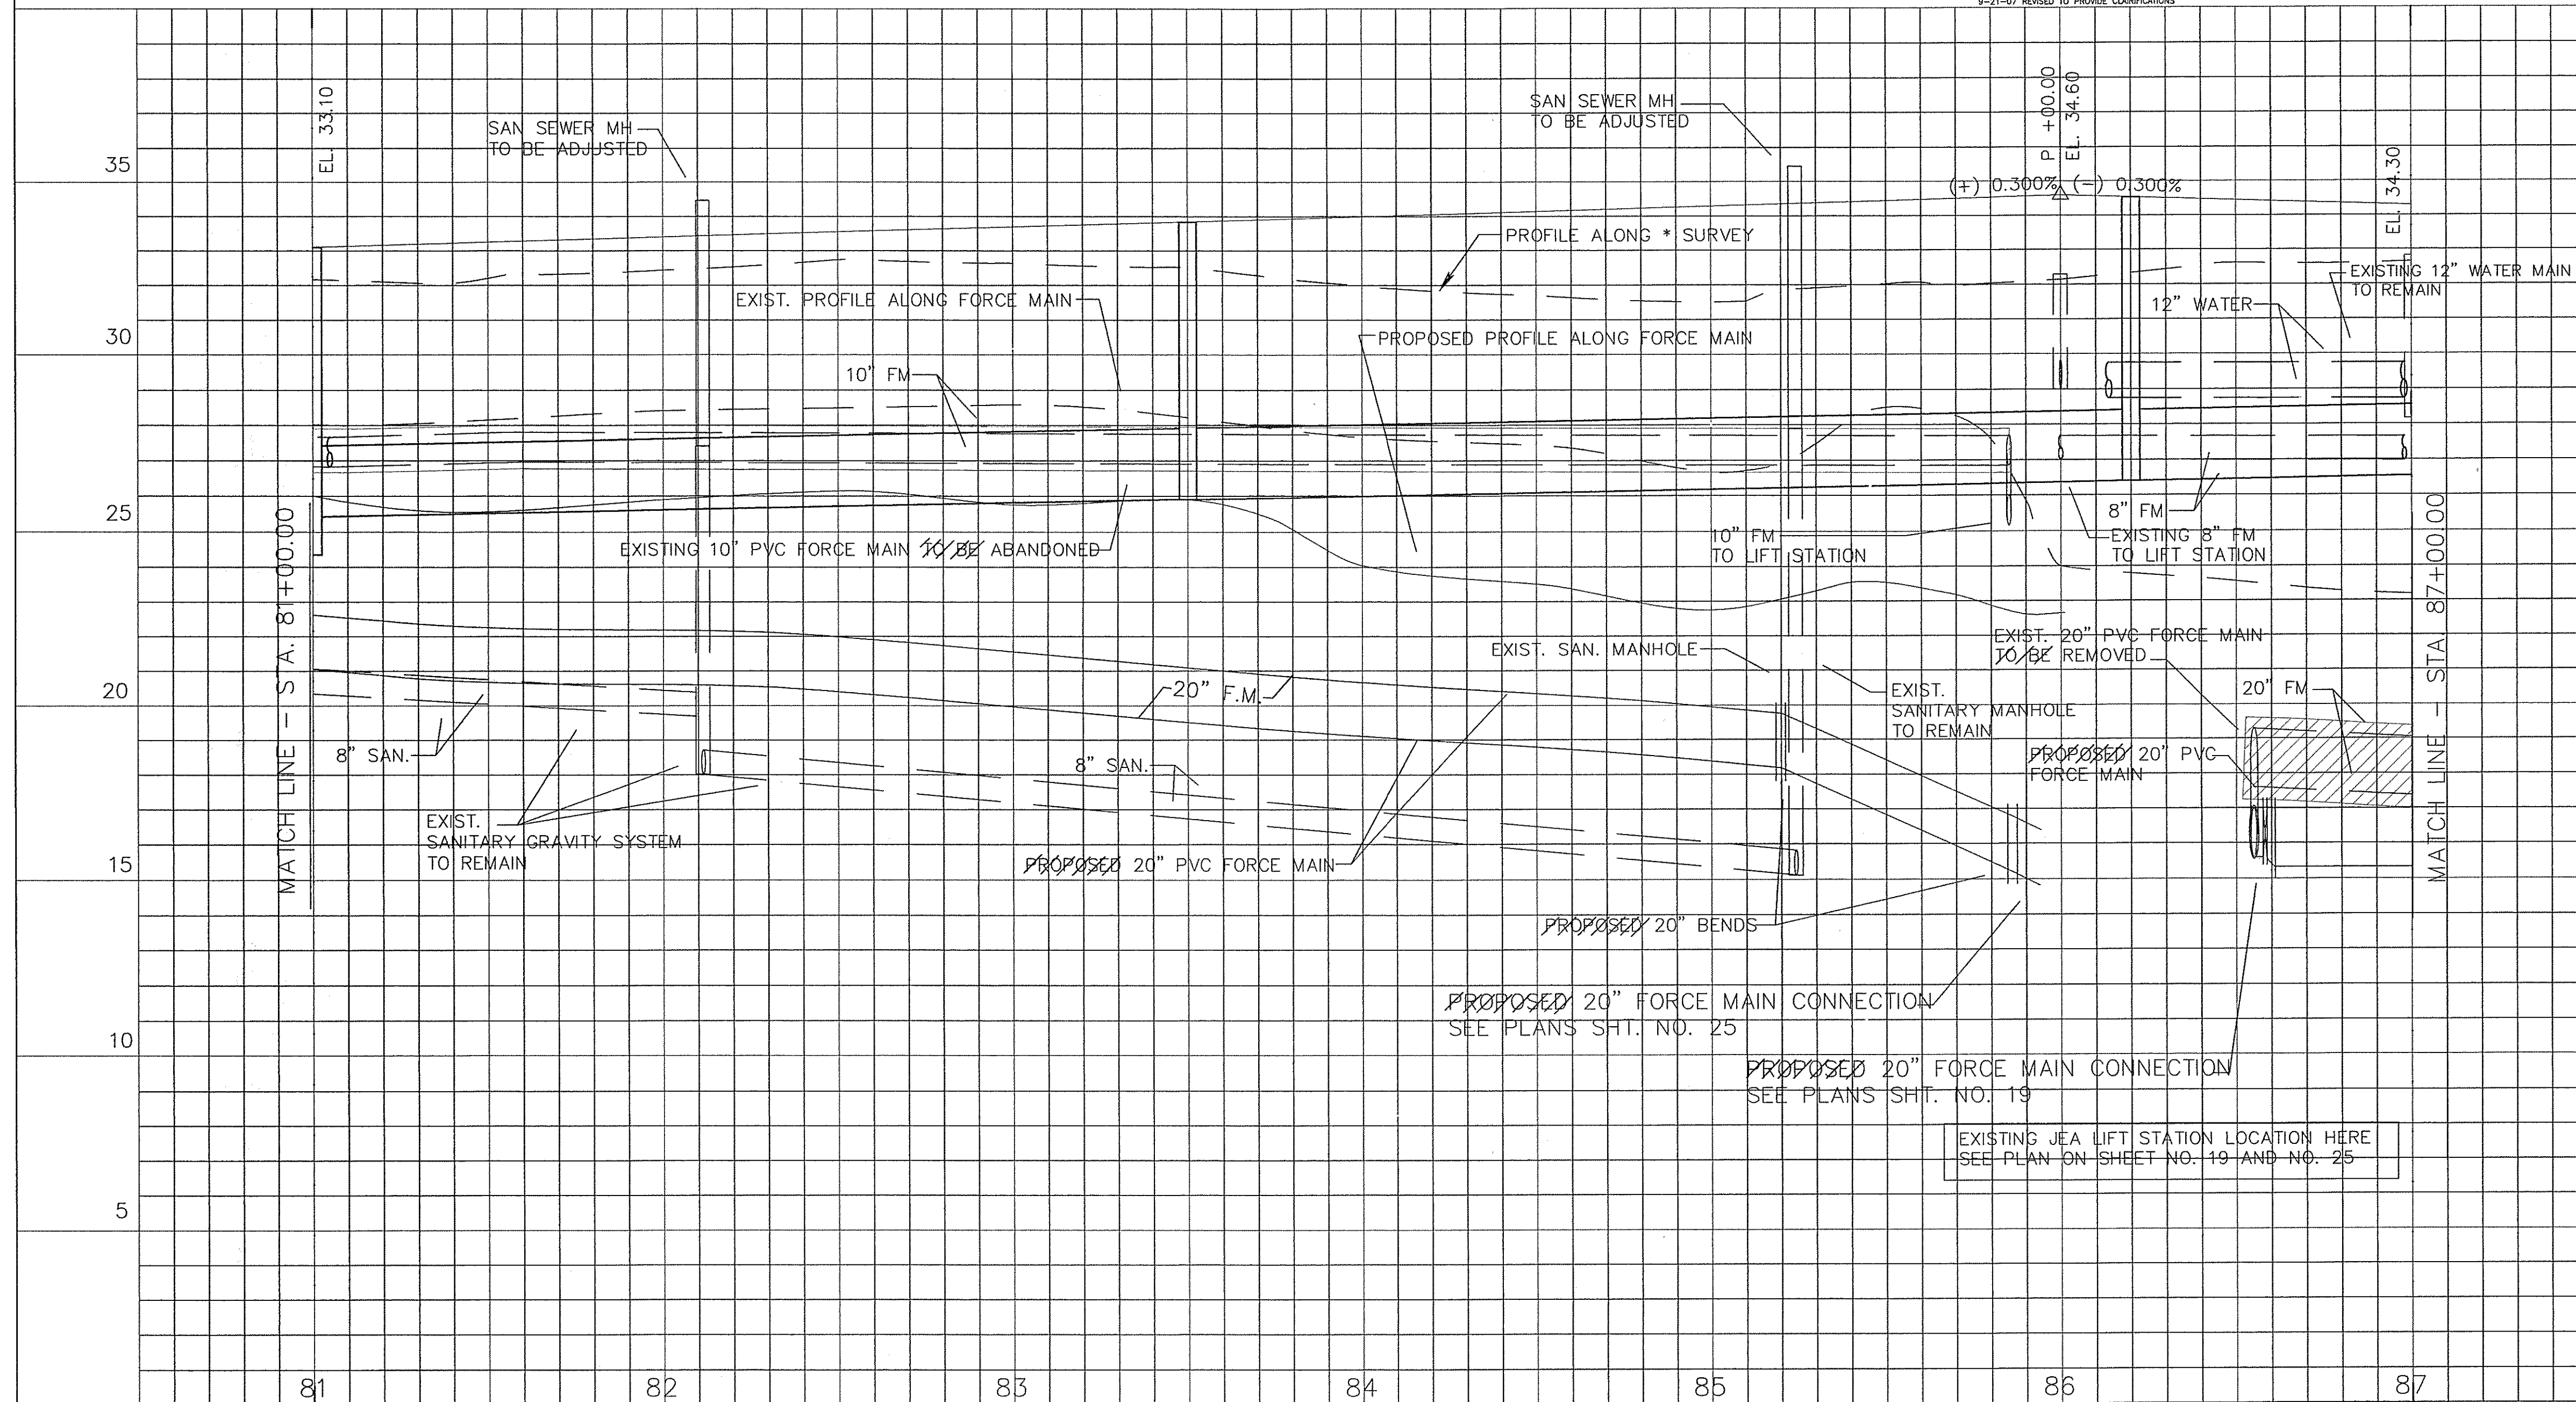

Argyle Forest Blvd
Phase 2
55450

No.	BY	DATE	REVISIONS	SURVEY DATA	BOOK No.	PCS.	BY	DATE	DESIGNER	H.E.B.
1										
2										
3										
4										
5										
6										

SURVEYED		BY	DATE	ALIGNMENT CHECKED		BY	DATE	CHECKED BY	F.E.G.	DATE	SEPT. 2005
GRADES CHECKED				RT. OF WAY CHECKED							
B.M.'S CHECKED				STRUCTURE NOTATION CHECKED							



PROJECT No. W-04321015
DATE SEPT. 2005
SCALE: 1" = 30' H., 1" = 5' V.

WATER AND SEWER
ADJUSTMENT PLANS

SHEET No. 22
OF 34
DRAWING No.

AS-BUILT


NOTE: FOR AS-BUILT INFORMATION SEE SHEET NO. 20

FOR PLAN - SEE SHEET NO. 20

AS-BUILT
INFORMATION PROVIDED BY: 9-25-07
DATE: 9-25-07
CO. NAME: J.B. CONWELL CONTRACTING, INC.
ADDRESS: 8741 LLOYD ROAD WEST JACKSONVILLE, FL 32205
PHONE #: 786-1120
I HEREBY CERTIFY THAT THE MATERIALS USED IN THE CONSTRUCTION OF:
PAVEMENT WATER MAIN
CURB & GUTTER SANITARY GRAVITY SYSTEM
STORM & DRAINAGE FORCE MAIN
SYSTEM LIFT STATION
ARE IN ACCORDANCE WITH THE APPROVED PLANS AND CITY SPECIFICATIONS, UNLESS OTHERWISE NOTED.
AUTHORIZED SIGNATURE: Robert White

INFORMATION PROVIDED BY:
G. JETH VAUGHAN, P.E.
J. B. CONWELL CONTRACTING, INC.
8741 LLOYD ROAD WEST JACKSONVILLE, FL 32205
786-1120
I HEREBY CERTIFY THAT THE:
PAVEMENT WATER MAIN
CURB & GUTTER SANITARY GRAVITY SYSTEM
STORMWATER & DRAINAGE SYSTEM FORCE MAIN
LINES LIFT STATION
ARE AT THE HORIZONTAL AND VERTICAL LOCATIONS AS SHOWN ON THESE AS-BUILT DRAWINGS AND MEET THE MINIMUM TECHNICAL STANDARDS SET FORTH BY THE FLORIDA BOARD OF PROFESSIONAL ENGINEERS, PURSUANT TO SECTION 460.05, F.S. (FLORIDA REGISTERED SURVEYOR & MAPPER #4072)
SIGN DATE: 8-14-07
SURVEY DATE: 8-14-07
9-21-07 REVISED TO PROVIDE CLARIFICATIONS

SCALE: 1" = 30' HORIZ.
1" = 5' VERT.

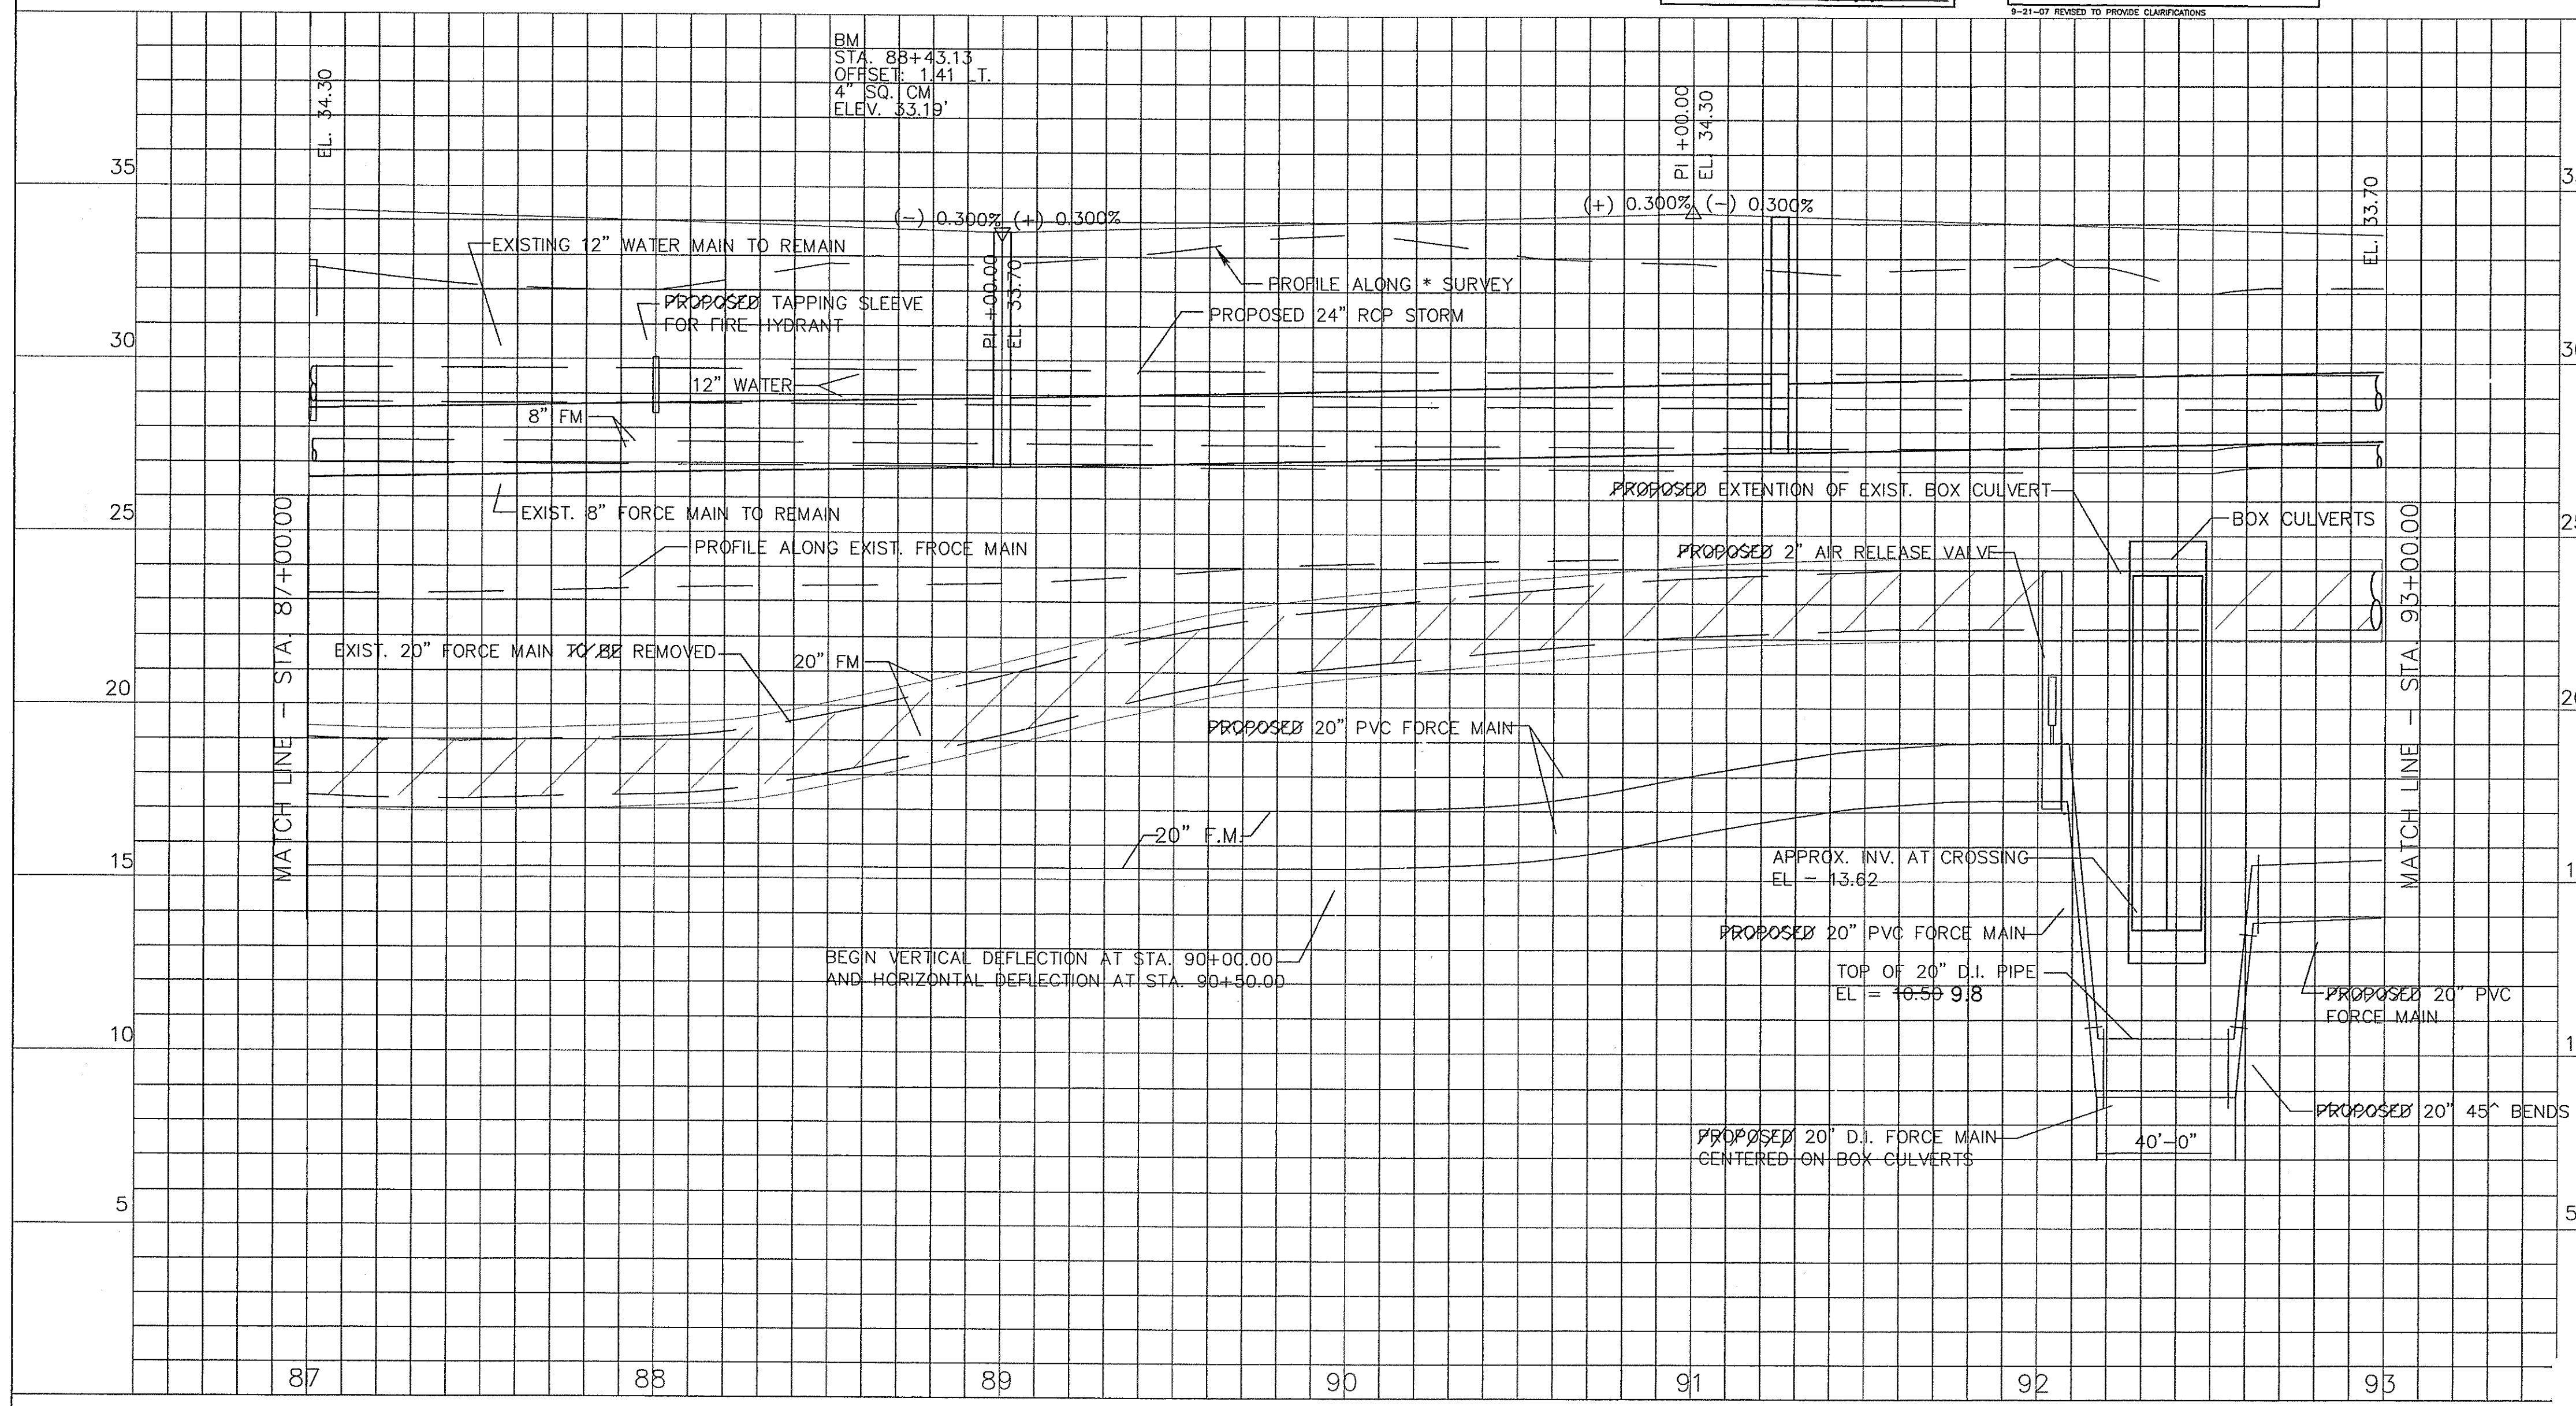

No.	BY	DATE	REVISIONS	SURVEY DATA:	BOOK No.	DATE	DESIGNER	H.F.B.
1								
2								
3								
4								
5								

BY	DATE	DESIGNER	H.F.B.

BY	DATE	DESIGNER	H.F.B.



PROJECT No. W-04321015
DATE SEPT. 2005
SCALE: 1" = 30' H., 1" = 5' V.

WATER AND SEWER
ADJUSTMENT PLANS

SHEET No. 23
OF 34
DRAWING No.

Argyle Forest Blvd
Phase 2
55451

AS-BUILT


NOTE: FOR AS-BUILT INFORMATION SEE SHEET NO. 21

FOR PLAN - SEE SHEET NO. 21

AS-BUILT
INFORMATION PROVIDED BY: **9-25-07**
DATE:
CO. NAME: **J.B. CORVELL CONTRACTING, INC.**
ADDRESS: **2741 LLOYD ROAD WEST**
JACKSONVILLE, FL.
PHONE #: **785-1129**
I HEREBY CERTIFY THAT THE MATERIALS USED IN THE CONSTRUCTION OF:
PAVEMENT: ☐ WATER MAIN
CURB & GUTTER: ☐ SANITARY GRAVITY SYSTEM
STORM & DRAINAGE: ☒ FORCE MAIN
SYSTEM: ☐ LIFT STATION
ARE IN ACCORDANCE WITH THE APPROVED PLANS AND ALL SPECIFICATIONS, UNLESS OTHERWISE APPROVED BY THE CITY ENGINEER.
AUTHORIZED SIGNATURE: *[Signature]*

INFORMATION PROVIDED BY:
DATE: **9-14-07**
CO. NAME: **J.B. CORVELL CONTRACTING, INC.**
ADDRESS: **2741 LLOYD ROAD WEST**
JACKSONVILLE, FLORIDA 32205
328-1129
I HEREBY CERTIFY THAT THE:
PAVEMENT: ☐ WATER MAIN
CURB & GUTTER: ☐ SANITARY GRAVITY SYSTEM
STORM & DRAINAGE: ☒ FORCE MAIN
SYSTEM: ☐ LIFT STATION
ARE AT THE HORIZONTAL AND VERTICAL LOCATIONS AS SHOWN ON THESE "AS-BUILT" DRAWINGS AND MEET THE MINIMUM TECHNICAL STANDARDS SET FORTH BY THE FLORIDA BOARD OF SURVEYORS & MAPPERS PURSUANT TO SECTION 460.01, F.S. UNLESS, IN CERTAIN CASES, OF ANY OTHER APPROVEMENT HAS BEEN SPECIFICALLY NOTED TO THE CONTRARY.
SIGN DATE: **9-14-07**
SURVEY DATE: **9-14-07**
DATE: **9-14-07**
SURVEYOR: *[Signature]*
FLORIDA REGISTERED SURVEYOR & MAPPER #4072
9-21-07 REVISED TO PROVIDE CLARIFICATIONS

SCALE: 1" = 30' HORIZ.
1" = 5' VERT.

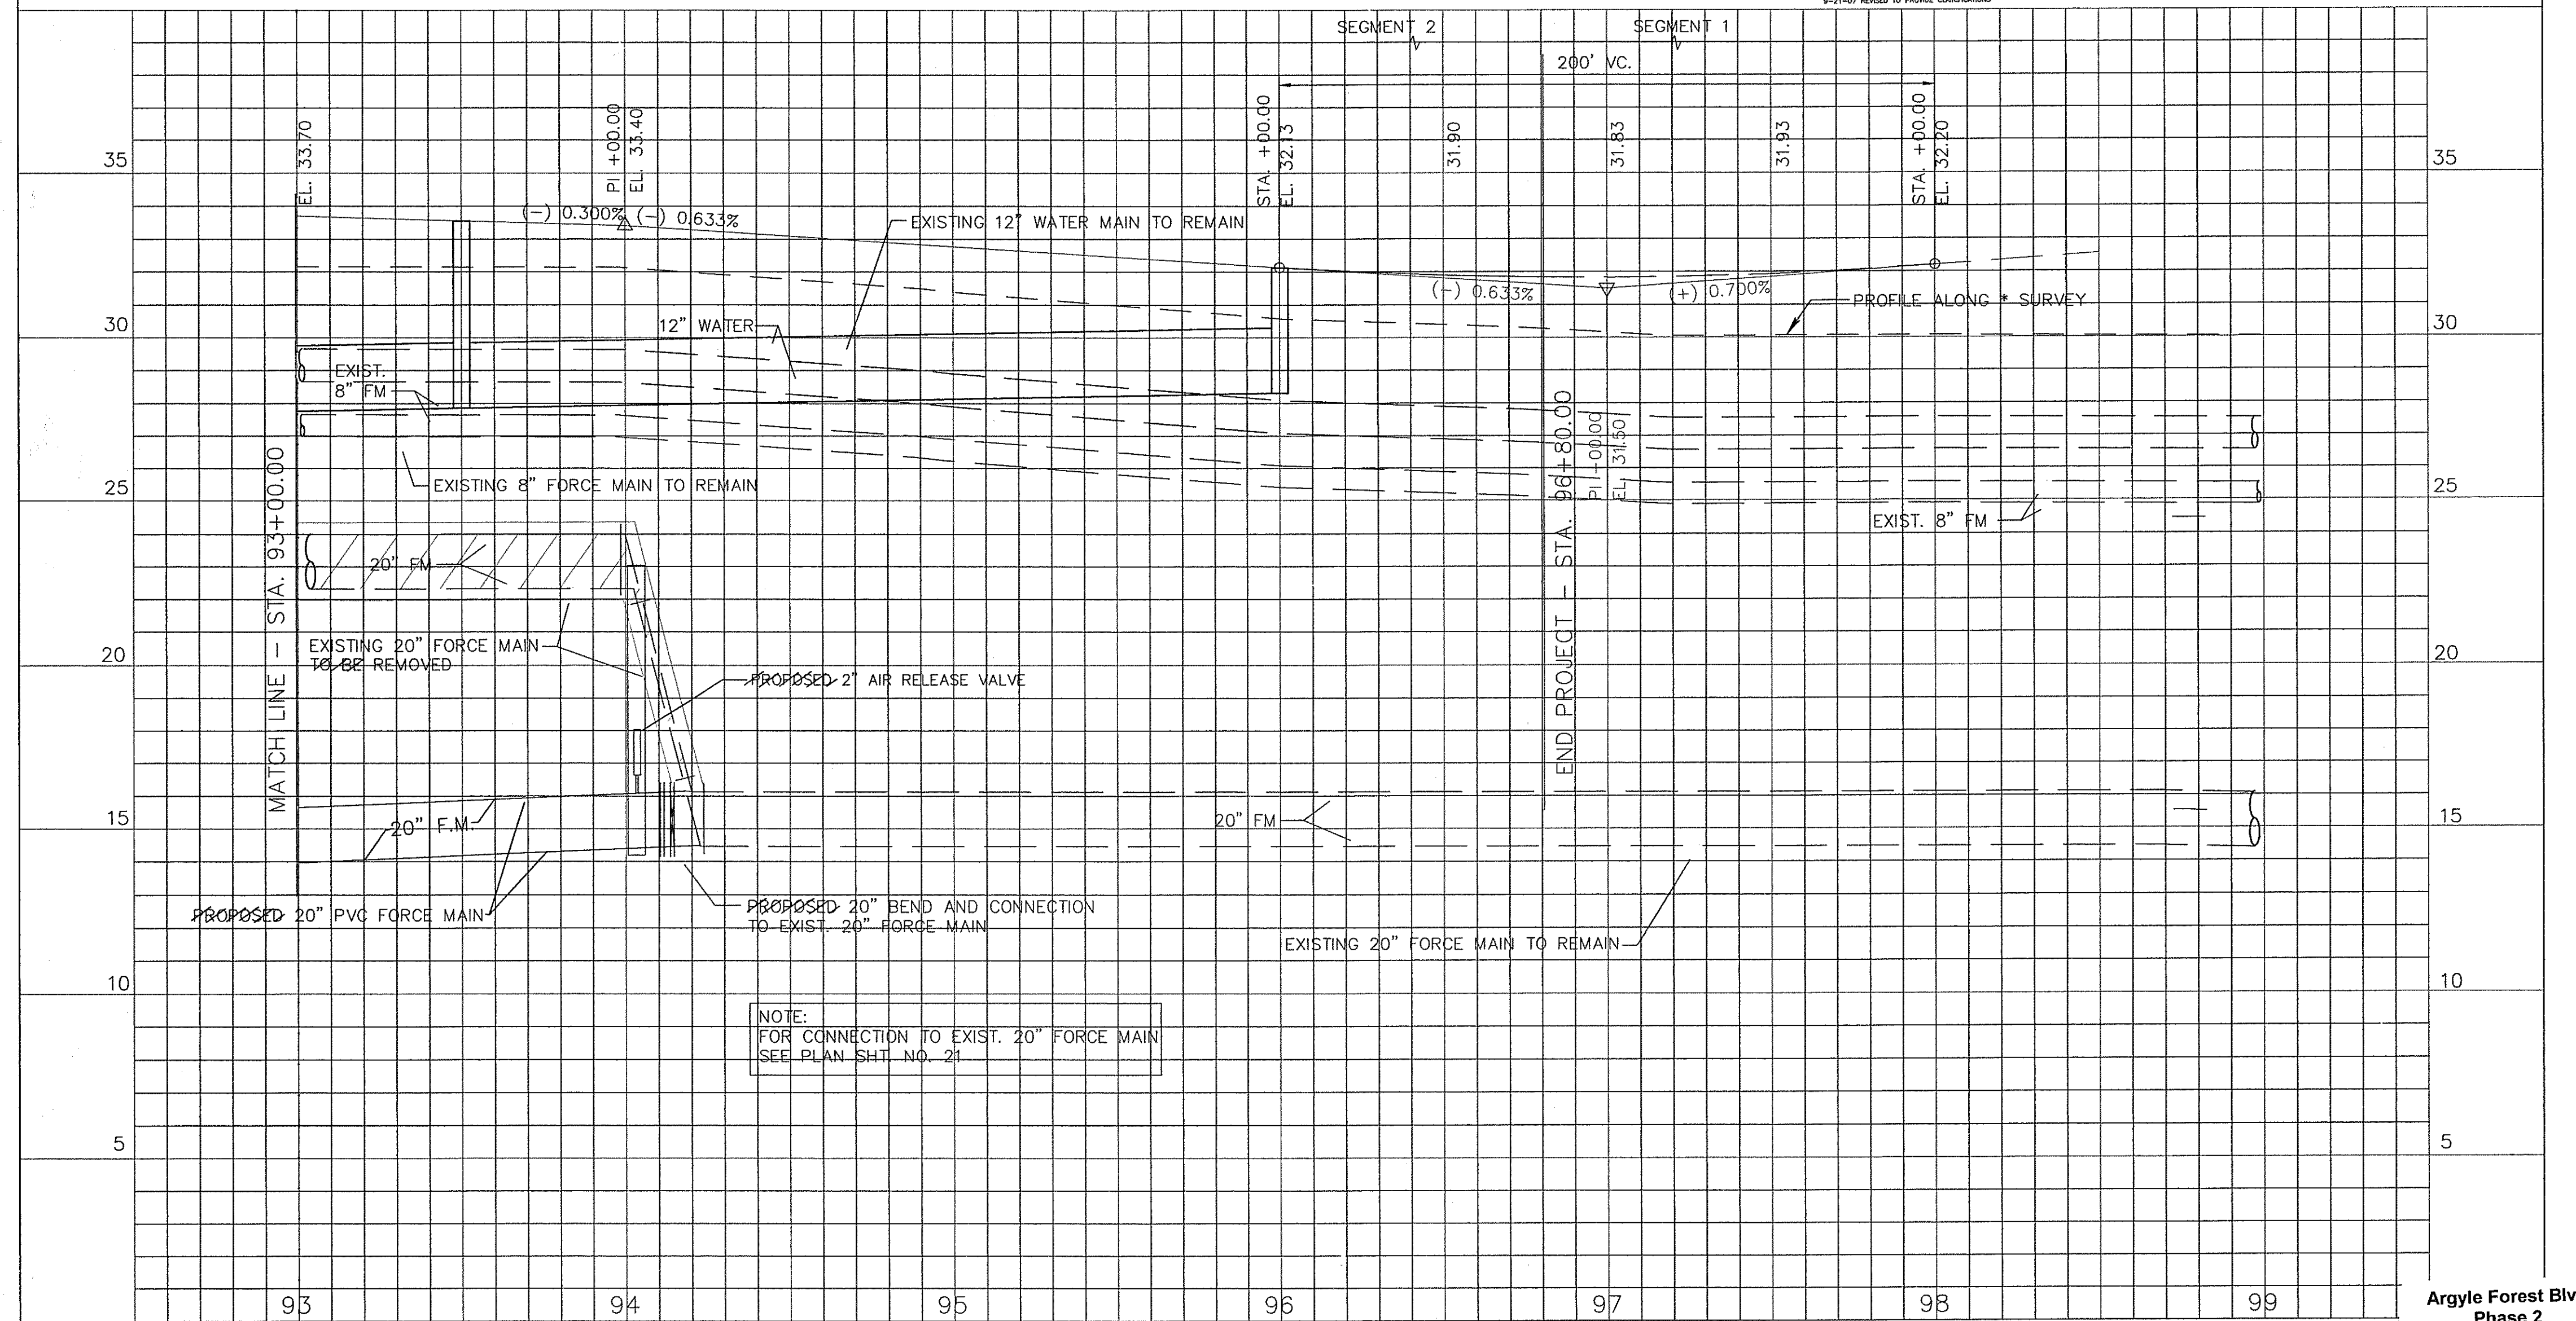

NOTE:
FOR CONNECTION TO EXIST. 20" FORCE MAIN
SEE PLAN SHEET NO. 21

No.	BY	DATE	REVISIONS	SURVEY DATA	BOOK No.	PCS.	DESIGNER	H.F.B.
1								
2								
3								
4								
5								
6								

SURVEYED	DATE	BY	DATE	DESIGNER	H.F.B.
GRADED/CHECKED	DATE	BY	DATE	DRAWN BY	C.B.H.
8/15/07	SEPT. 2005				
				CHECKED BY	F.E.C.
				DATE	SEPT. 2005



PROJECT No. W-04321015
DATE SEPT. 2005
SCALE: 1" = 30' H., 1" = 5' V.

WATER AND SEWER
ADJUSTMENT PLANS

SHEET No. 24
OF 34
DRAWING No.

Argyle Forest Blvd
Phase 2
55452

