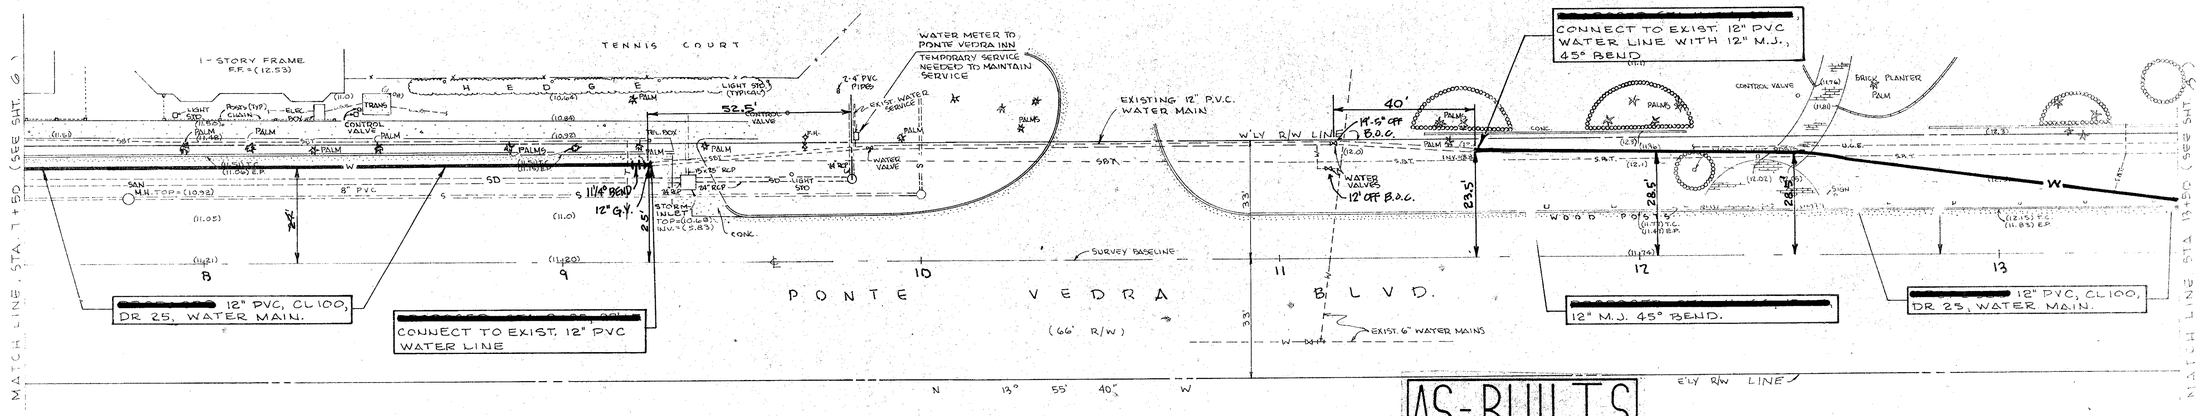

AS-BUILTS

As-Built information as shown on this drawing was furnished by the contractor who agrees it is an accurate representation of the actual field locations of the systems as constructed.

Contractor Name and Certificate No.

Signature Date

HORIZ. SCALE: 1" = 20'
VERT. SCALE: 1" = 5'

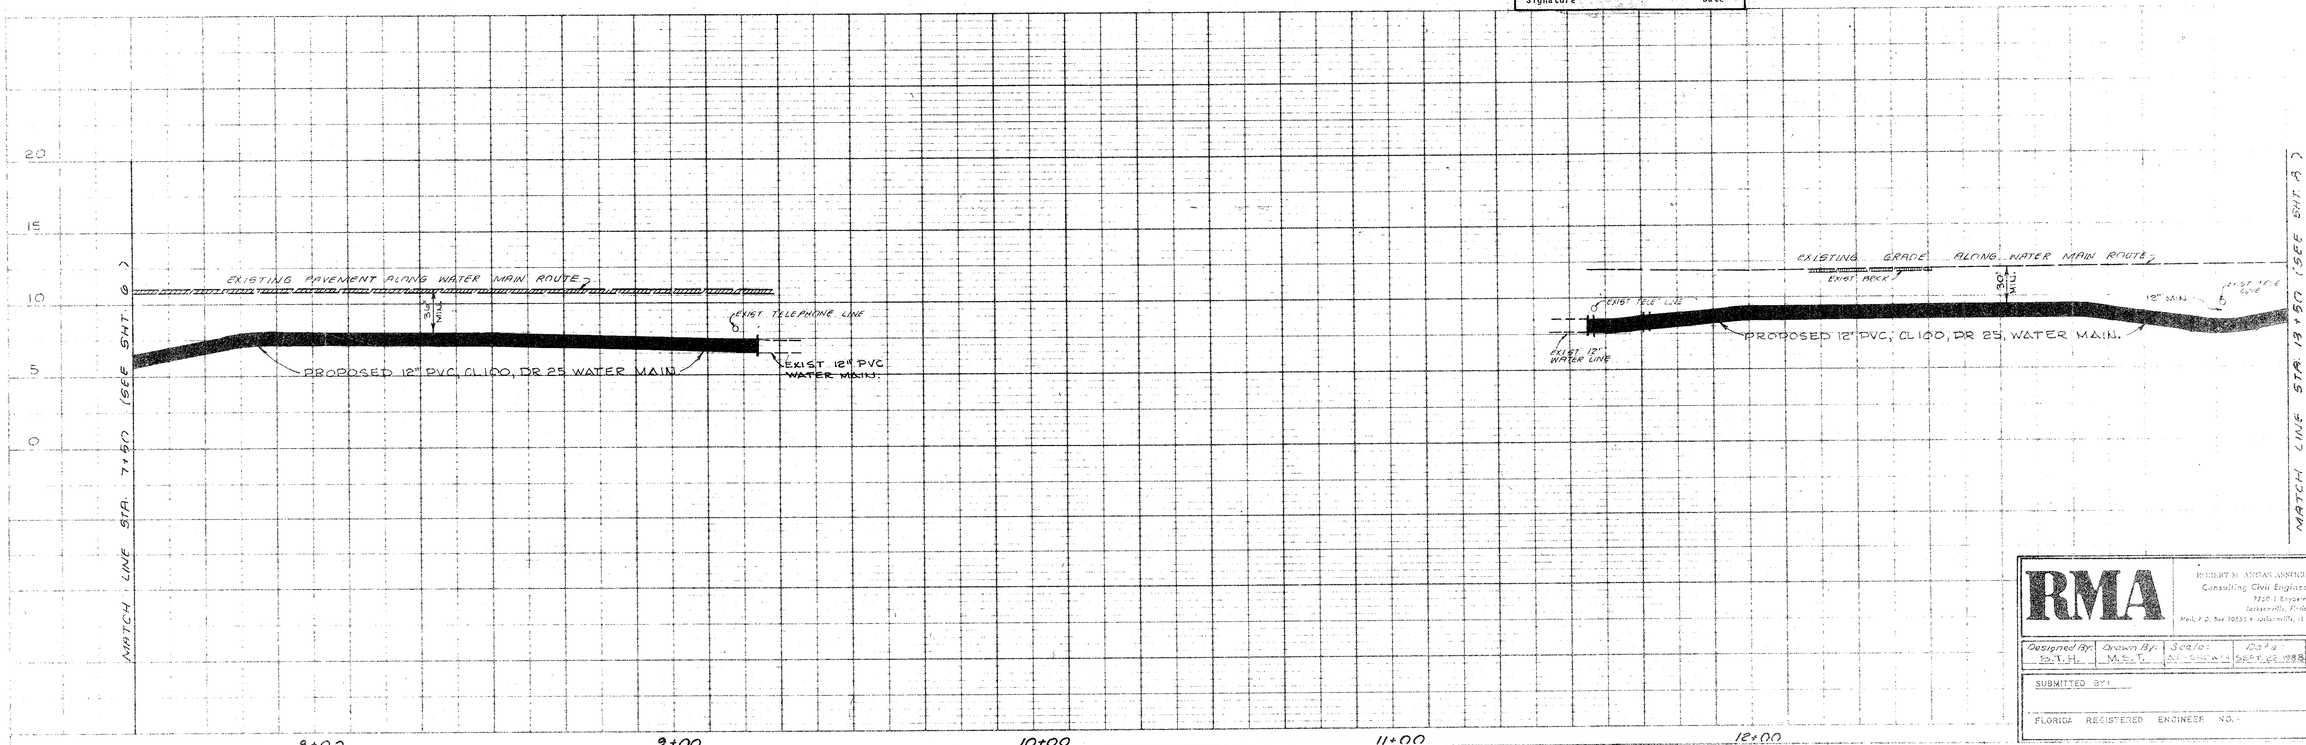

PLATE 1 PLAN-PROFILE O. P. R. & R. E. STANDARD
DIETZGEN CORPORATION
PRINTED IN U.S.A.

RMA
ROBERT M. ANGAS ASSOCIATES
Consulting Civil Engineers and Surveyors
7220 Bayberry Road
Jacksonville, Florida 32256
Mail: P.O. Box 10555 • Jacksonville, FL 32247-0555 • (904) 730-7550

Designed By:	Drawn By:	Scale:	Date:	Sheet 7 of 17 Sheets
D.T.H.	M.S.T.	As Shown	SEPT. 22, 1988	

SUBMITTED BY:

FLORIDA REGISTERED ENGINEER NO.

WATER IMPROVEMENTS - MIRANDA ROAD & PONTE VEDRA BOULEVARD

FB.: XT43, 61C

PLAN
PROFILE
NOTE BLOCK
NO.